


(AKRON SPENCER)

428.85

STATE RD #162

167.35 ±

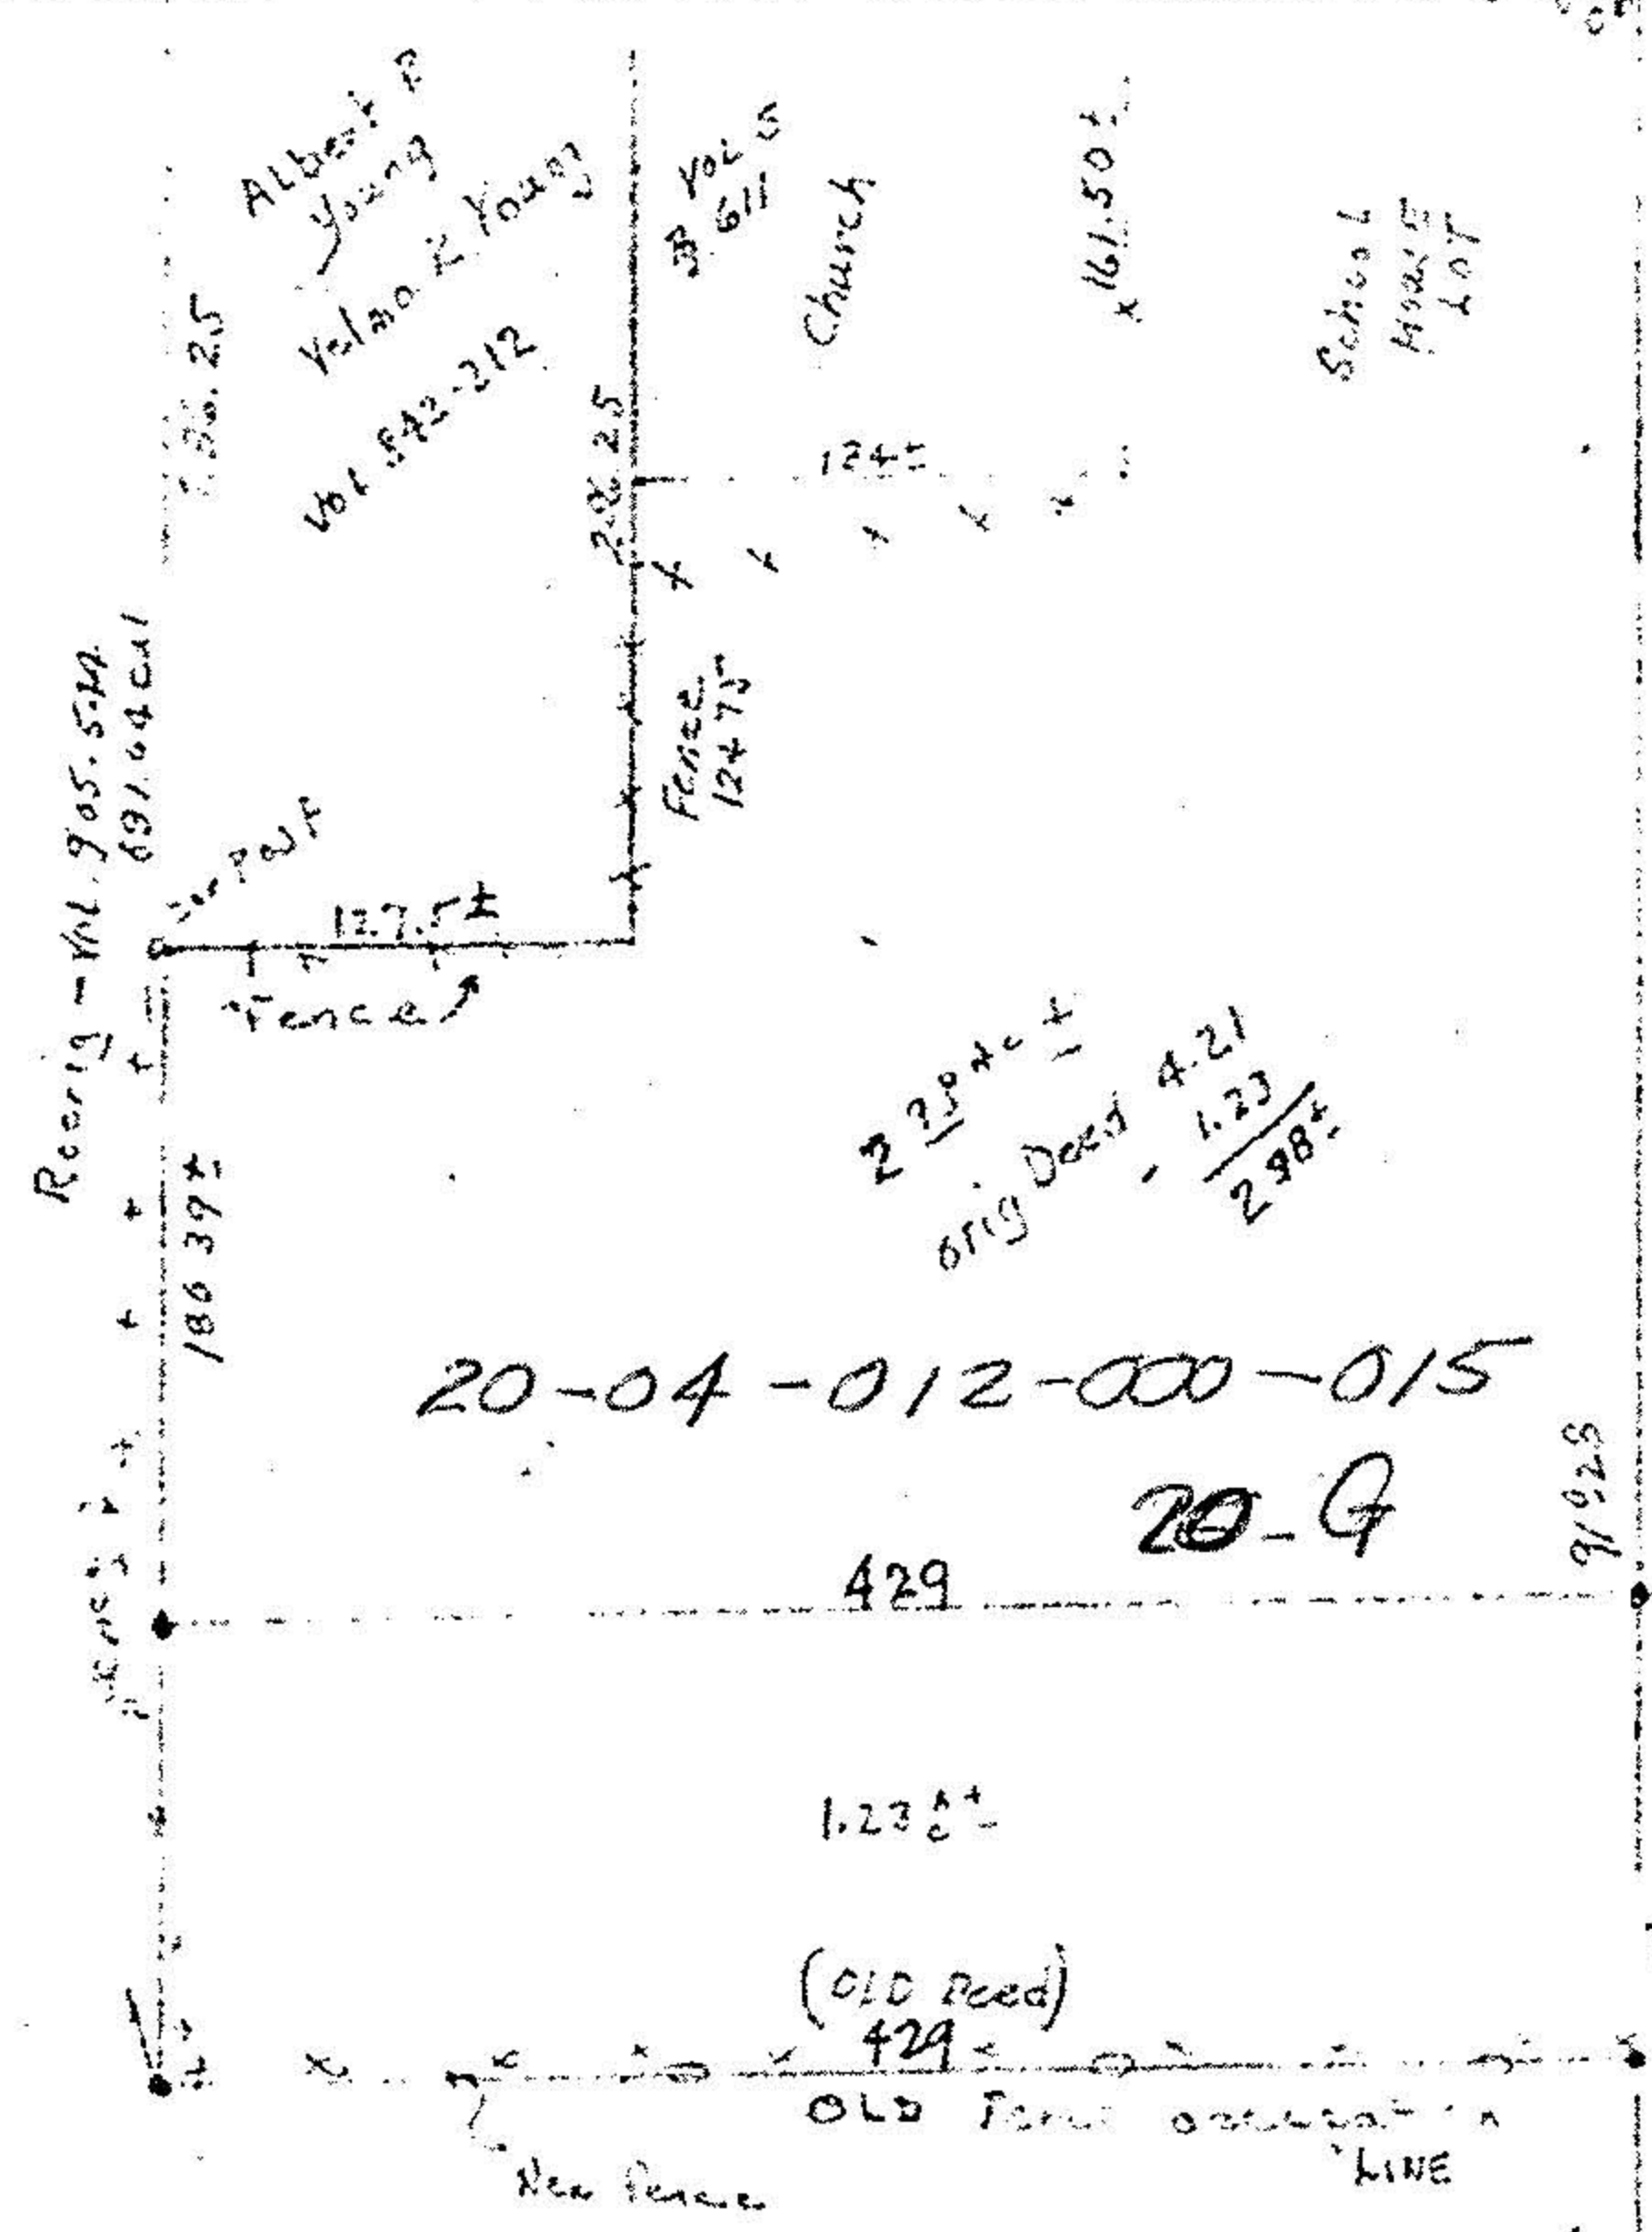

20-04-012-000-015

20-G

429

1.23 ±

(OLD Deed)  
429

OLD Fence occupation  
LINE

William Frank Roorig  
ROBERT W Roorig Vol 905-544

- NOTE See deed Vol 12-255
- Vol R-375
  - Vol 232-234
  - Vol 104-329
  - Vol 111-169
  - Vol 133-296
  - Vol 50-507
  - Vol 391-113
  - Vol 432-22
  - Vol 105-544
  - Vol 115-541

STATE RD #111  
581.70  
Ashland Supton (VERMILION)