


N Line Lot 15 Tract 4

Survey part of Lot 15 Tract 4 Rochester Twp.
Lorain Co. Ohio Scale 1" 100' Oct. 29, 1985
By Arnold F. Koepp Reg. Surveyor No. 4306

20-04-015-000-0

-006-1.85Ac

#16495

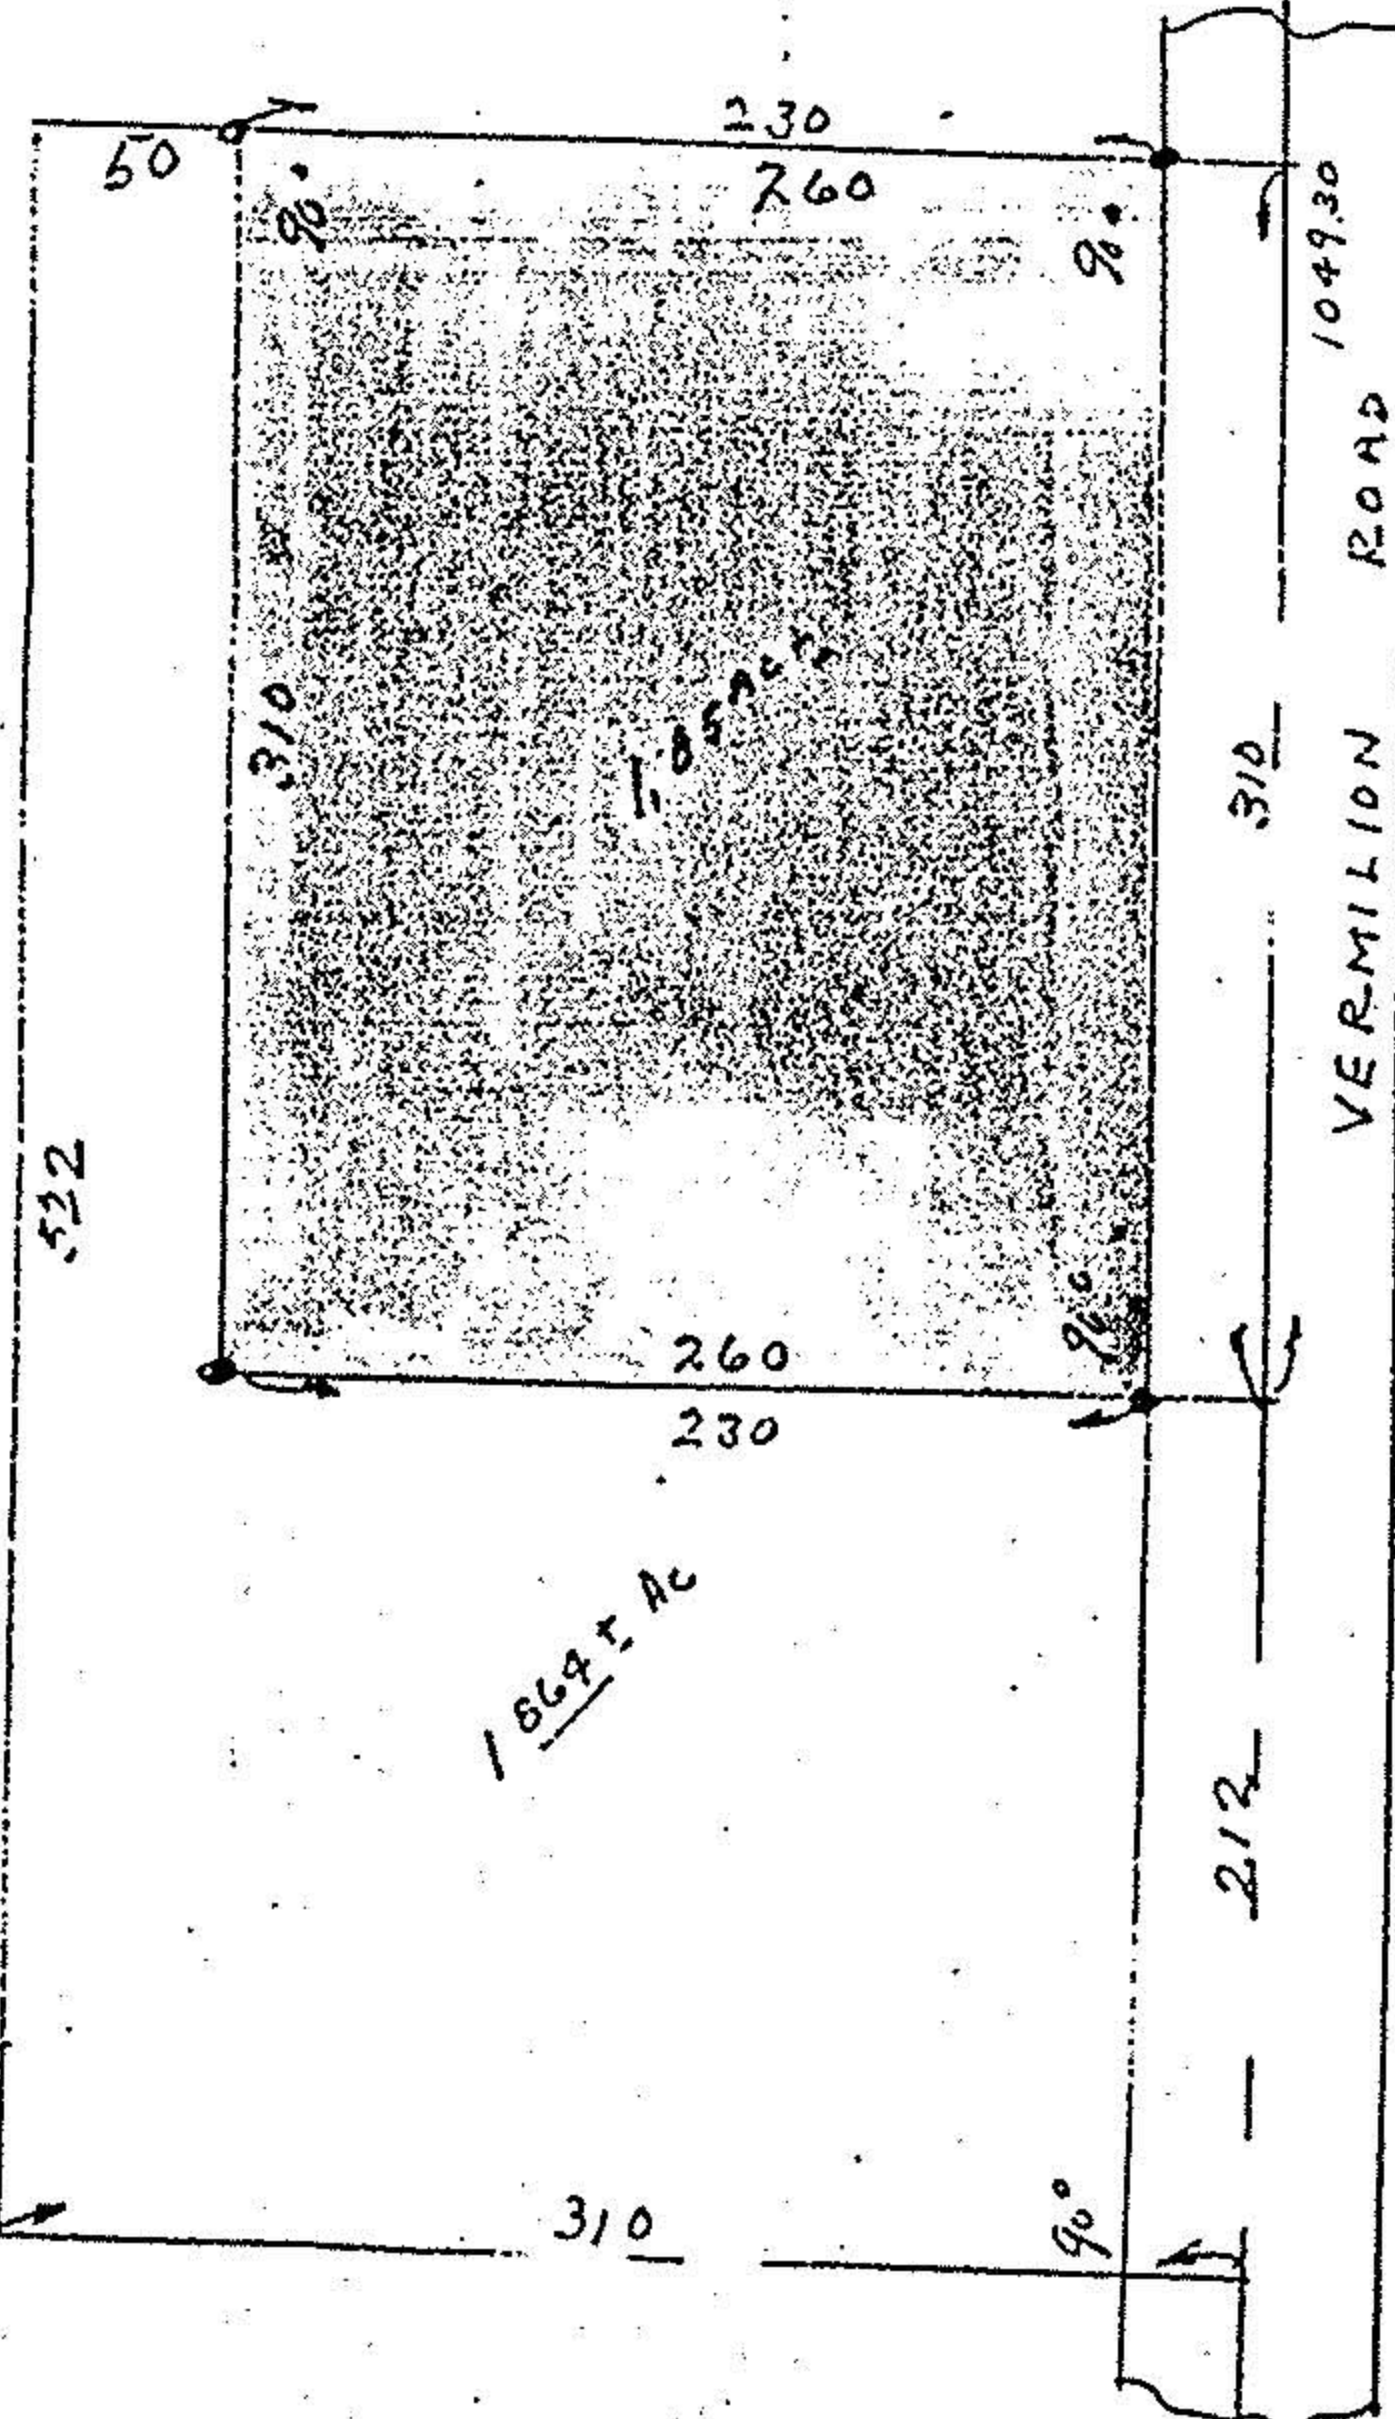

50'17" W 739.30
STATE ROUTE 511

310
VERMILION ROAD
1049.30

212

Lot 15
Lot 18

#16495
APPROVED
LORAIN CO.
MAP DEPT.

DATE 12.10.85

PAGE 20-G

BY T. McMan

VOID

20-9
014-15
T. A