


20-05004-000-007

20271

007 1.48 AC.

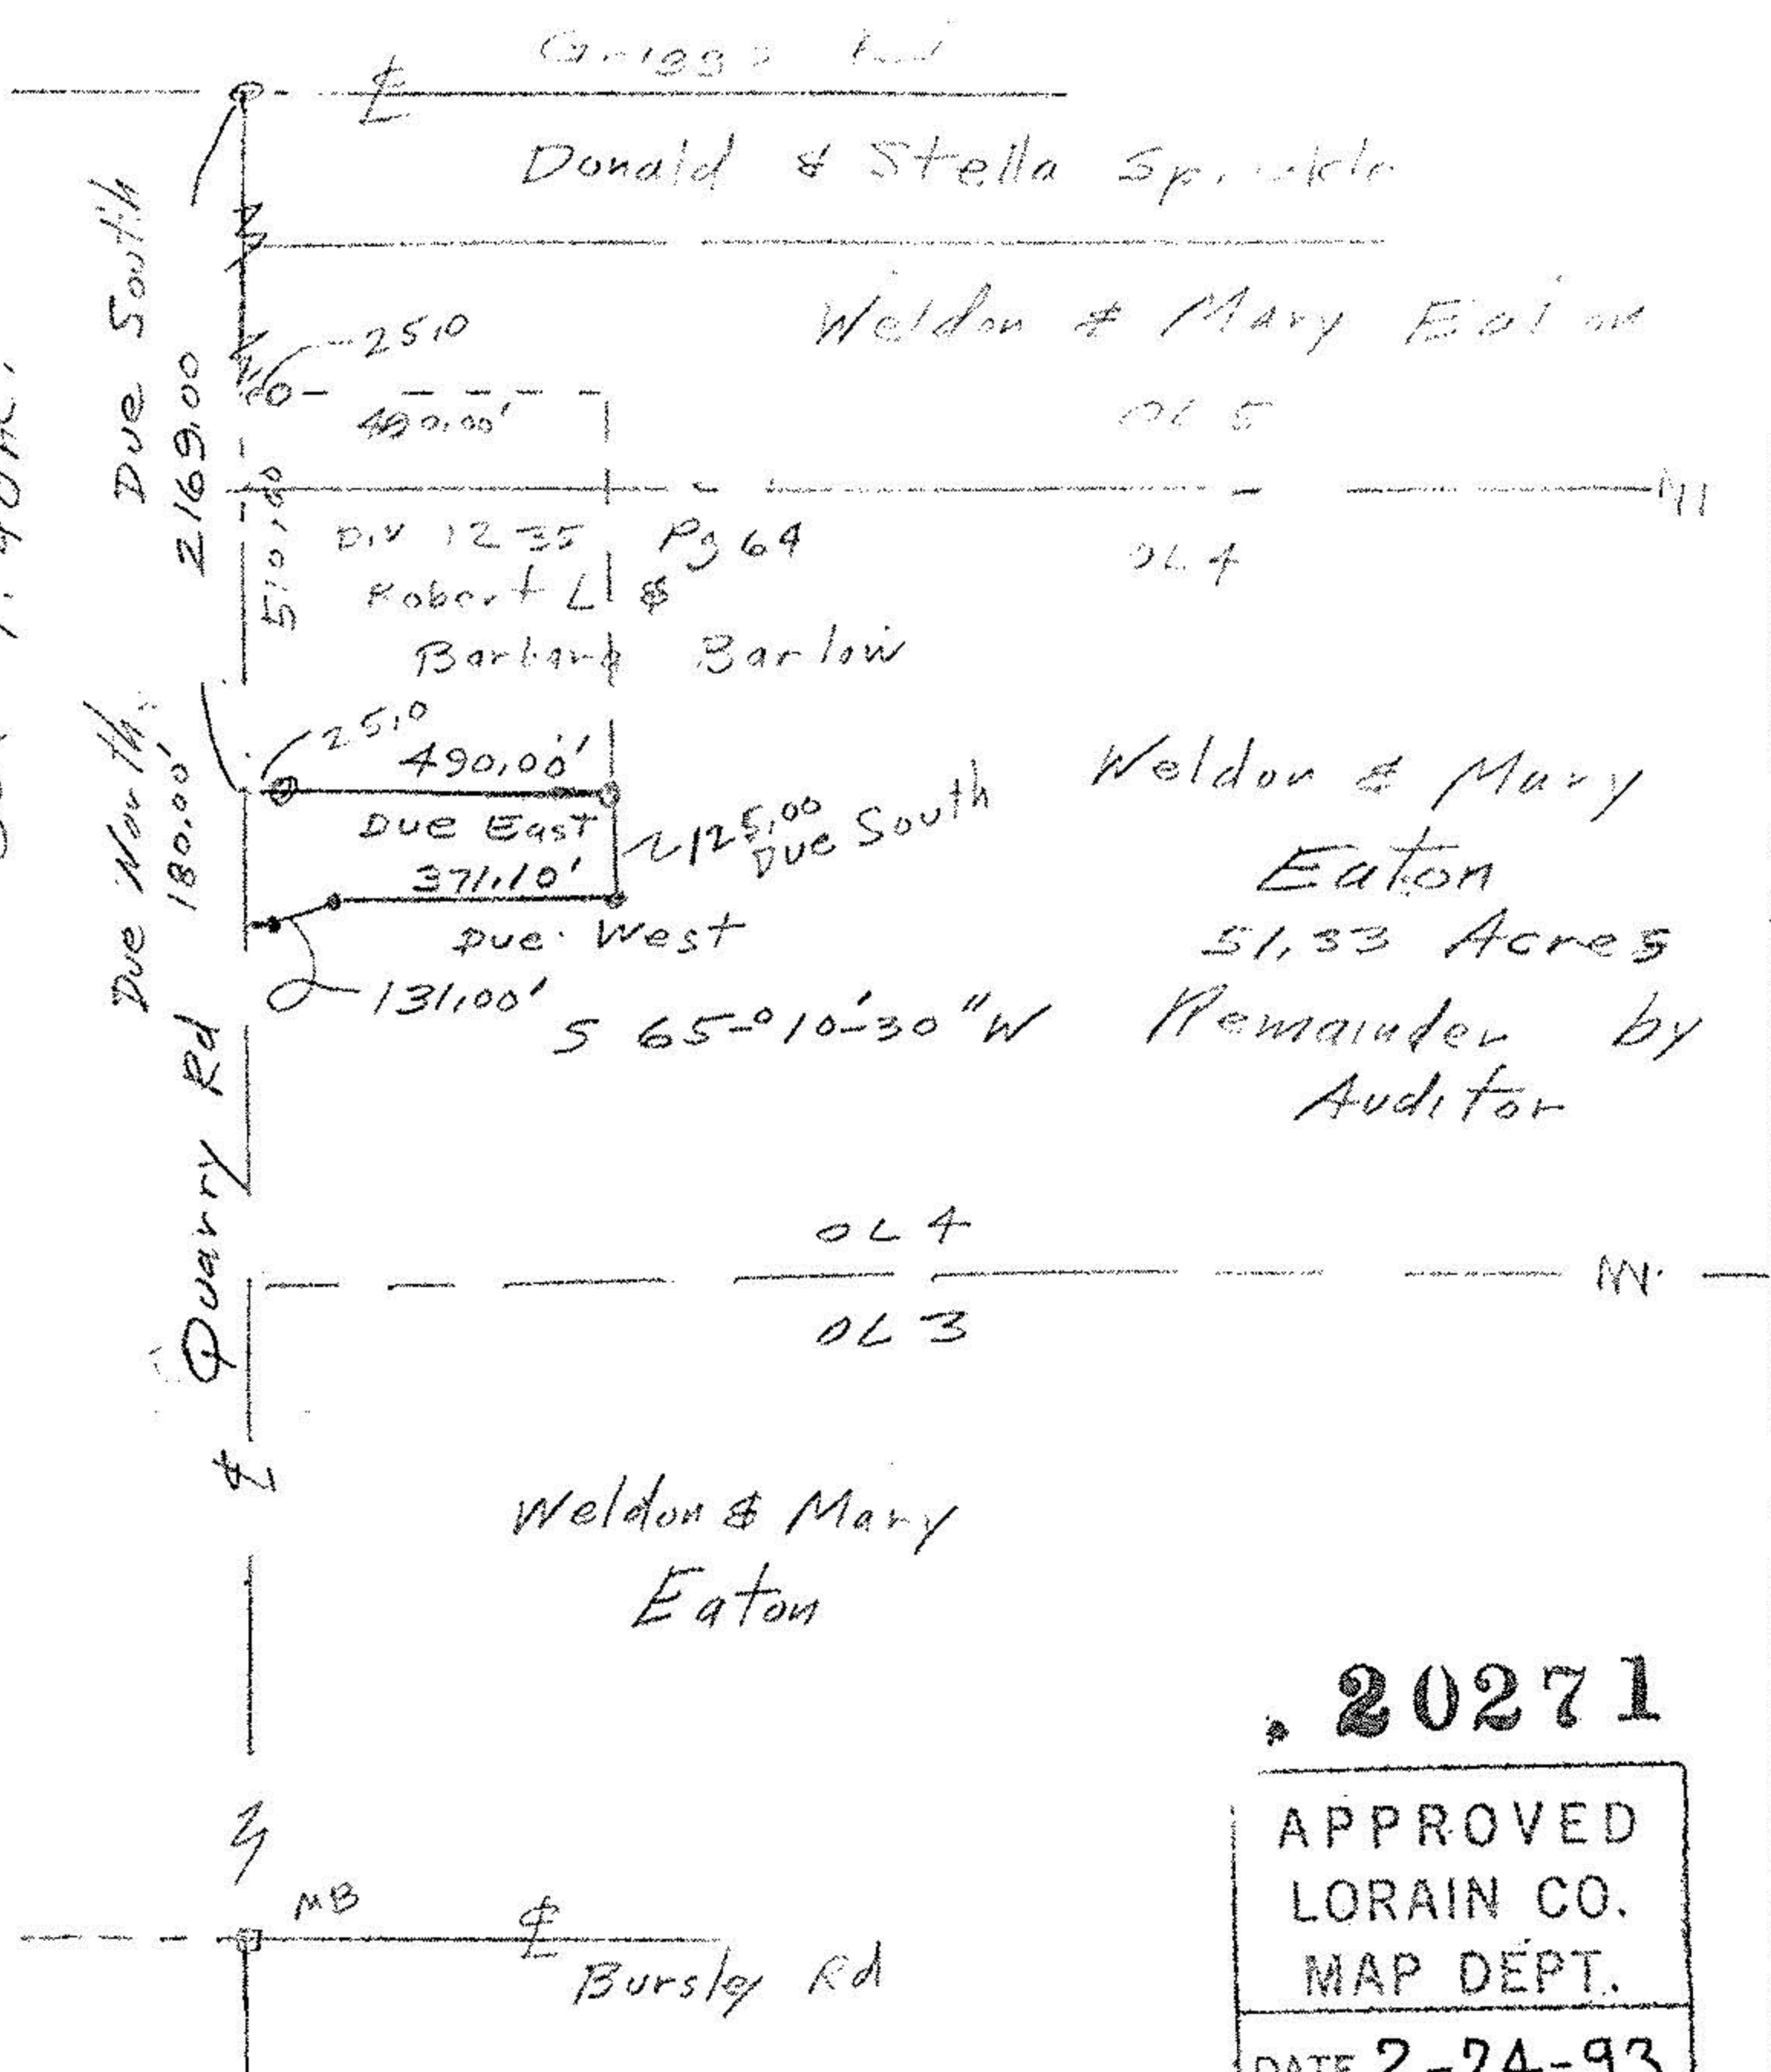


20271

APPROVED LORAIN CO. MAP DEPT.
DATE 2-24-93
PAGE 20-D
BY CAROLYN FRANCIS
VOID AETER # 20271

- Monument Box
- iron pipes fd 25 ft ±
- iron pipes set

Parcel split of 1.481 Acres

John Poznywak
Reg Surveyor
5292

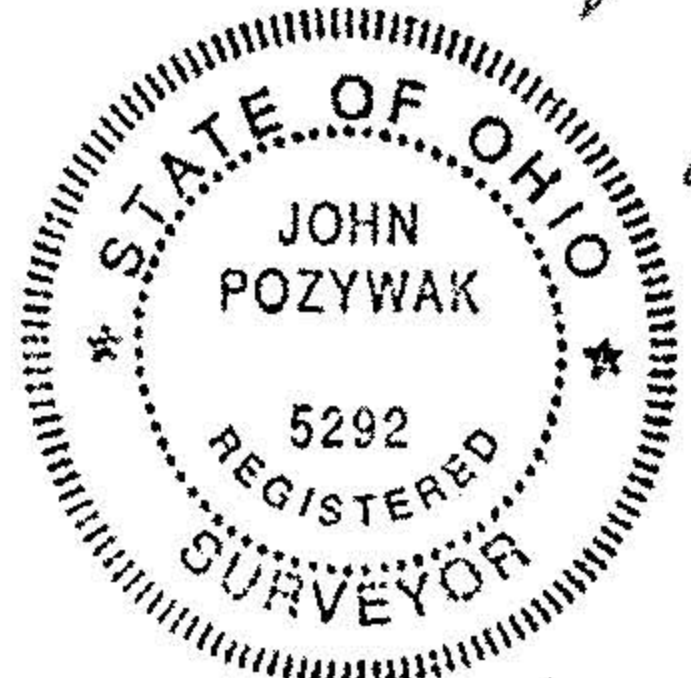

Survey of Parcel Split
for Bob Eaton
Tract 5 Original Lot 4
Rochester Township
Lorain County Ohio
Scale 1" = 400 Sept 8, 92

20271