
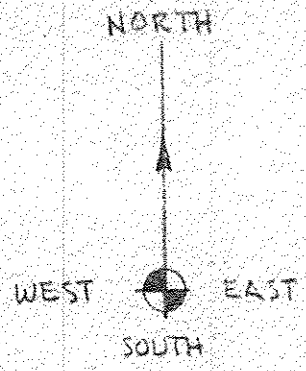


Dred To Be Reliked By Seaway Title 5/23/77 JG

20-05-002-000-023  
 20-05-008-000-007  
 20-05-002-000-023  
 20-05-008-000-007  
 Scan # 30507

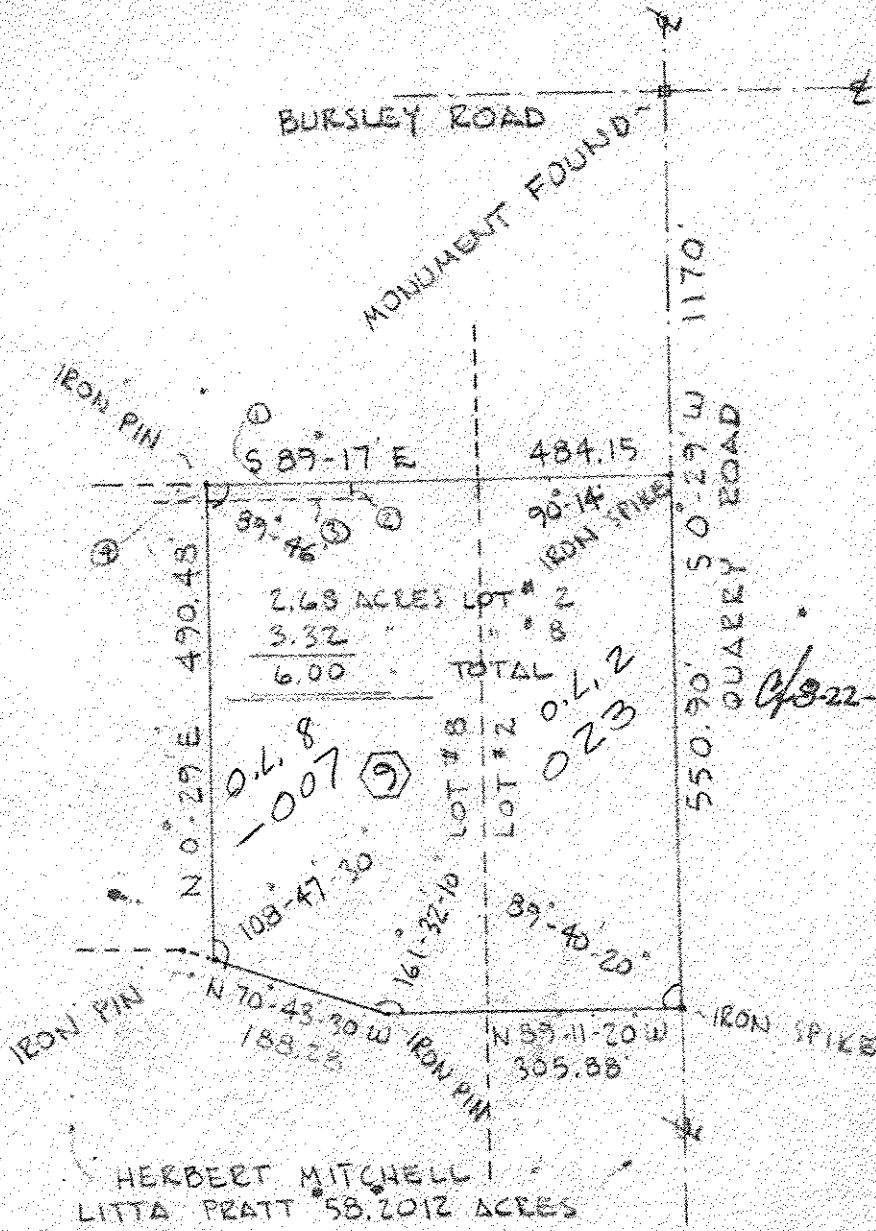

# 14591  
 # 18587A

# 18587-A  
 # 14591

APPROVED  
 LORAIN CO.  
 MAP DEPT.  
 DATE 3.16.82  
 PAGE 20-D  
 BY T. M. Main  
 VOID AFTER

HERBERT MITCHELL  
 LITTA PRATT 58.2012 ACRES

15' EASEMENT FOR DRAINAGE (.03 ACRES)

- ⊙ S 89-17 E 100
- ⊙ S 0-29 W 15
- ⊙ N 89-17 W 100
- ⊙ N 0-29 E 15

MAURICE A. & DOBIS IRISH

SITUATED IN LOT # 8 LOT # 2  
 TRACT # 5  
 ROCHESTER TOWNSHIP  
 LORAIN COUNTY, OHIO

20-D

Thomas G. Reel  
 SCALE 1" = 200.0'  
 DECEMBER 1973

FILE # 423 8

THOMAS G. REEL, P.E. ENGINEER-SURVEYOR MILAN, OHIO