


20-05-009-000

20-05-009

20-D

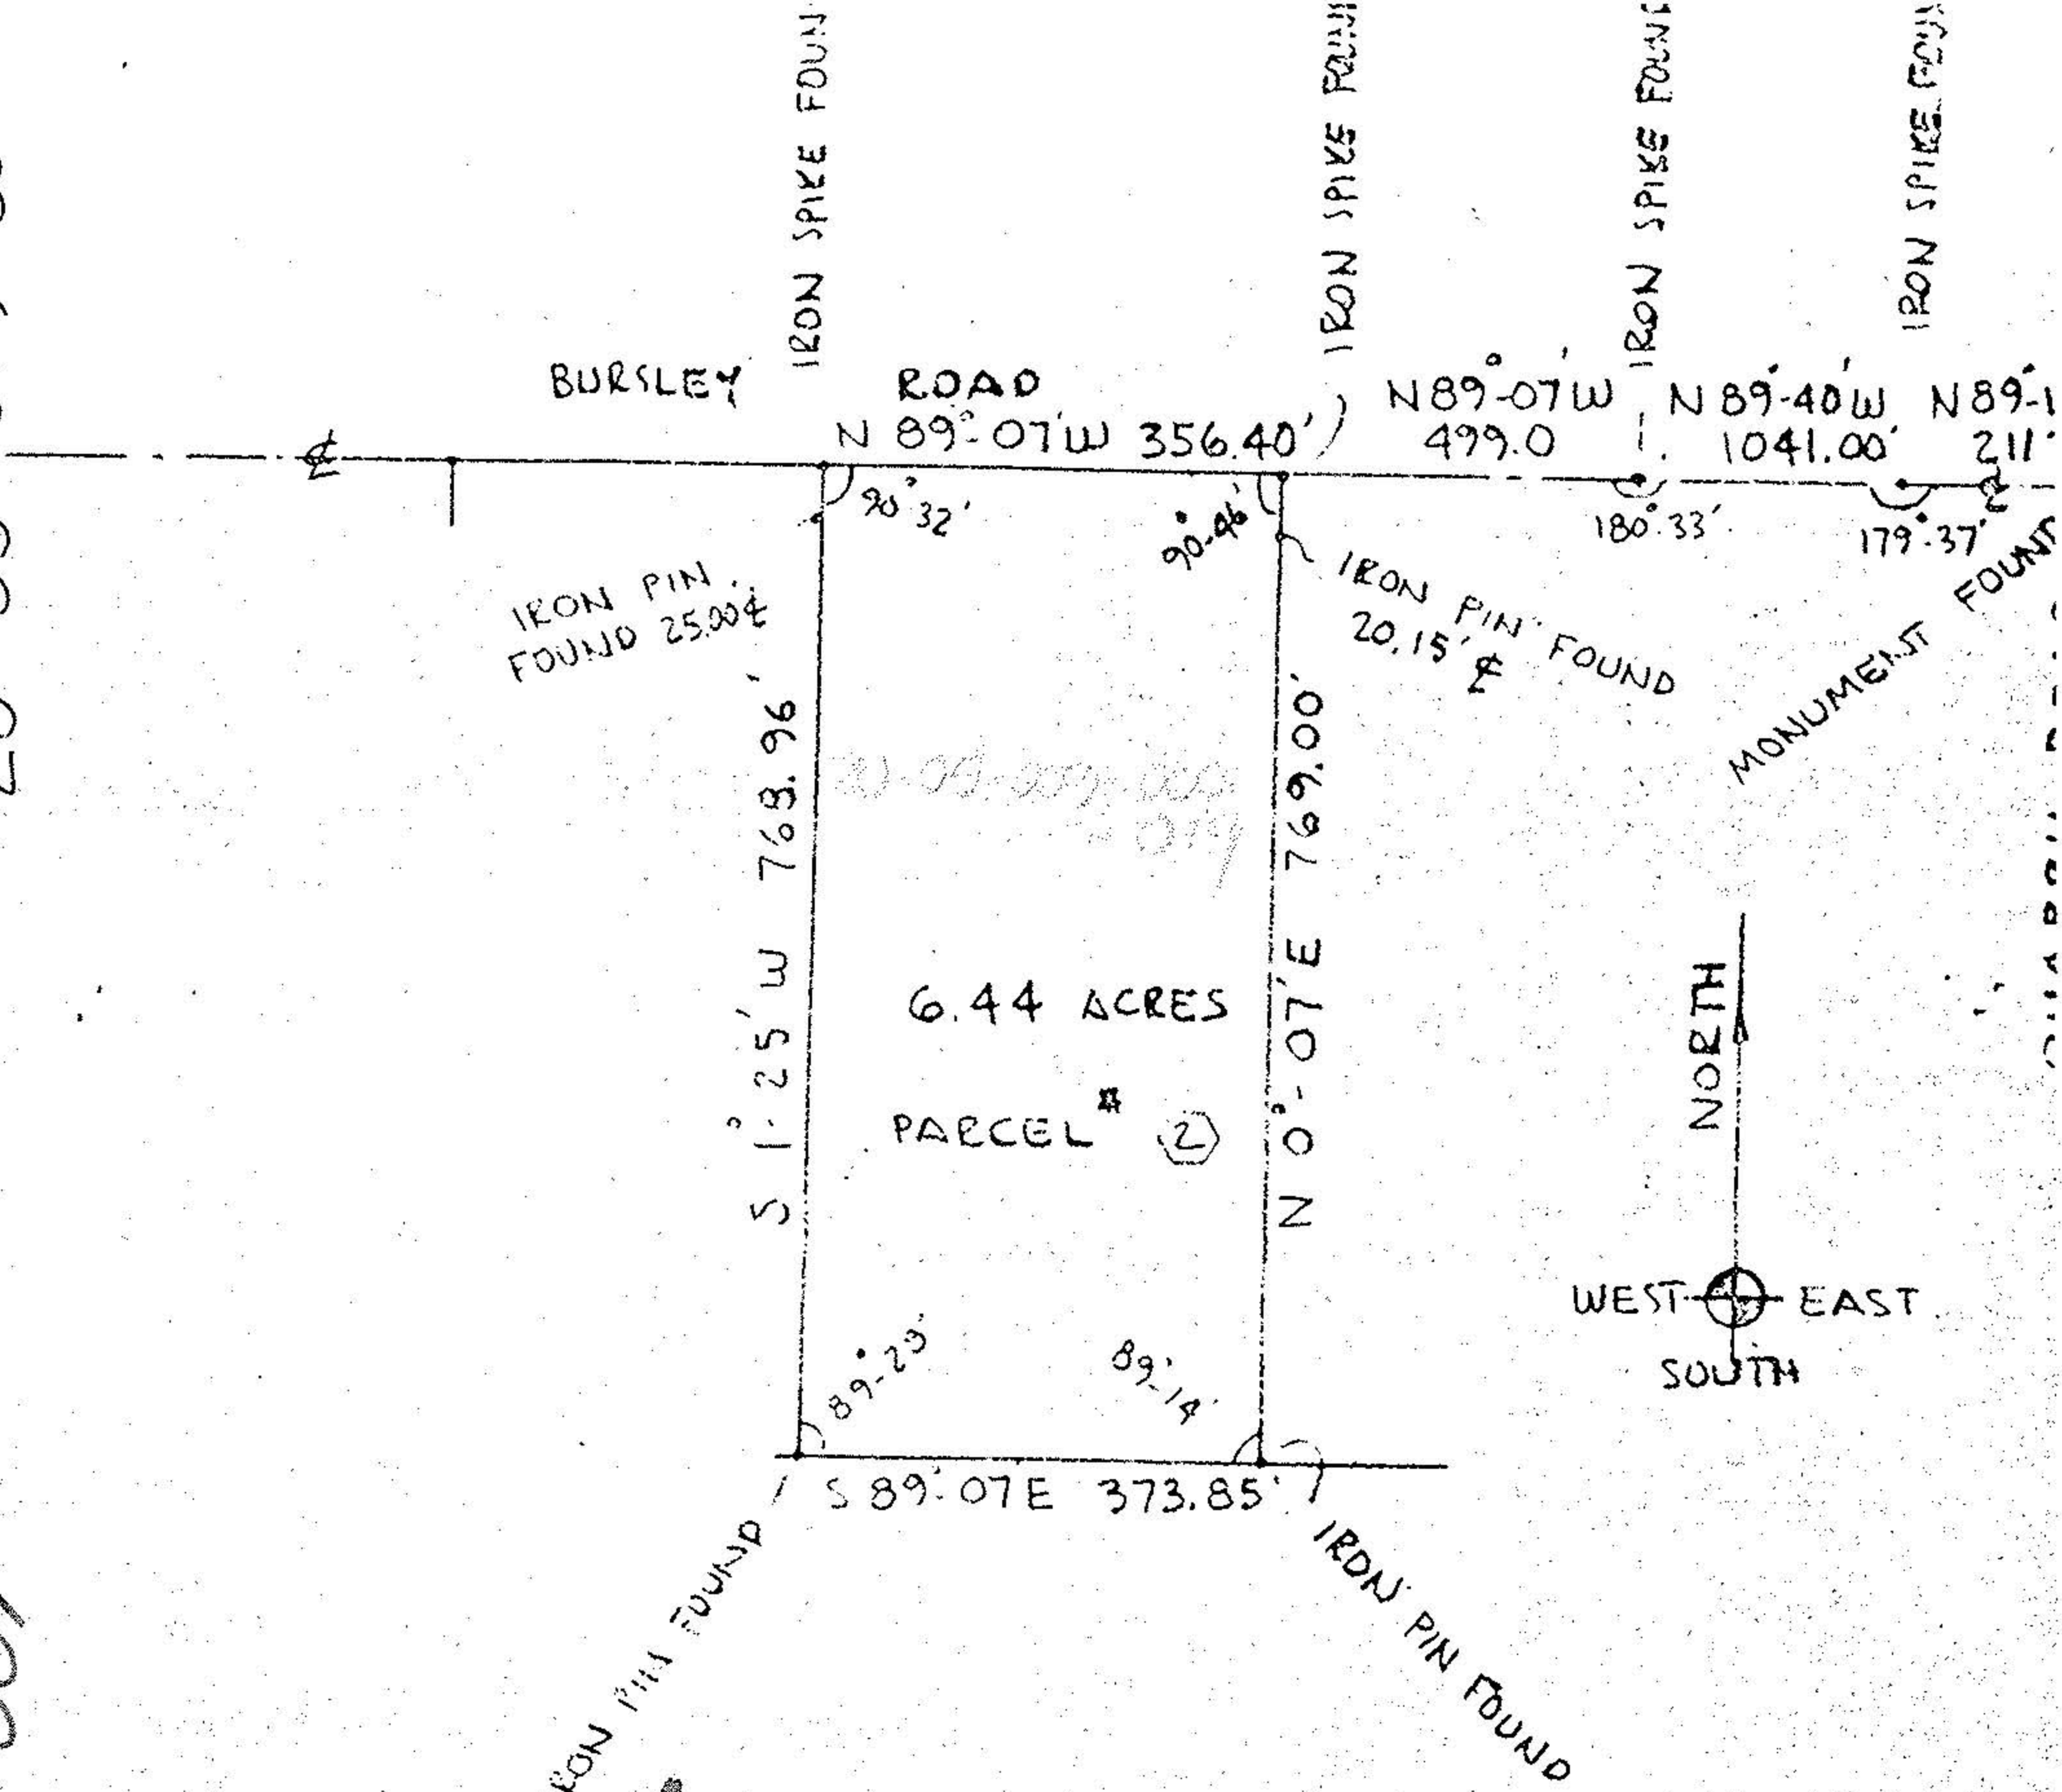


IRON PIN FOUND 25.00'

IRON PIN FOUND 20.15'


6.44 ACRES

PARCEL # (2)

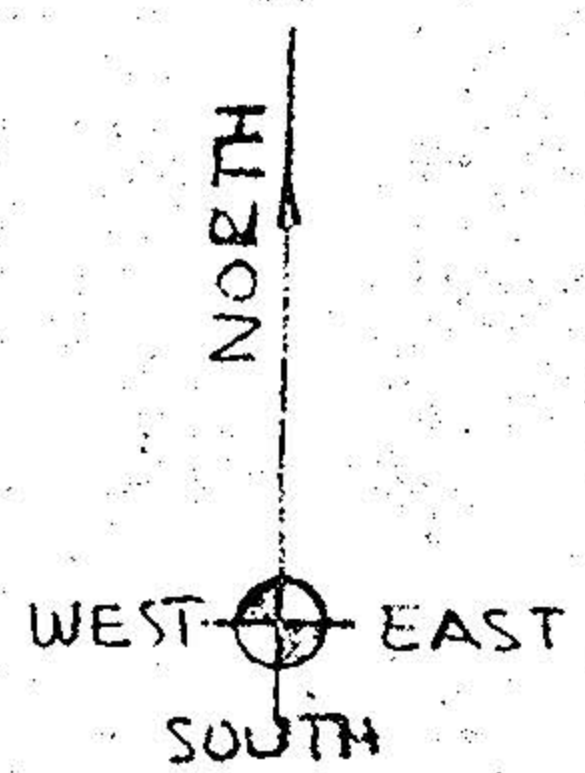

OK

MAURICE A. & DORIS IRISH
 SITUATED IN LOT #9
 TRACT #5
 ROCHESTER, TOWNSHIP
 LORAIN COUNTY, OHIO

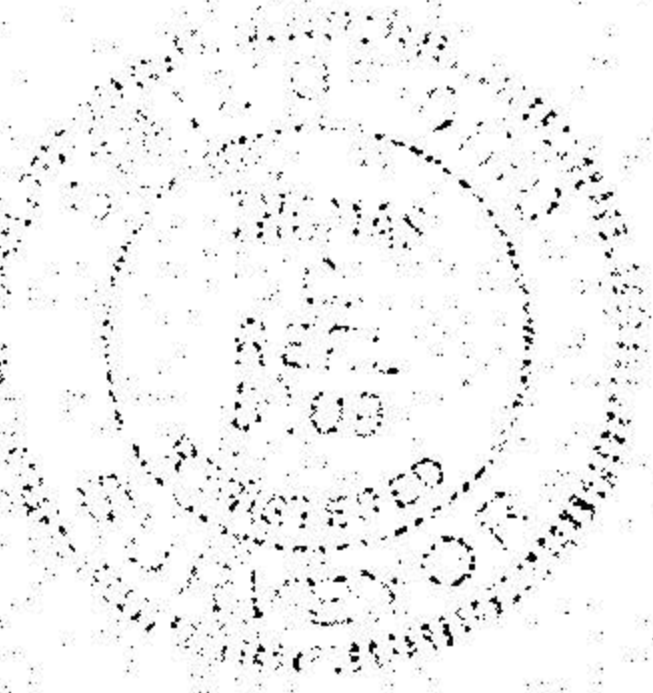

James D Auld
 23 FEBRUARY 1973
 SCALE 1" = 200' 0"

FILE # 1208