

PLAT OF SURVEY
FOR
RICHARD LYON
PART OF LOT NO. 9, TRACT 5,
ROCHESTER TWP.
LORAIN COUNTY, OHIO

Bursley Rd.

N 89° 07' 00" W 1539.10' N 89° 40' 00" W 1041.00' N 89° 17' 00" W 211.78'

20-05-009-000
20-D
#21589

MAGNETIC NORTH
Bouding Owner?

S 89° 07' 00" E 304.30'

N 01° 18' 24" E ?
Grantors West Line
749.19'

4.7915 AC

758.67'

S 05° 24' 39" W
DONNA GREER
VOL. 454, PG. 204,205
PARCEL NO. 007.

250.05' GRANTORS SOUTH LINE ?
? LOT LINE ?

Bouding OWNER

- LEGEND:
- IRON PIN SET
 - IRON PIN FOUND
 - HUB SET
 - RRS FOUND
 - RRS SET
 - PK NAIL SET
 - FENCE POST FOUND

-
-
-
- ▲
- △
-
-




I hereby certify this survey to be correct to the best of my knowledge.

William L. Fox

William L. Fox, P.S. 5878

Quarry Rd.

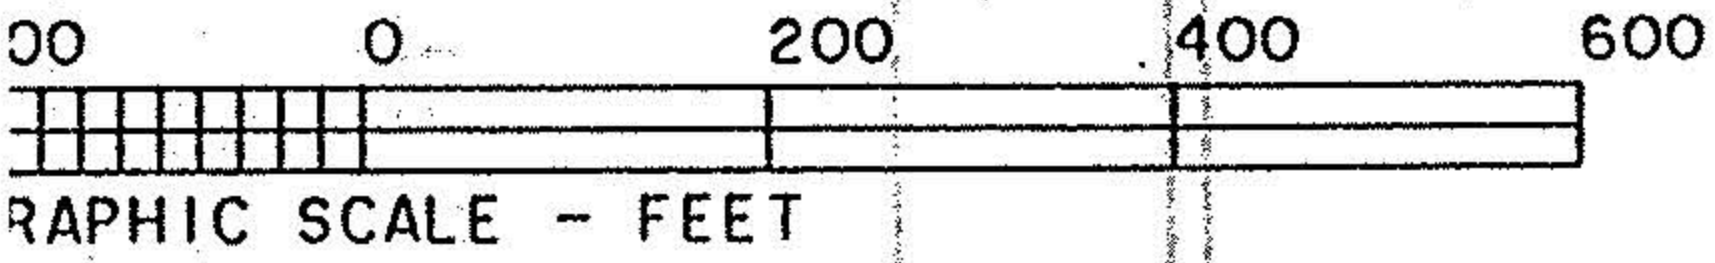

(419)-289-7820
Questions on DEED & Survey MAP