


20-05-018-000
-018
15350
20-C

WILLIAM B. BARTON

REG. LAND SURVEYOR
188 PARKWOOD AVENUE
AVON LAKE, OHIO 44012
TELEPHONE (216) 933-6062

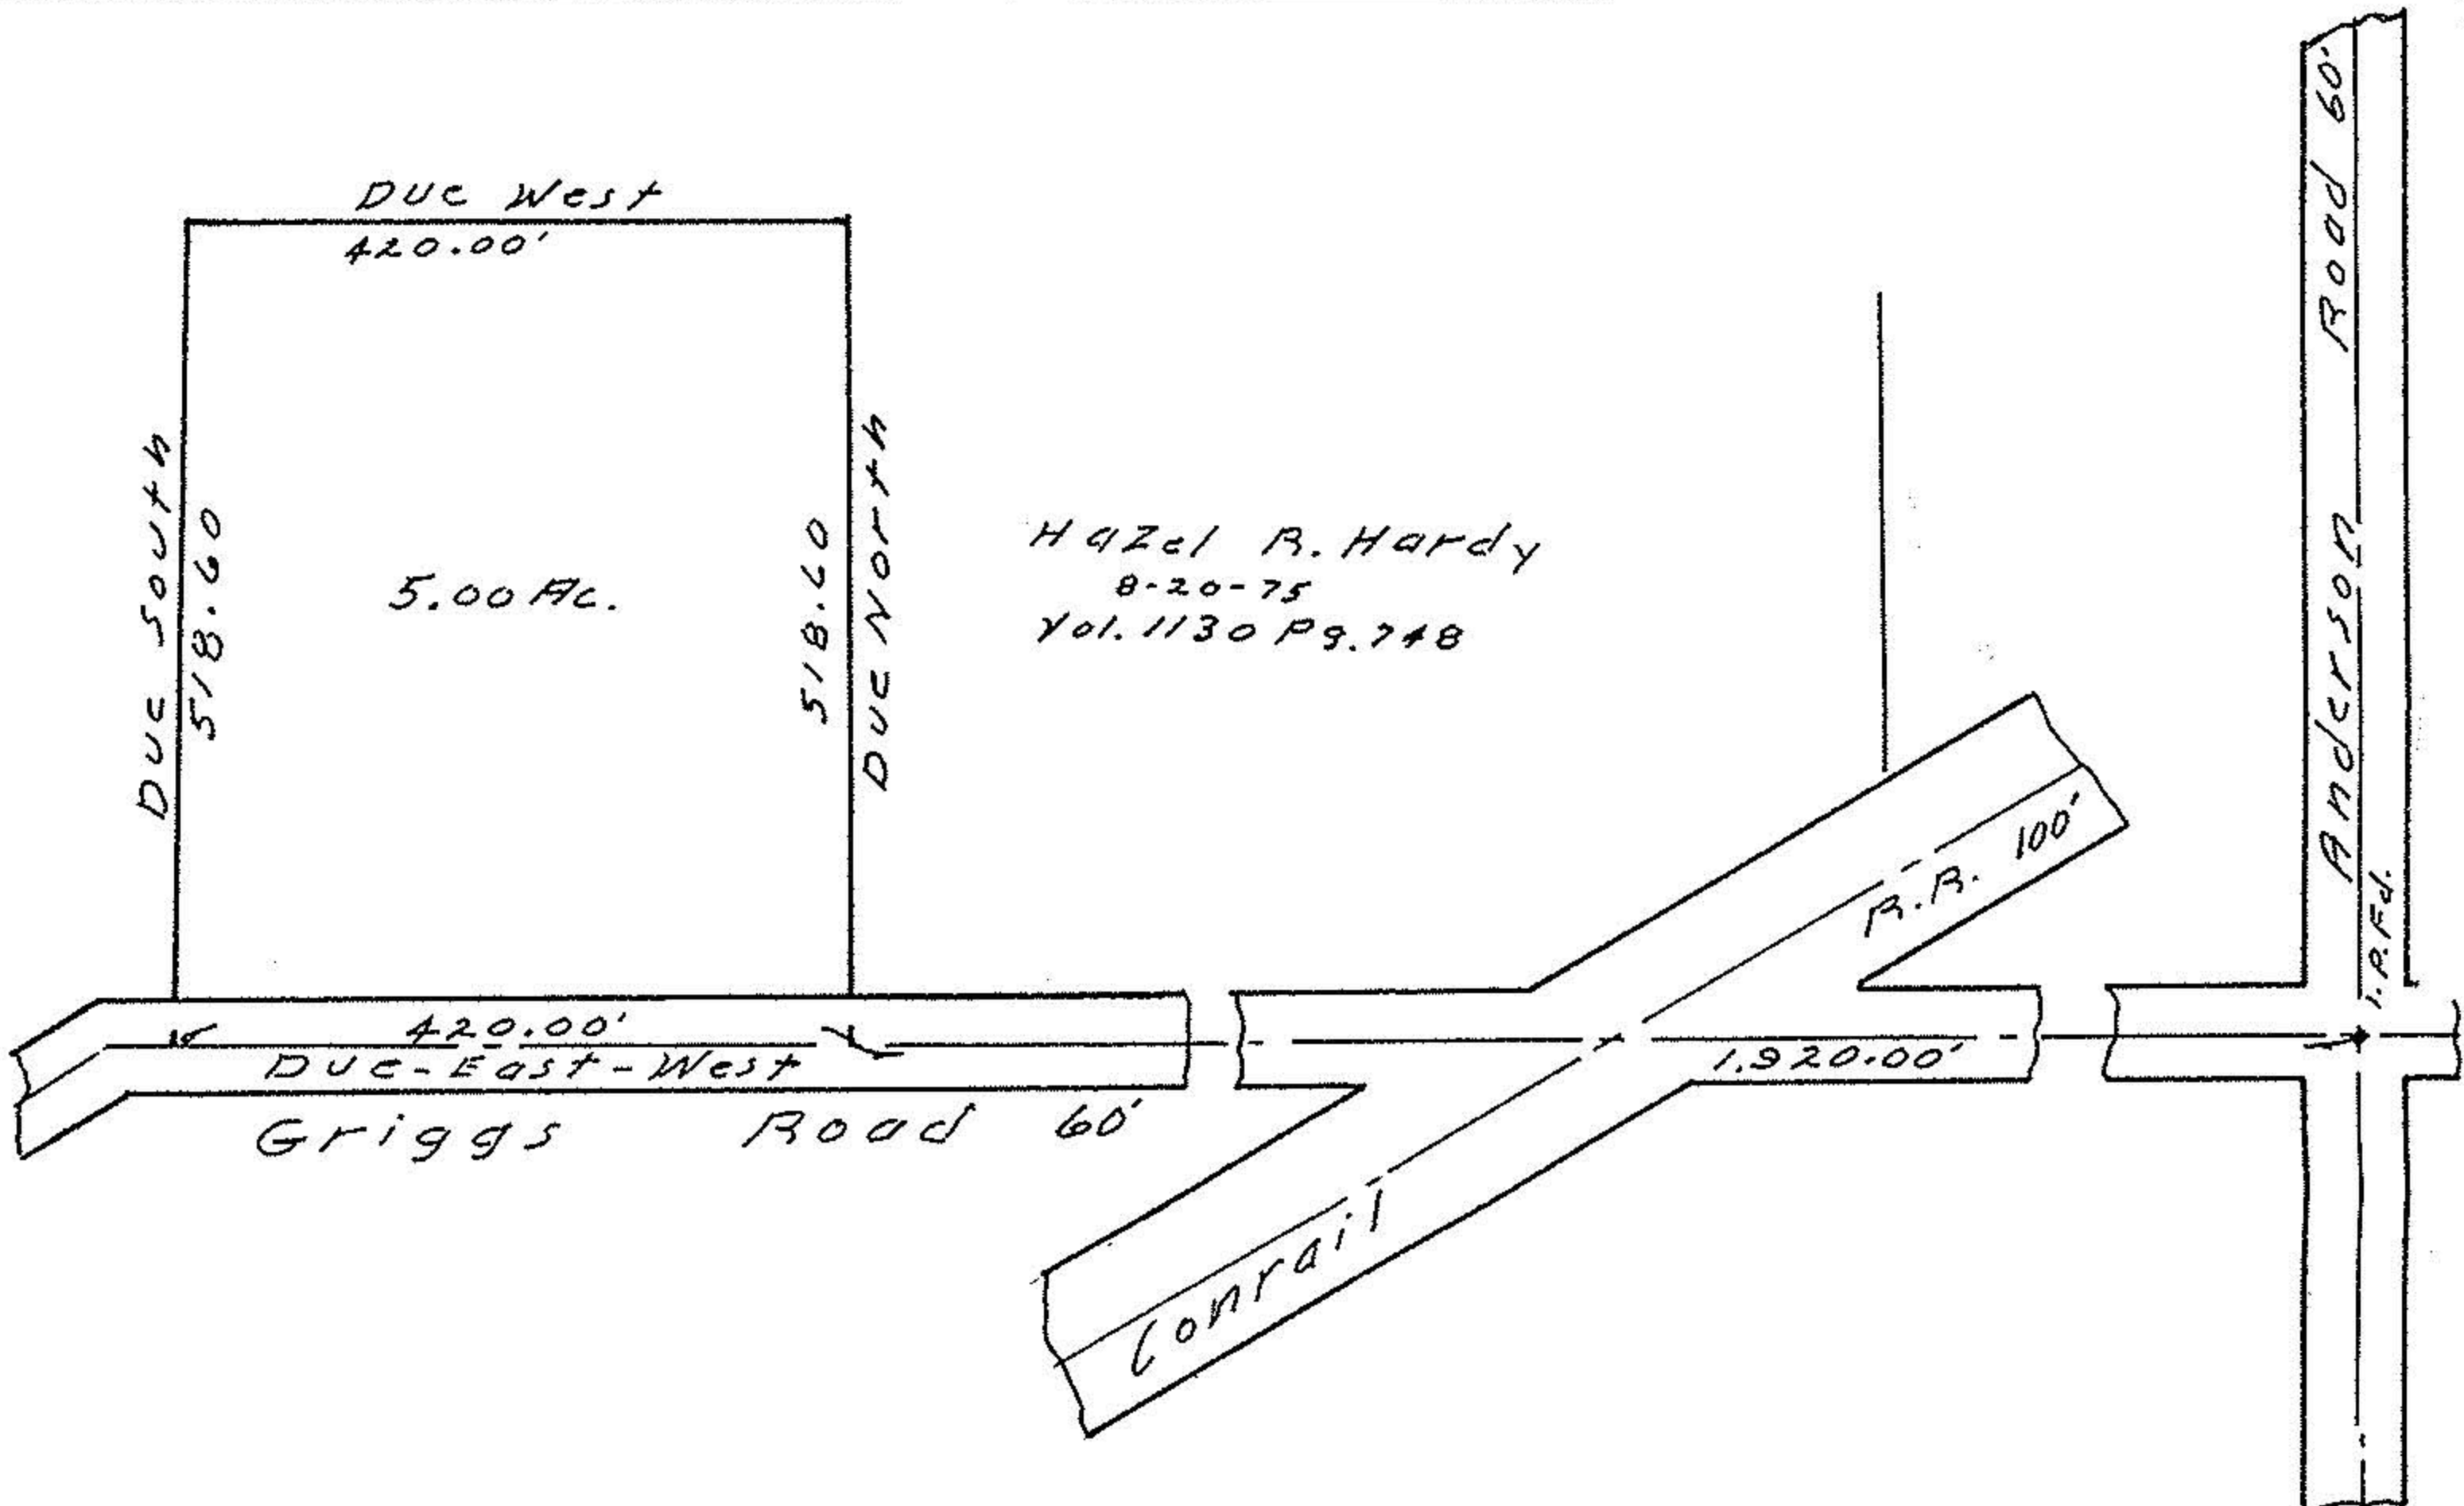

SURVEY FOR
Hazel R. Hardy of part of
Original Lot No. 18 Tract
No. 5 of Rochester Village
Rochester Township, Lorain
County Ohio. By William B.
Barton Reg. Surveyor No. 4438.
Scale 1"=100' August 13, 1983.



#15350

APPROVED
LORAIN CO.
MAP DEPT.

DATE 11-3-83
PAGE 20-C
BY T. McNair
VOID
IF
ALTER

