

REVISED SEPT. 25, 1989 - R.G.S. 89-1877
 SURVEY of 5/2's 22 & 23


21557
 APPROVED
 LORAIN CO.
 MAP DEPT
 DATE 11-2-95
 PAGE 20-05-023B
 BY CAROLYN
 FRANCIS
 #21557

20-05-023-101 -
 REV. 9-6-95 Split S/L 3 R.G.S.

• - DENOTES IRON PIN SET

O.L. 23
 O.L. 22

FORMERLY: C. & ST. L. R.R.
 NEW YORK CENTRAL

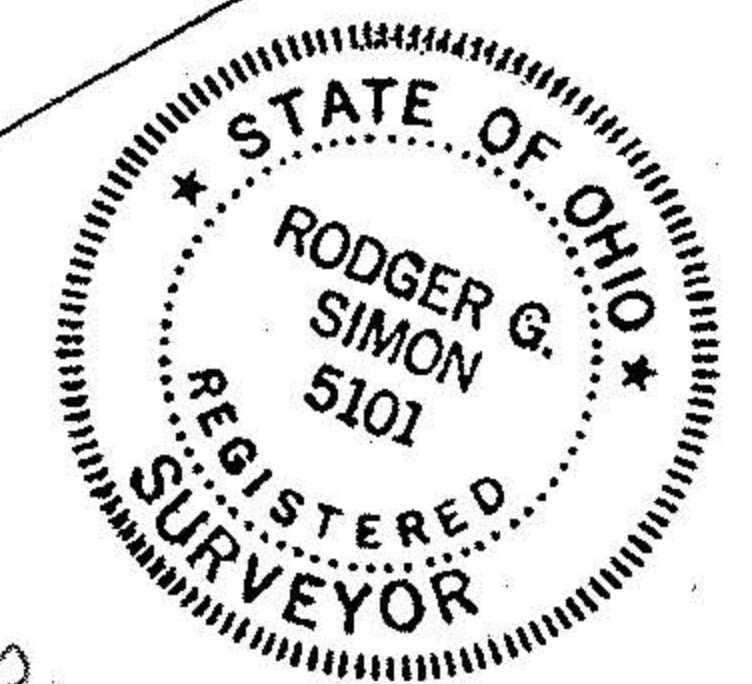

Job No. 75-450
 F.D. 195, Pg. 16

SURVEY FOR PAUL R. & NORA J. HARWOOD
 SUBLOTS 4, 7, 8, 11, 12, 13, 14, 15, 16, 17, 24 -
 OF D. GILLMORES ADDITION - VOL. 1, PG. 8
 O.L. 23, TRACT 5, ROCHESTER TOWNSHIP
 ROCHESTER, OHIO
 SCALE: 1" = 50'
 LAUNDON, SIMON, CAHL - ENGINEERS, SURVEYORS
 DEC. 1975