

Weldon & Mary
Eaton

D.V. 1230
Pg 124

S 88° 12' E

Quarry Rd 50'

N 2° 00' E

289.5 ±

1383.40

3.000 Acres

325.00

325.00'

S 2° 00' W

13.952 Ac

25.0

208.10 ±

N 88° 12' W

402.10

1790.50'

N 88° 12' W

0.4

MA

Weldon & Mary Eaton

D.V. 1018 Pg 407

Rochester Twp

Huntington Twp

Margaret McCafferty

327-01

PAGE 20-10

BY J. HARTFIELD

#015-00697

Lorain County
Field BK
158 for ±

205.7

88.00'

±

MB


Bursley Rd

Weldon & Mary
Eaton

043

D.V. 1361
Pg 31

- o Iron pins
- o Iron pins set
- o Monument

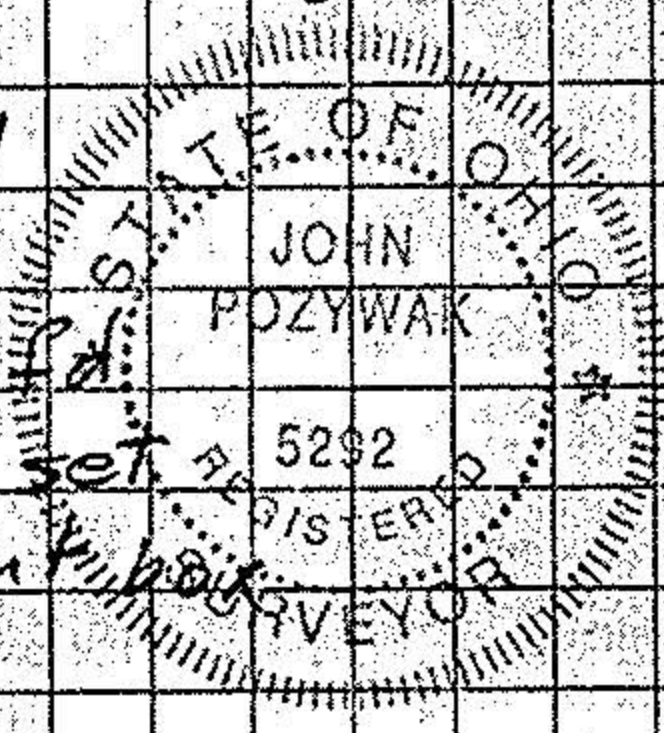

Survey of Parcel Split
Original Lot 4 Tract 5
Rochester Township
Lorain County Ohio
Scale 1" = 100' May 1998
Jan 2001