

KLEINOEDER-SCHMIDT

and ASSOCIATES

ENGINEERS — SURVEYORS — CONSULTANTS IN LAND PLANNING

ELYRIA · MORWALK · MEDINA

OHIO

SURVEY

Sublot(s) _____



Subd'n _____

Township ROCHESTER Tract 6

Orig. Lot(s) 16 Sec. _____

County of LORAIN State of Ohio

Corporation _____

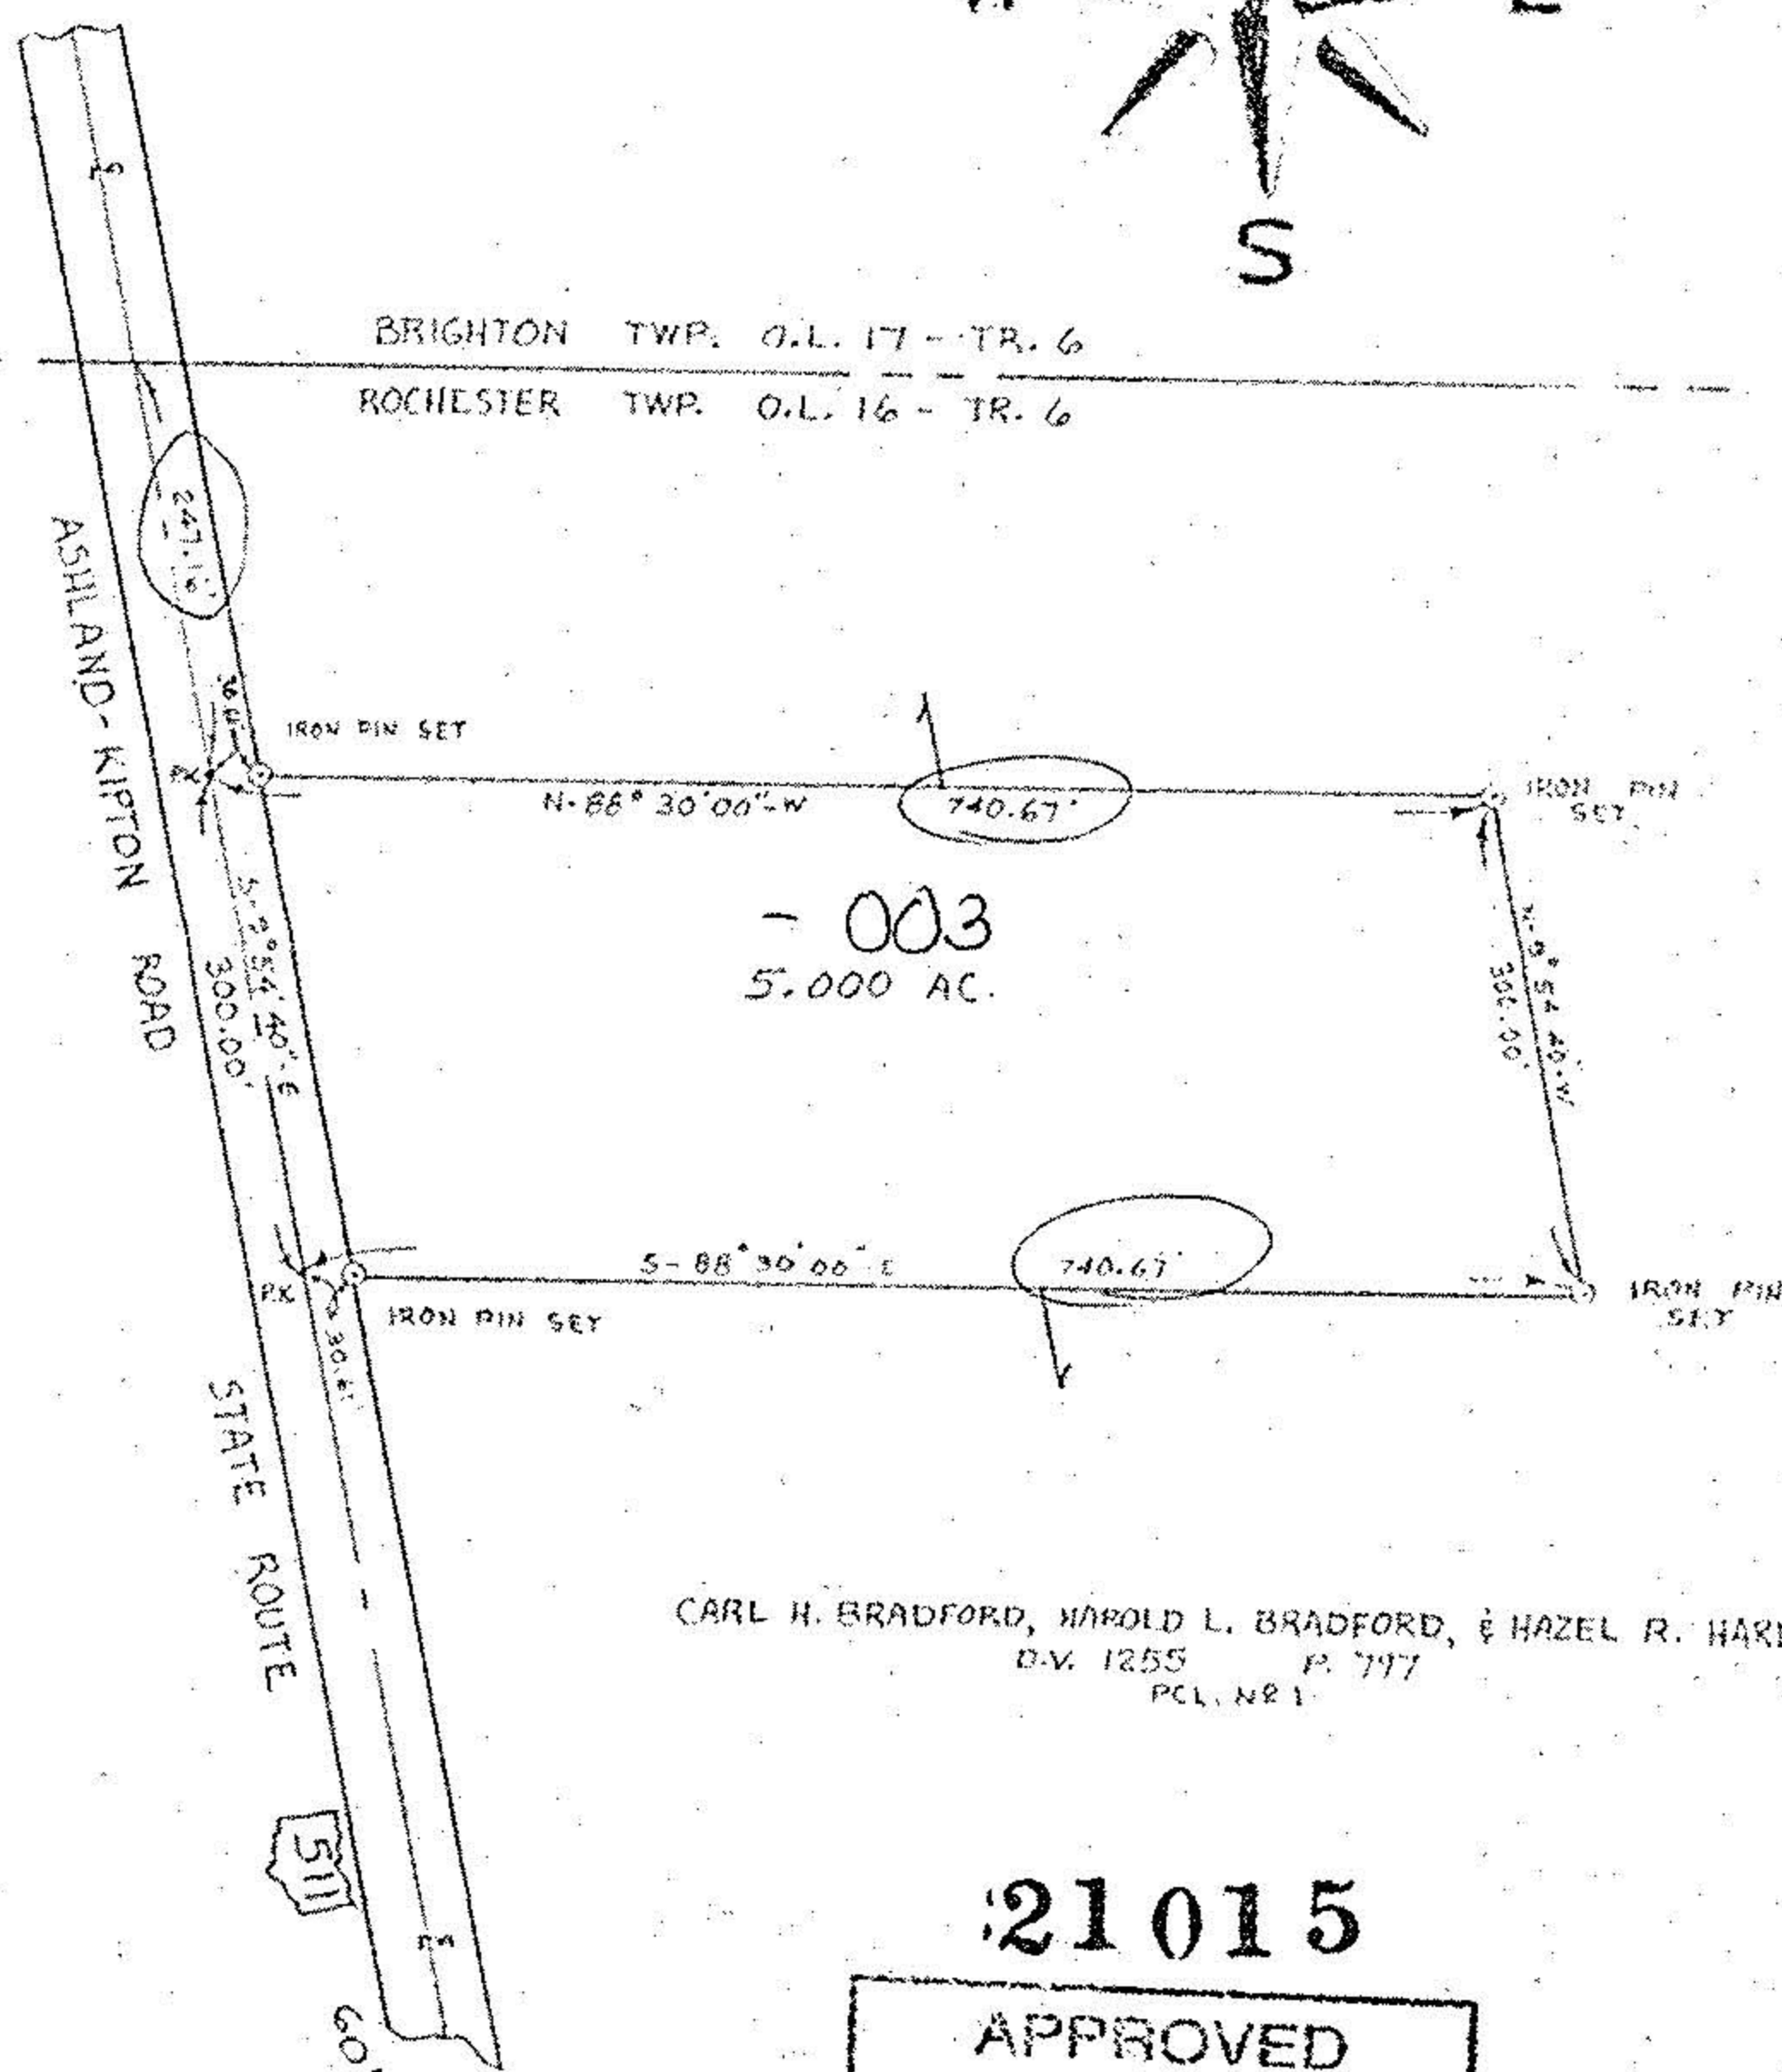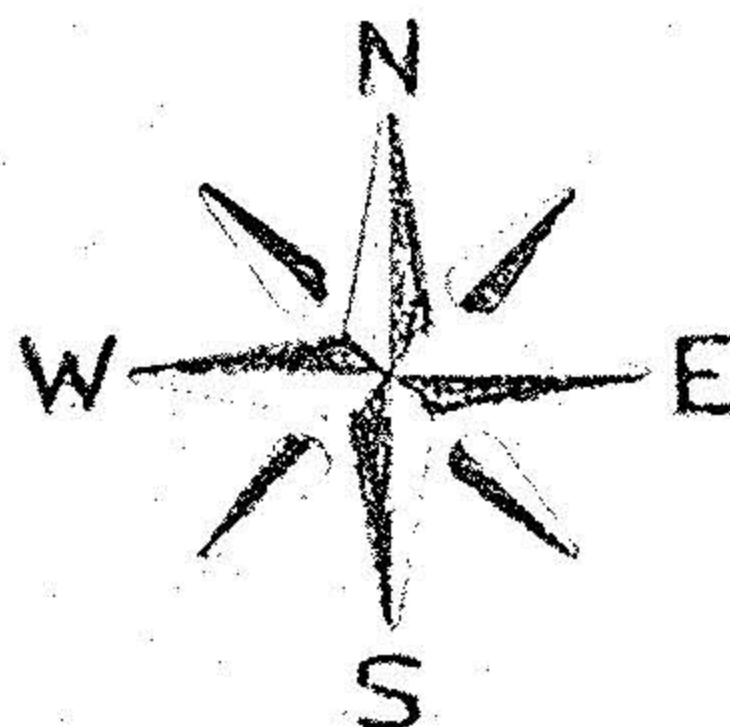

21015

APPROVED LORAIN CO. MAP DEPT
DATE 8-22-94
PAGE 20-C
BY CAROLYN FRANCIS
#21015

David L. Elwell
REG. SURV. NO. 6333



Prepared for: CARL BRADFORD

Scale: 1" = 200'

Date: 6-27-80

Dr. by: K.V.S.

Job No 80-90