


ASSUMED MERIDIAN S-N



William Lee Spencer
 WILLIAM LEE SPENCER
 REG. SURVEYOR NO. 6561

#00218
 APPROVED
 LORAIN CO.
 MAP DEPT.
 DATE 9/23/99
 PAGE 20-F
7. Spill
 00218

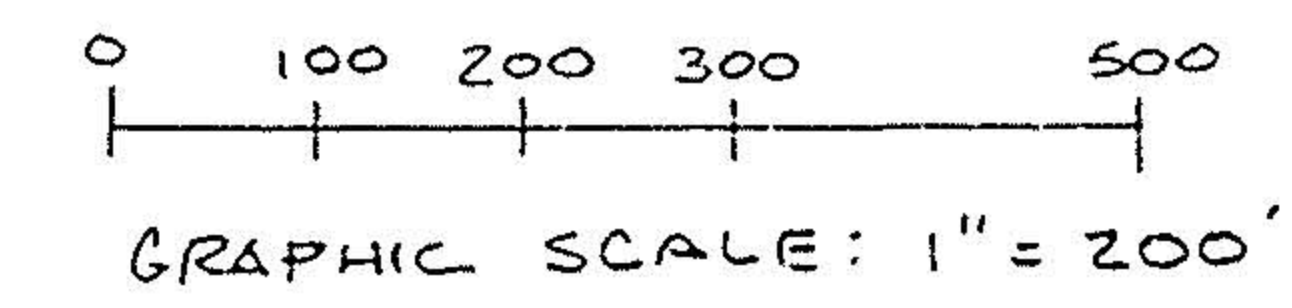

NOTES:

1. ERROR OF CLOSURE 1:10,000'
2. NORTH BASED ON A ASSUMED MERIDIAN.
3. THIS SURVEY BASED ON LORAIN COUNTY DEED, PLAT & SURVEY RECORDS, REF. EDWARD G. BLACK PS.#6365 SURVEYS.
4. PARCEL "B" INCLUDES 17.6435 AC. OWNED BY KATHY HENRICKS, PLUS 1.4460 AC. IN PARCEL "C".
5. PARCEL "A" IS THE REMAINDER OF 7.5954 AC. OWNED BY VALERIE J. CERLAN, MINUS PARCEL "C".

LEGEND:

- O 5/8" I.P. W/CAP SET
- X PK NAIL SET
- ⊗ PK NAIL FOUND
- ⊙ 1/2" I.P. W/CAP FOUND
- ▲ RRS FD.
- ⊙ 1/2" I.P. FOUND
- R RECORD
- M MEASURED

SURVEY OF PARCEL A, B & C PART OF LOT 9 OF THE GORE STRIP RODCHESTER TOWNSHIP, LORAIN COUNTY OHIO		
SCALE: 1" = 200'	APPROVED BY:	DRAWN BY WLS
DATE: 7/31/99		REVISED
PREPARED FOR KATHY HENRICKS		DRAWING NUMBER 99-026