

SURVEY


Sublot(s) 9134
 Subd'n _____

Township HUNTINGTON Tract 8
 Orig. Lots 7 Sec. _____
 County of LORAIN State of Ohio
 Corporation _____

21-08-004-000
 21-08-007-000

21-F-H
 21-08-007

21-08-007-000
 21-08-007-000

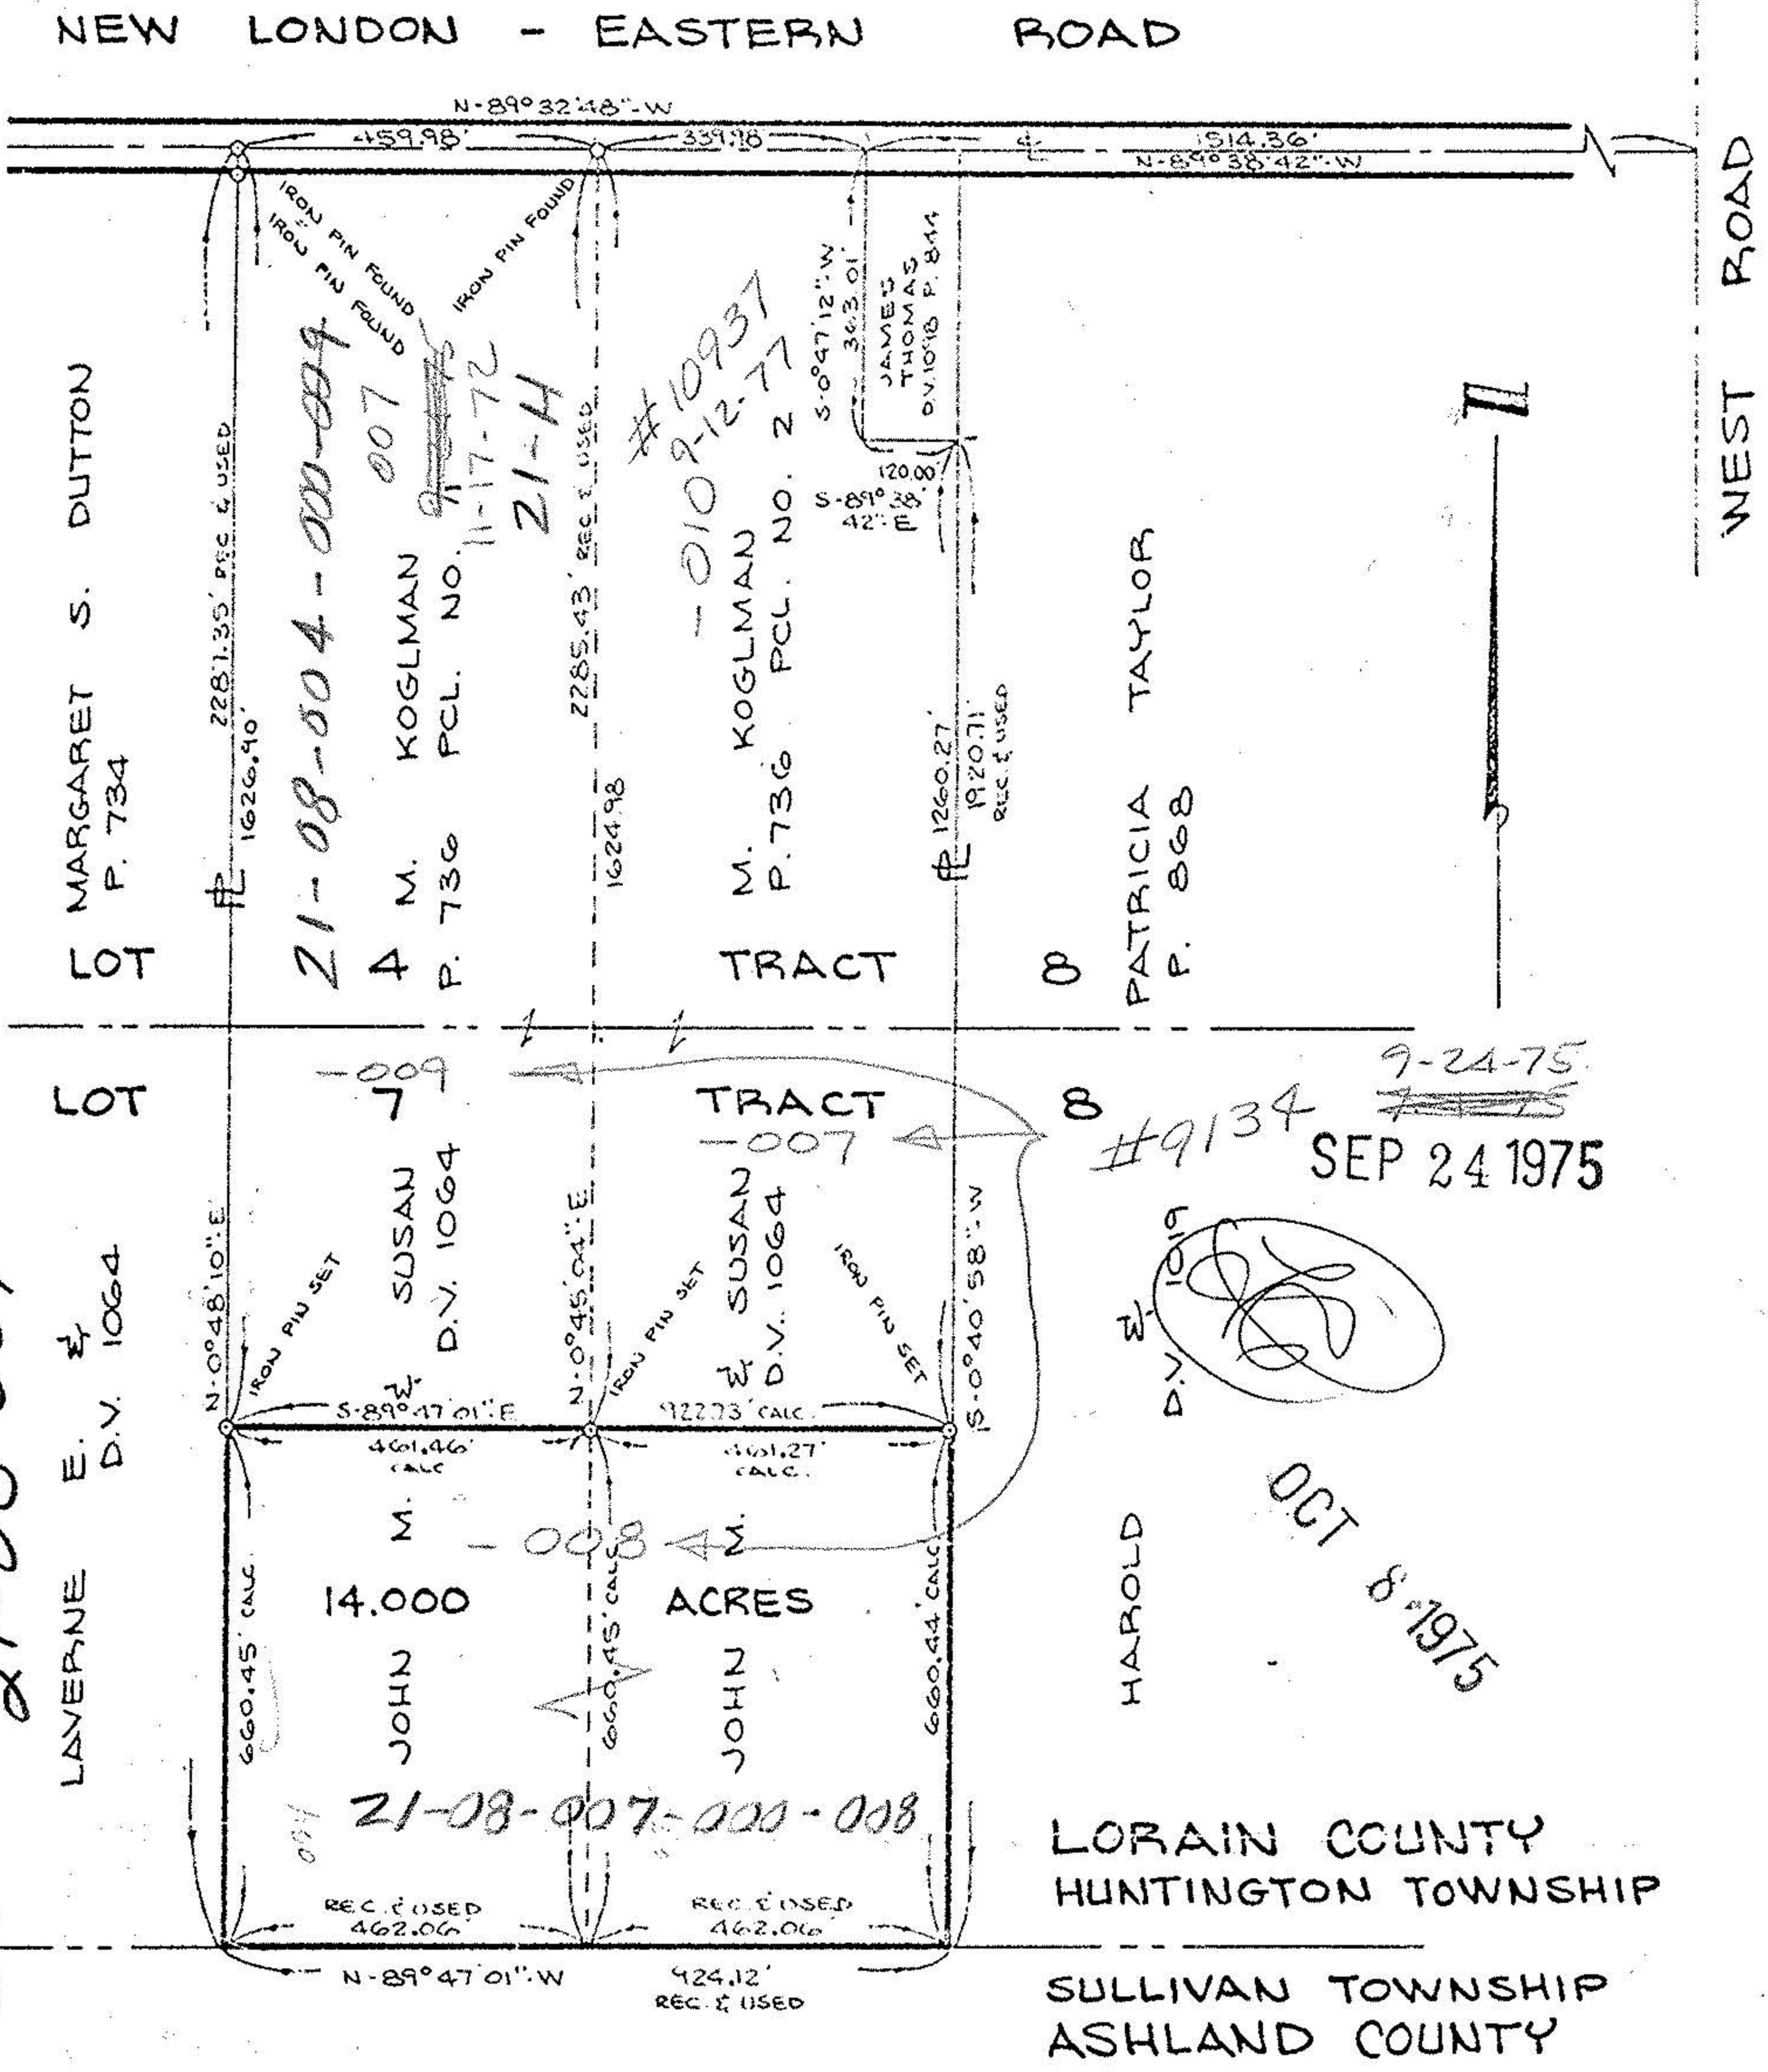

Prepared for:

079