
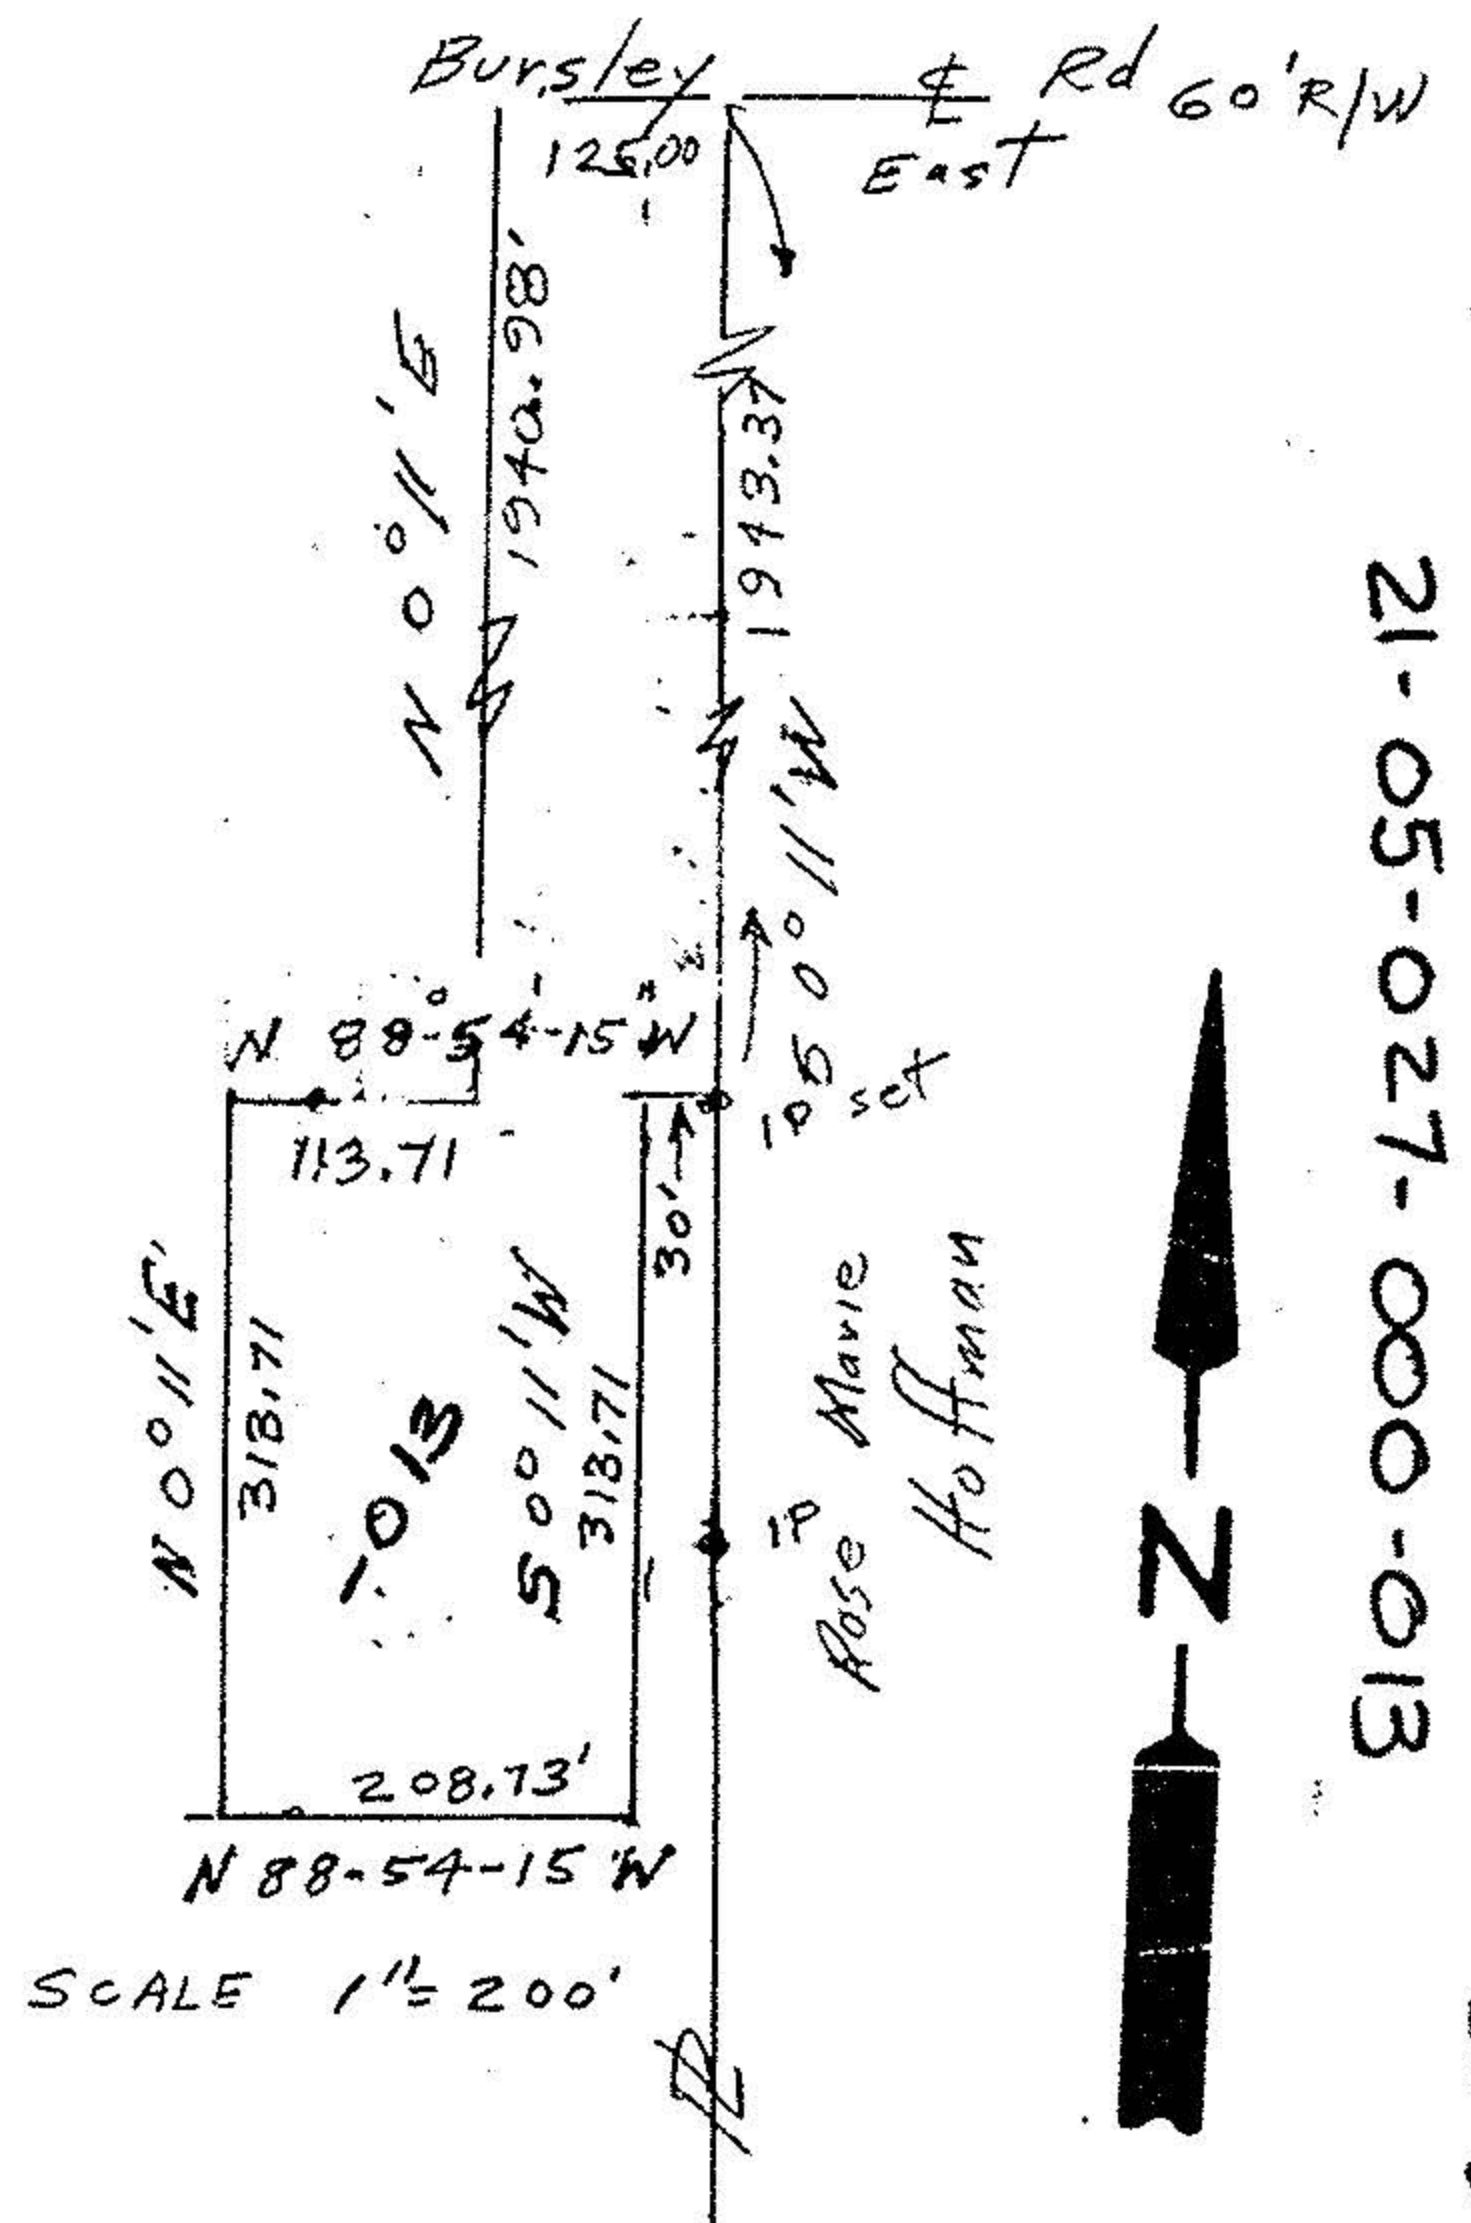


21-A

#18806


21-05-027-000-013

21-05-027-000-013

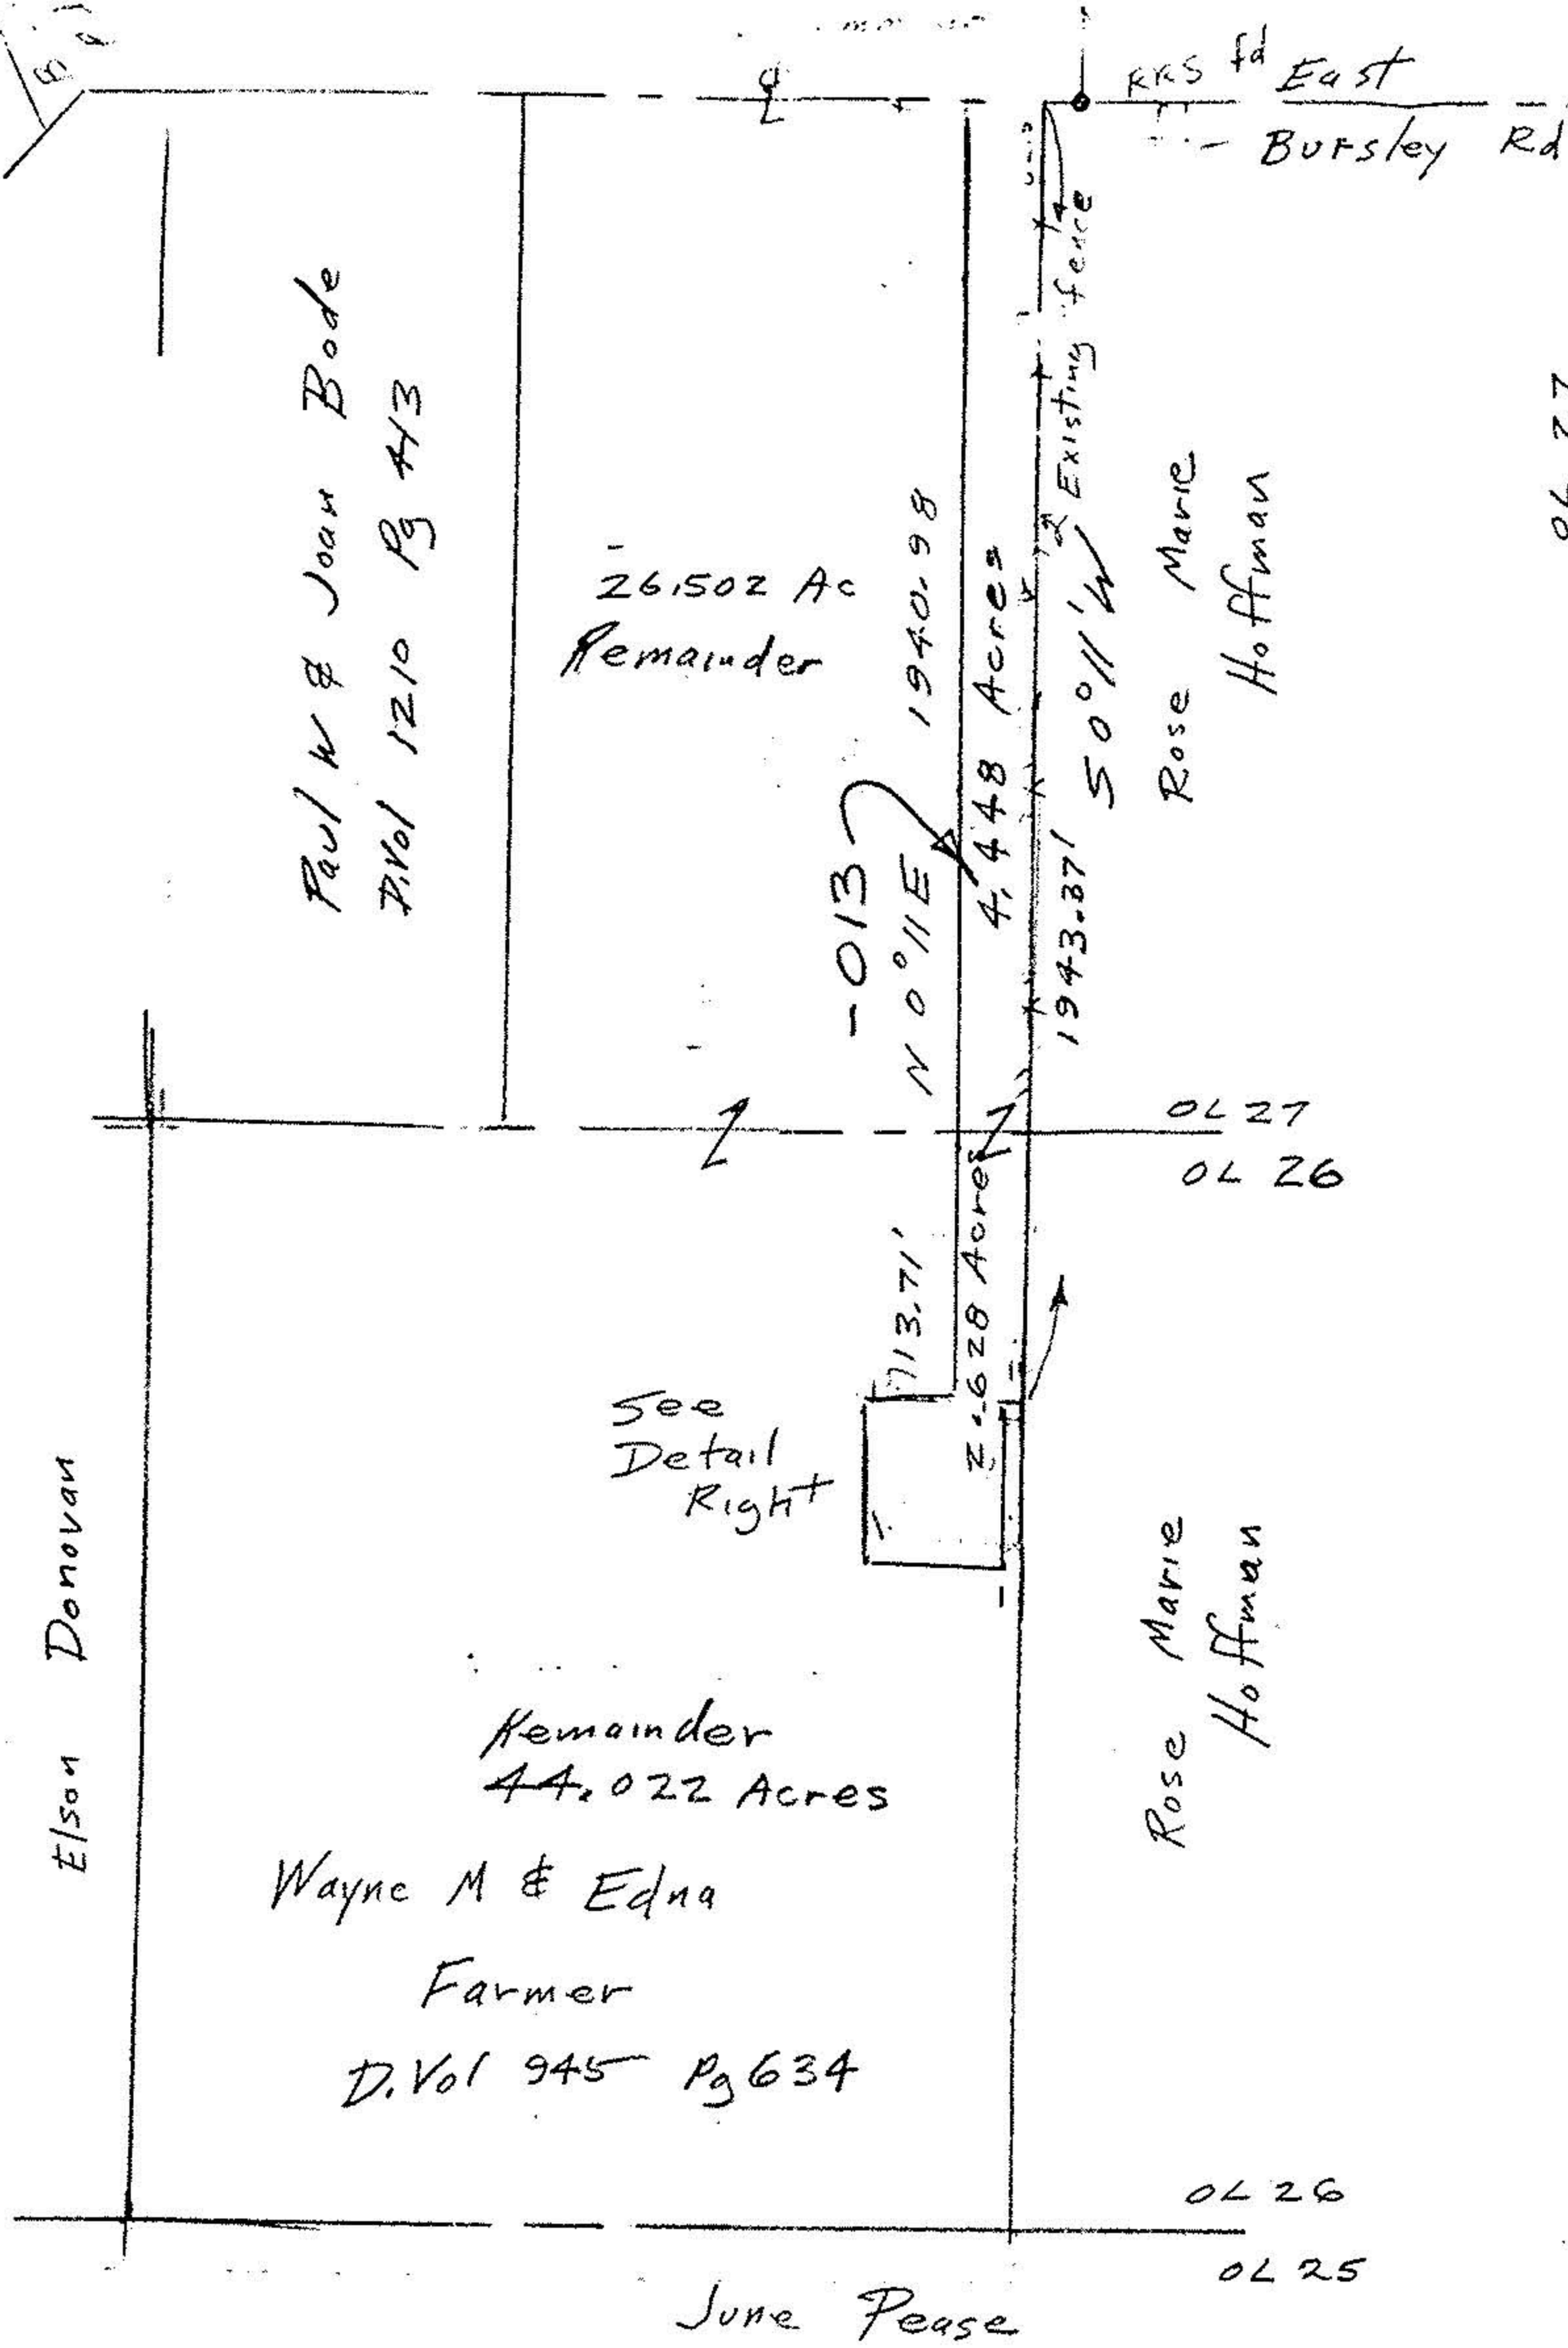

0L 27	4.448 Acres
0L 26	2.628 Acres
Total	7.076 Acres

#1880

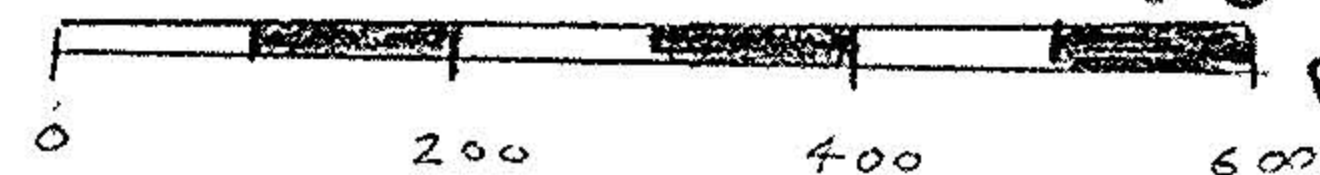

John Poznywak  
Reg Surveyor  
#5292

Revised 9/13/89  
208.71 to 312.71  
9/25/89

Parcel split survey  
for  
Wayne Farmer  
Original Lot 26 Tract 5  
Huntington Township

APPROVED LORAIN CO. MAP DEPT.
DATE 1-9-90
PAGE 21-A
CAROLYN BY FRANCIS
VOID