


21-05-029-000

Walter Lavandasky

21-05-029
21-A

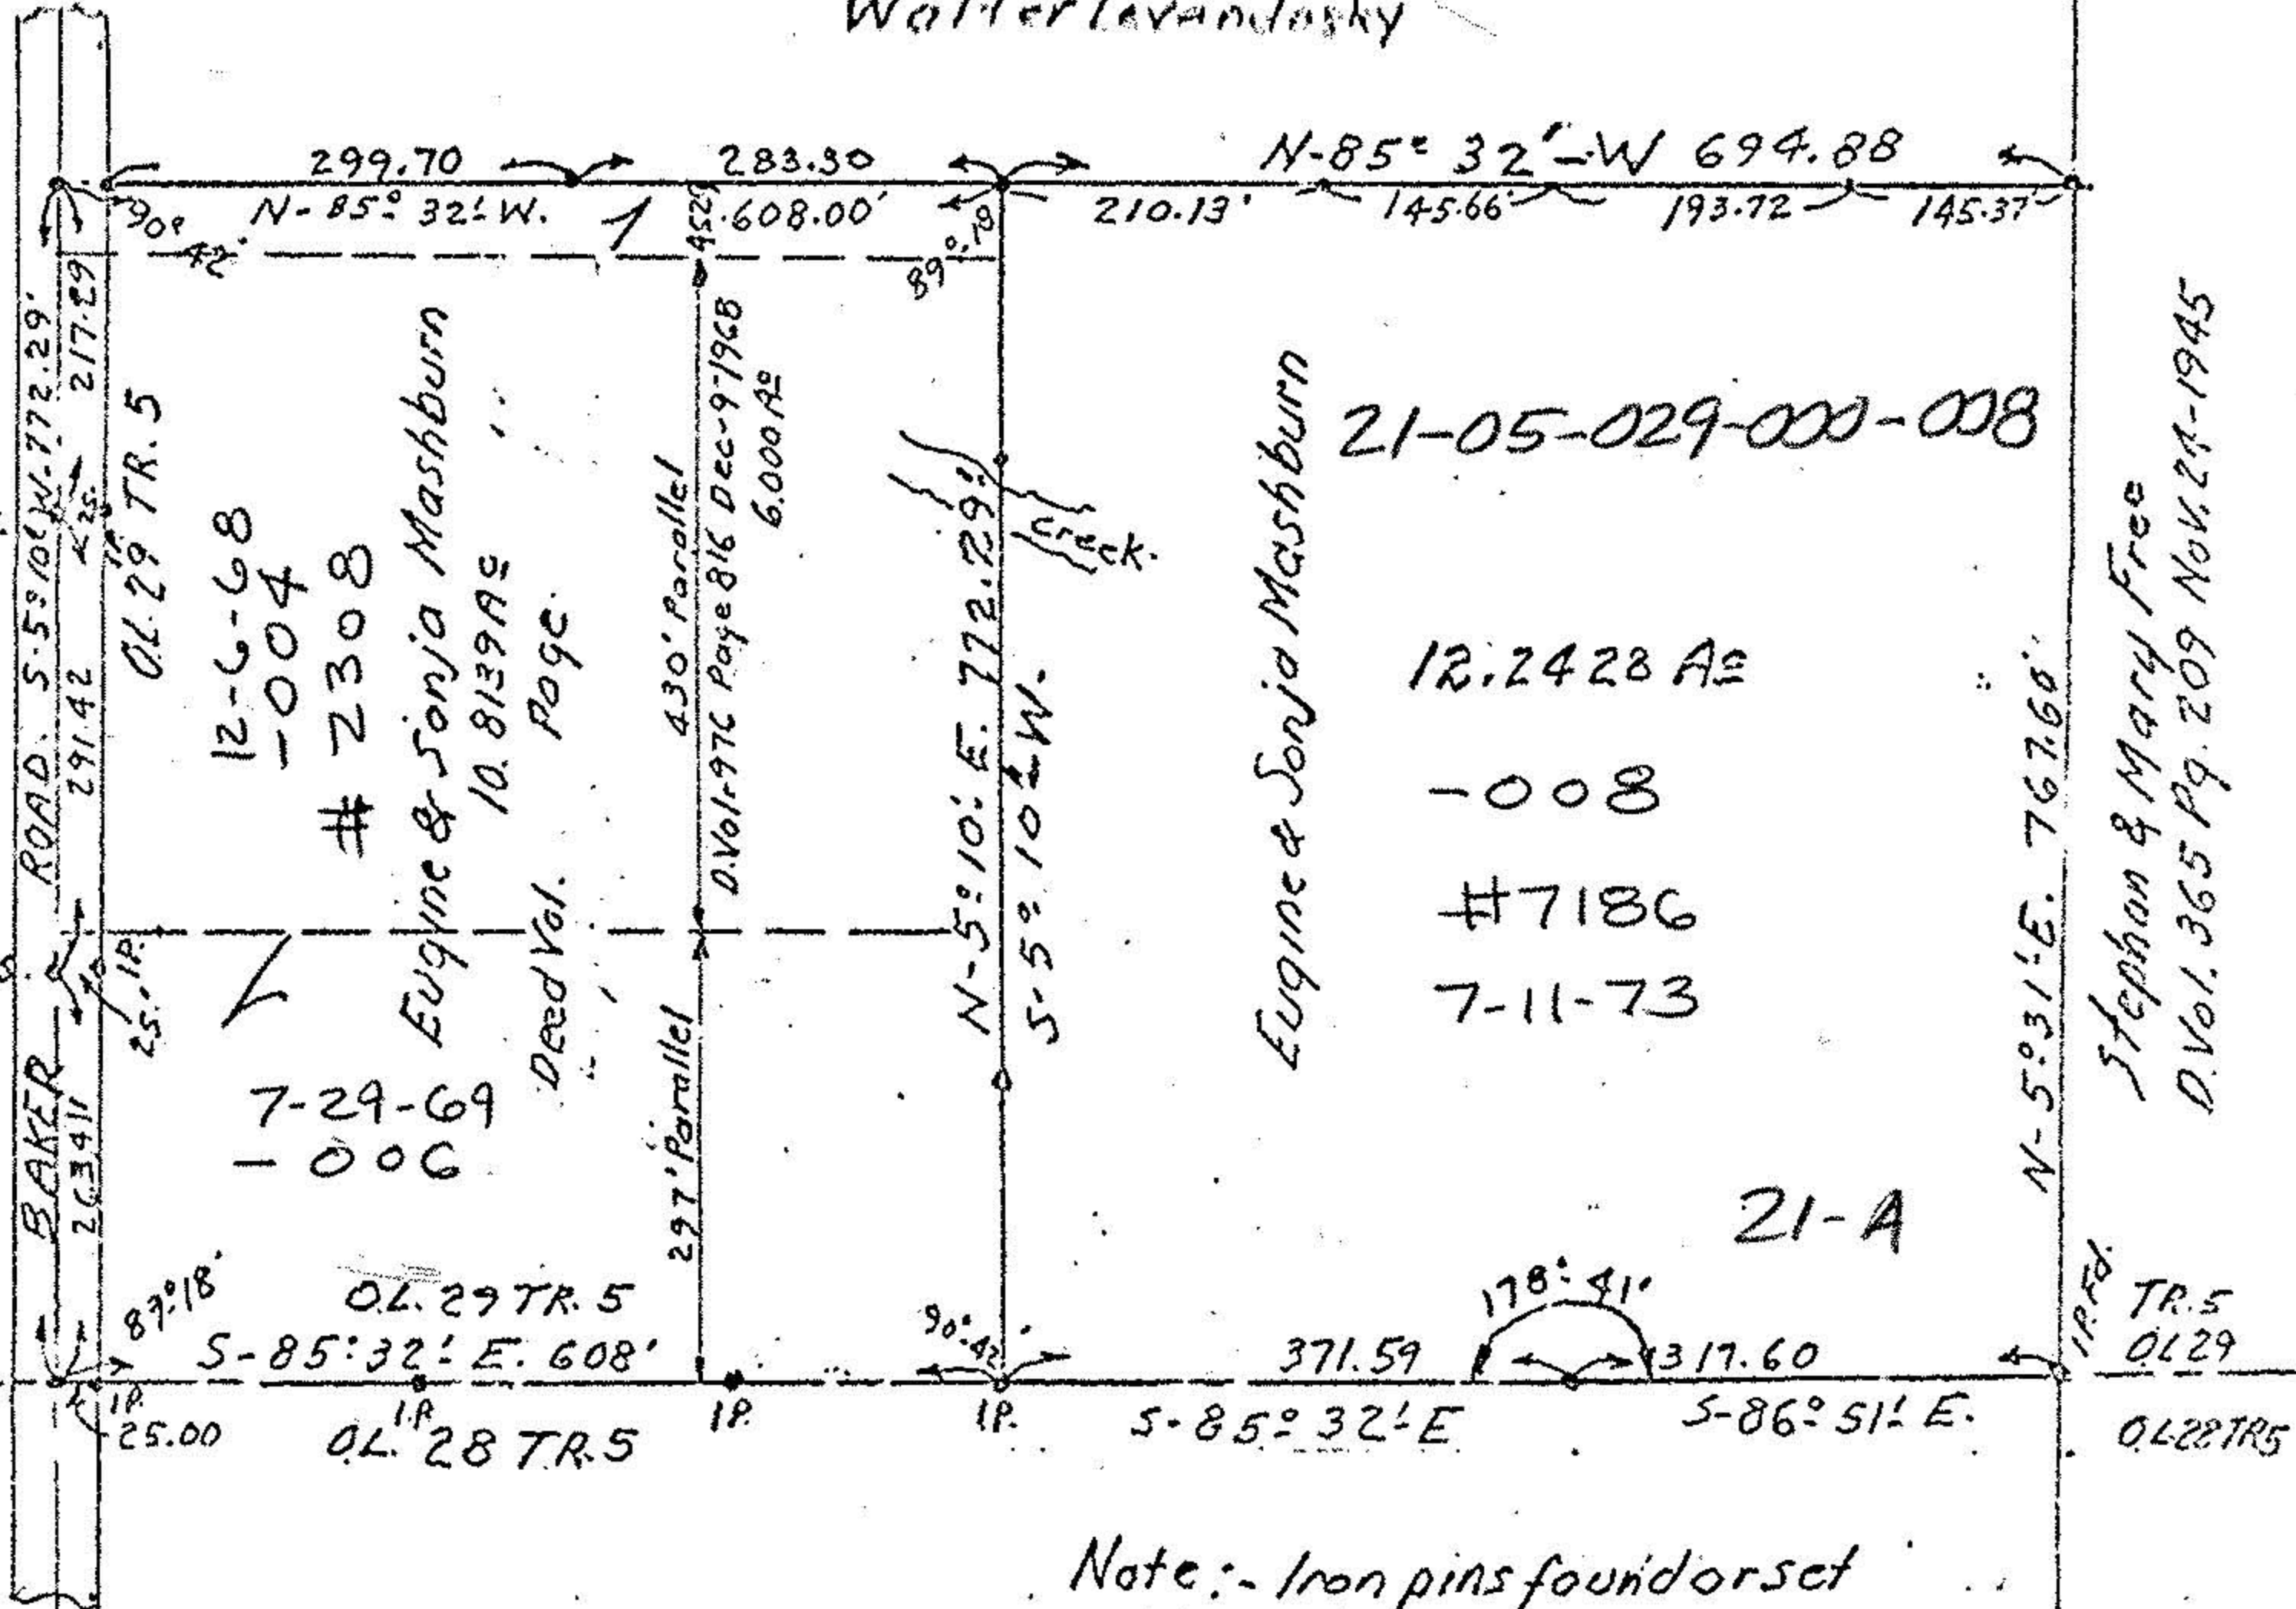

Note:- Iron pins found or set shown thus.

MAP OF SURVEY FOR EUGINE & SONJA MASHBURN
 12.2429 ACRES ORIGINAL LOT 29 TRACT 5
 HUNTINGTON TOWNSHIP - LORAIN COUNTY OHIO
 SCALE 1" = 200' APRIL 14 - 1973
 C.E. Penfound Registered Surveyor No 3200

Stephan & Mary Free
 D. Vol. 365 Pg. 209 Nov. 21 - 1945

OSD