


PLAT OF SURVEYS FOR
MRS. VIOLA HODGKIN

ORIGINAL LOT NO. 29 - TRACT NO. 5
HUNTINGTON TWP. - LORAIN COUNTY, OHIO
SCALE: 1"=100' APRIL & MAY - 1978
GARY E. PENFOUND Reg. Surveyor No. 4957


Stephen & Mary Free D. Vol. 345 Pg. 209

Notes: 0 indicates iron pin found.
• indicates iron pin set.

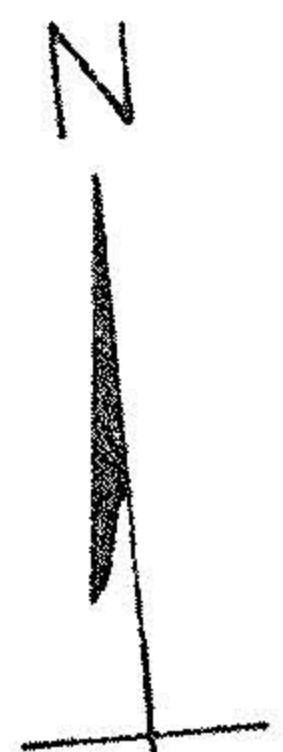

19811

APPROVED	LORAIN CO.
MAP DEPT.	
DATE	3-5-92
PAGE	ZI-A
BY	CAROLYN
VOID AFTER	# 19811

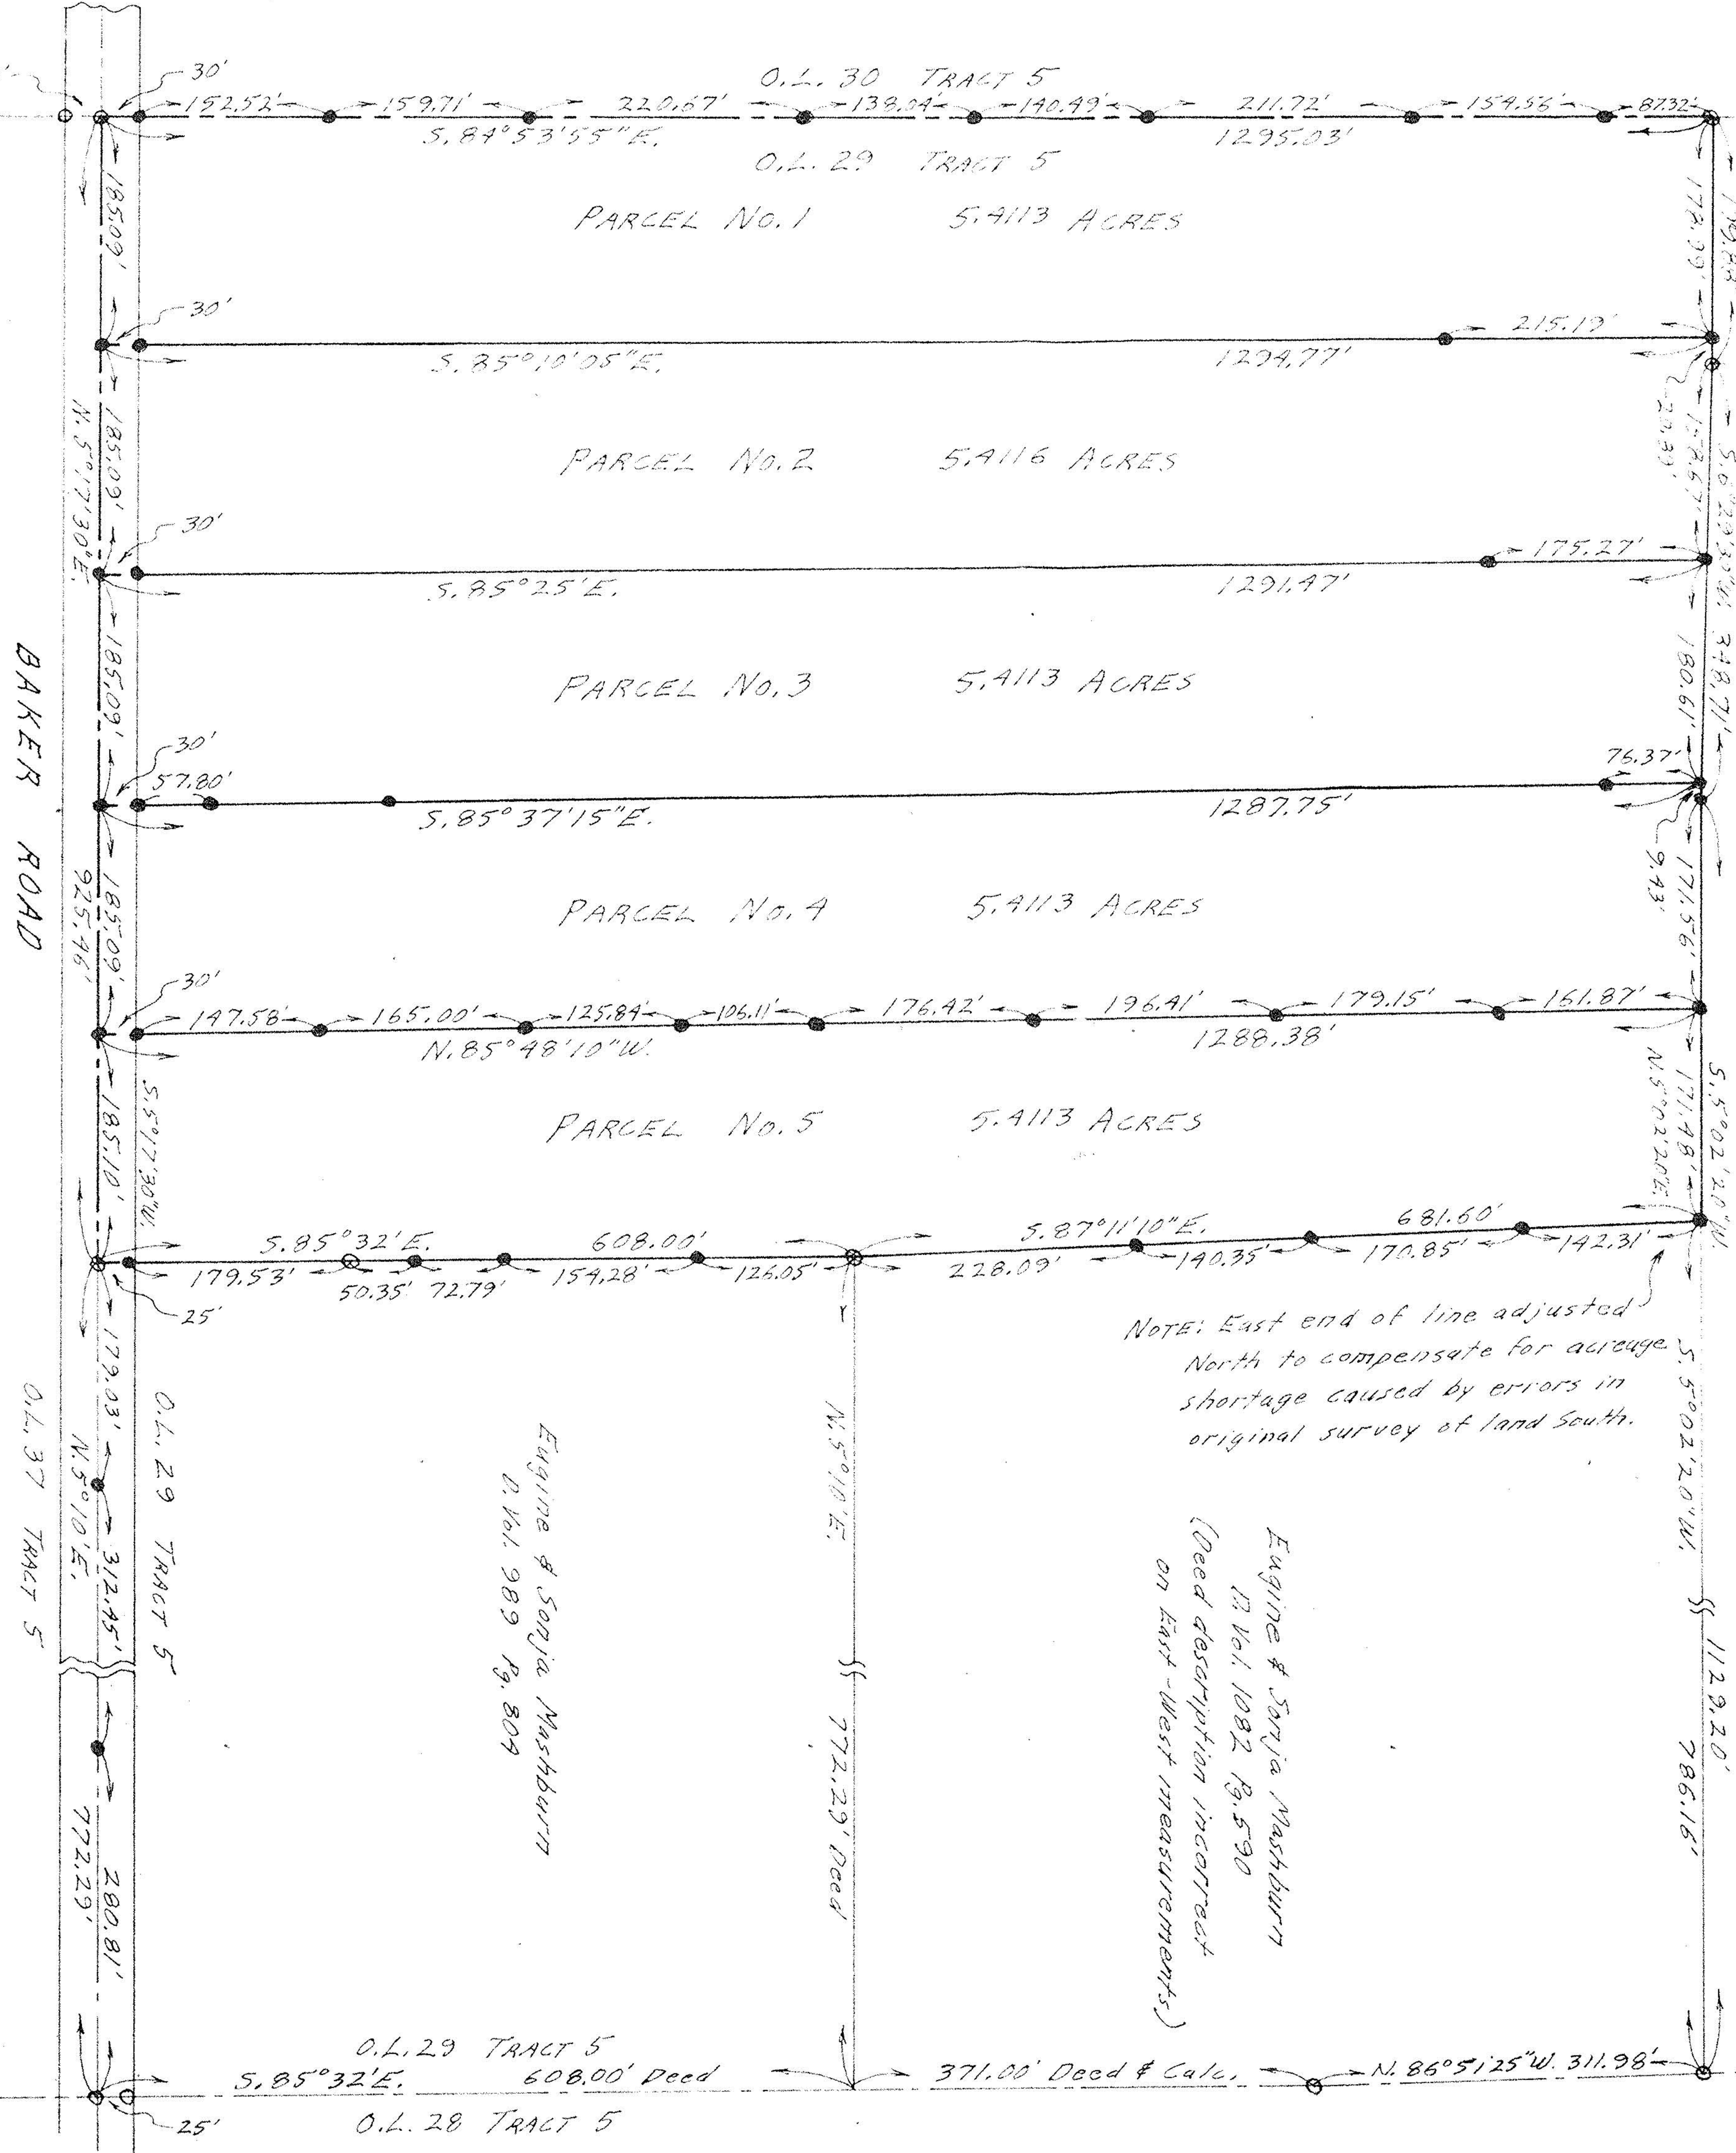

NOTE: East end of line adjusted North to compensate for acreage shortage caused by errors in original survey of land South.

Engine & Sonja Mashburn
D. Vol. 1082 Pg. 590
(Deed description incorrect on East-West measurements)

Engine & Sonja Mashburn
D. Vol. 989 Pg. 809