


PLAT OF SURVEY FOR 3.3967 ACRE PARCEL  
 PART OF LOT 35, TRACT 5, TWP. 2-N, RANGE 18-W,  
 HUNTINGTON TWP., COUNTY OF LORAIN  
 STATE OF OHIO

21-05-035-00

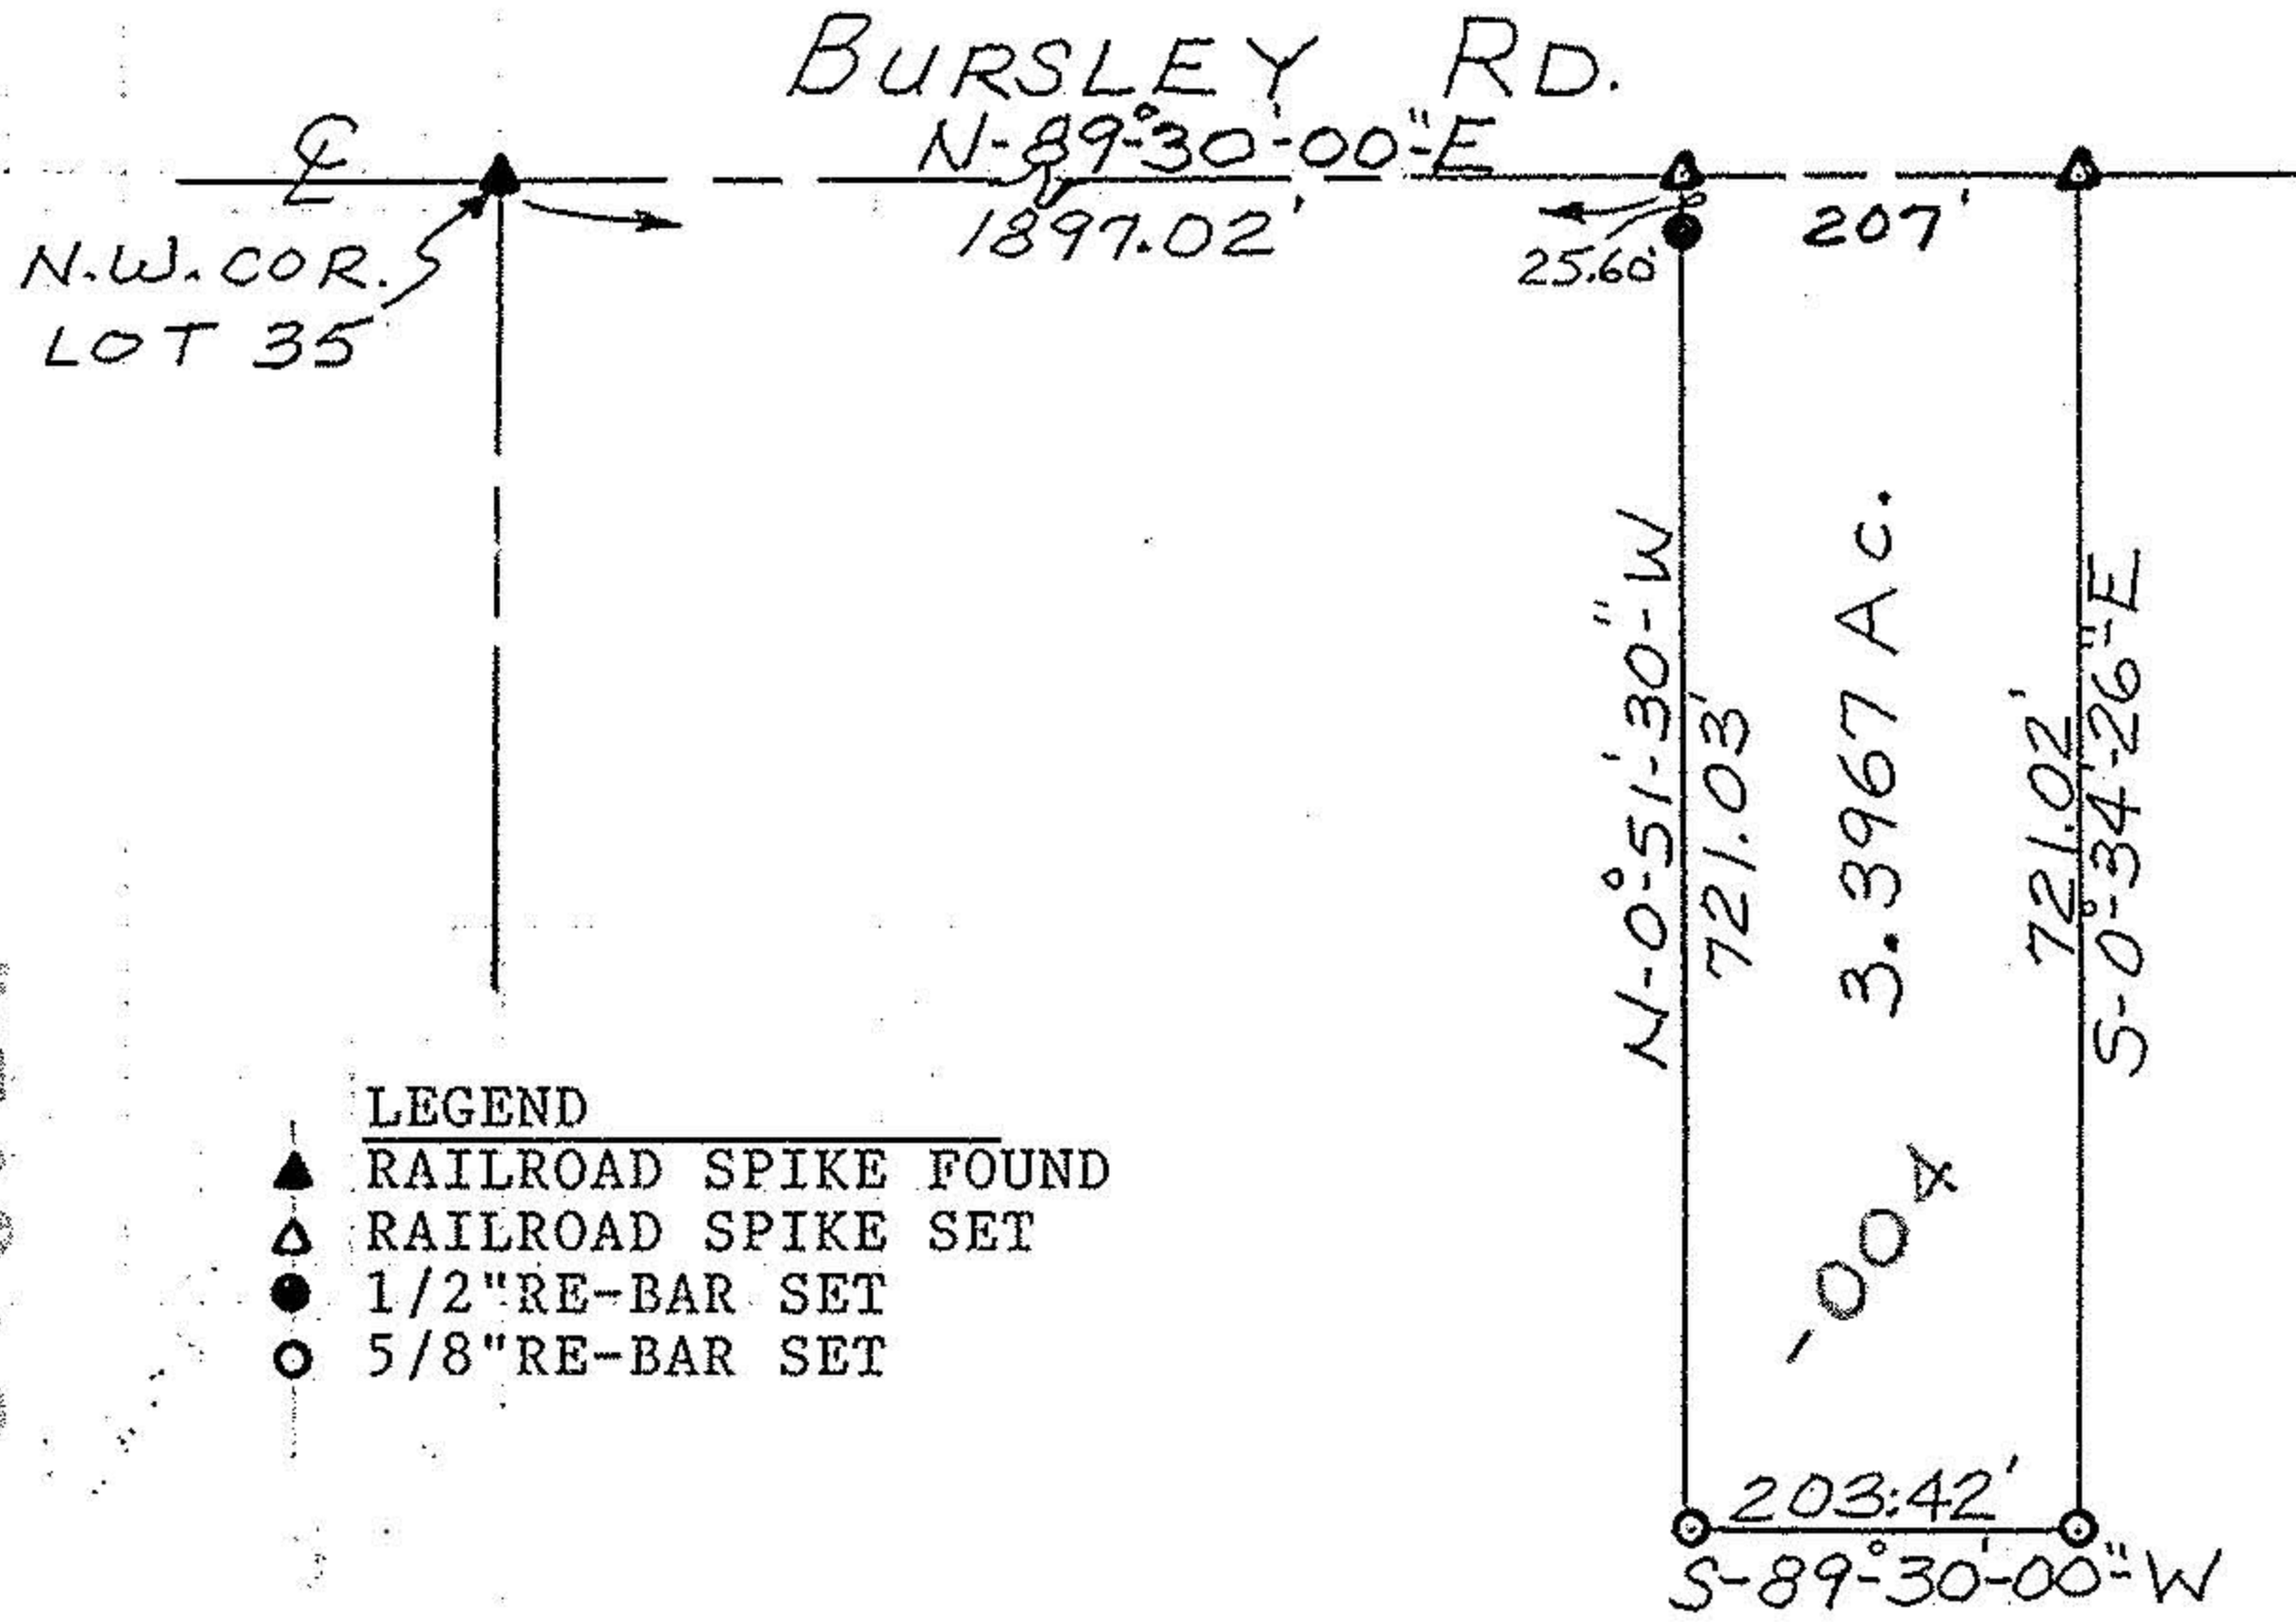

- LEGEND**
- ▲ RAILROAD SPIKE FOUND
  - △ RAILROAD SPIKE SET
  - 1/2" RE-BAR SET
  - 5/8" RE-BAR SET

All bearings are magnetic and are to be used for the determination of angles only.

Scale: 1"=200'

17978

APPROVED	
LORAIN CO.	
MAP DEPT.	
DATE	6-8-88
PAGE	21-A
BY	Carol Francis
VOID AFTER	# 17978

*William L. Fox*  
 William L. Fox, P.S.  
 Registered Surveyor No. 5878



Job No, 1882 May 1988

21-05-035-000  
 21-A  
 600-230-20-15  
 91-02-032-000-001  
 600-000-230-20-16

A-15

(360)