

MON BOX QUARRY RD

CRIGGS RD 60'

BAKER RD

SURVEY
OF PART OF
ORIGINAL HUNTINGTON TWP.
LOT 39 TRACT 5
COUNTY OF LORAIN STATE OF OHIO


#22486

APPROVED
LORAIN CO.
MAP DEPT
DATE 3/30/98
PAGE 21-A
BY K. Colbert


Rem.
-017

PREPARED FOR:
ROSS SPRINKLE
48140 GRIGGS RD.
WELLINGTON, OH.

PREPARED BY
HAPONEK & ASSOC
SURVEYORS
N. RIDGEVILLE, OH.

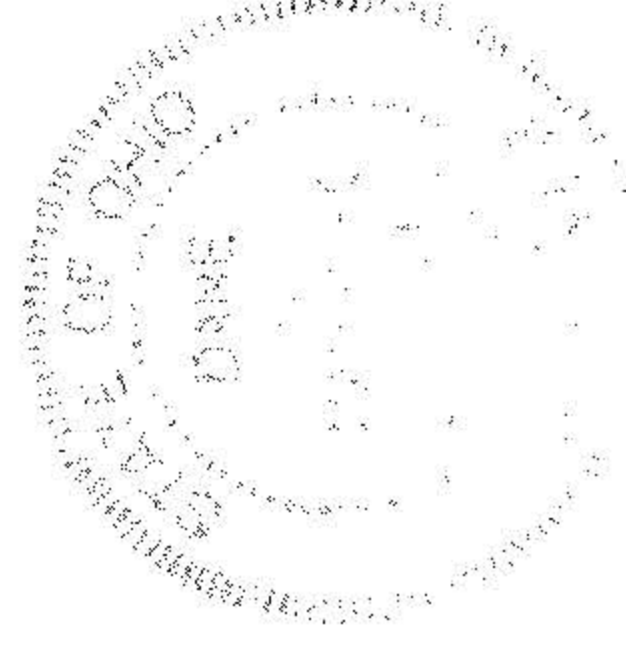

DATE: FEB 1998
SCALE: 1"=100'

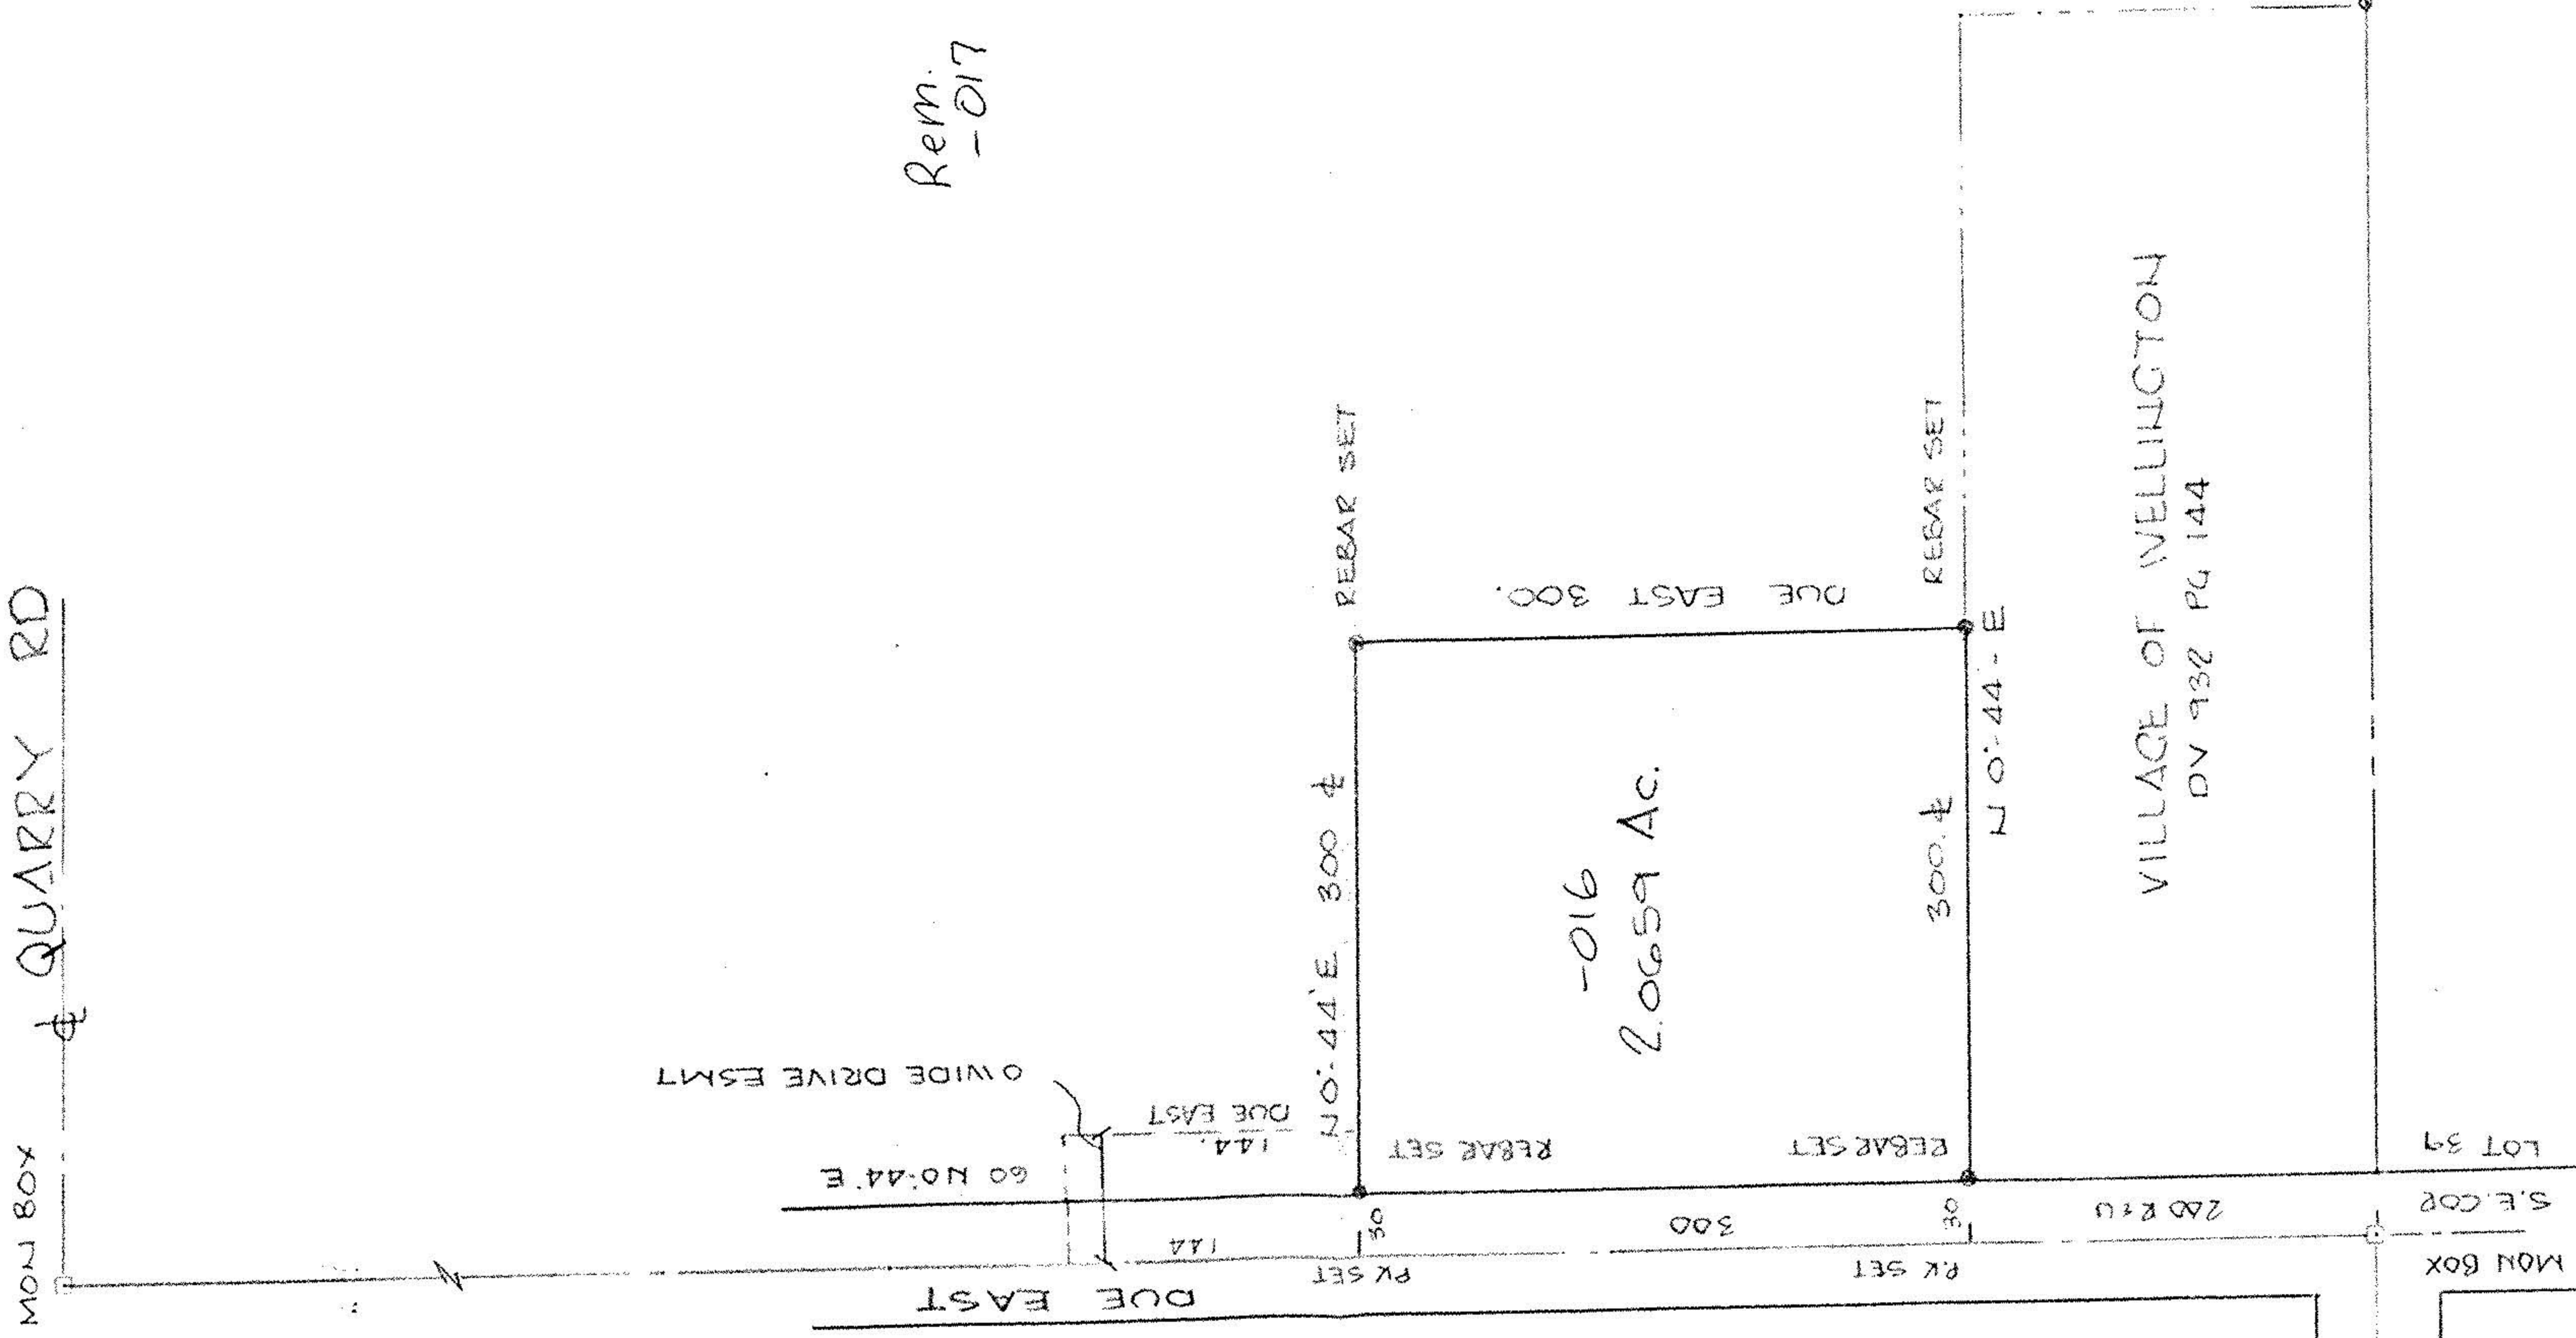

LOT 40
REBAR SET FOR OCCUPATION N 85
WIRE FENCE FO 4.50 FT W.
LOT 32

LOT 39
WIRE FENCE FO 3.30 FT W.
LOT 31