


21-06-000-A

#19255

21-06-000-000

PLAT OF SURVEY
FOR RODNEY & JOAN EATON
PART OF TRACT 6, HUNTINGTON TOWNSHIP
LORAIN COUNTY, OHIO

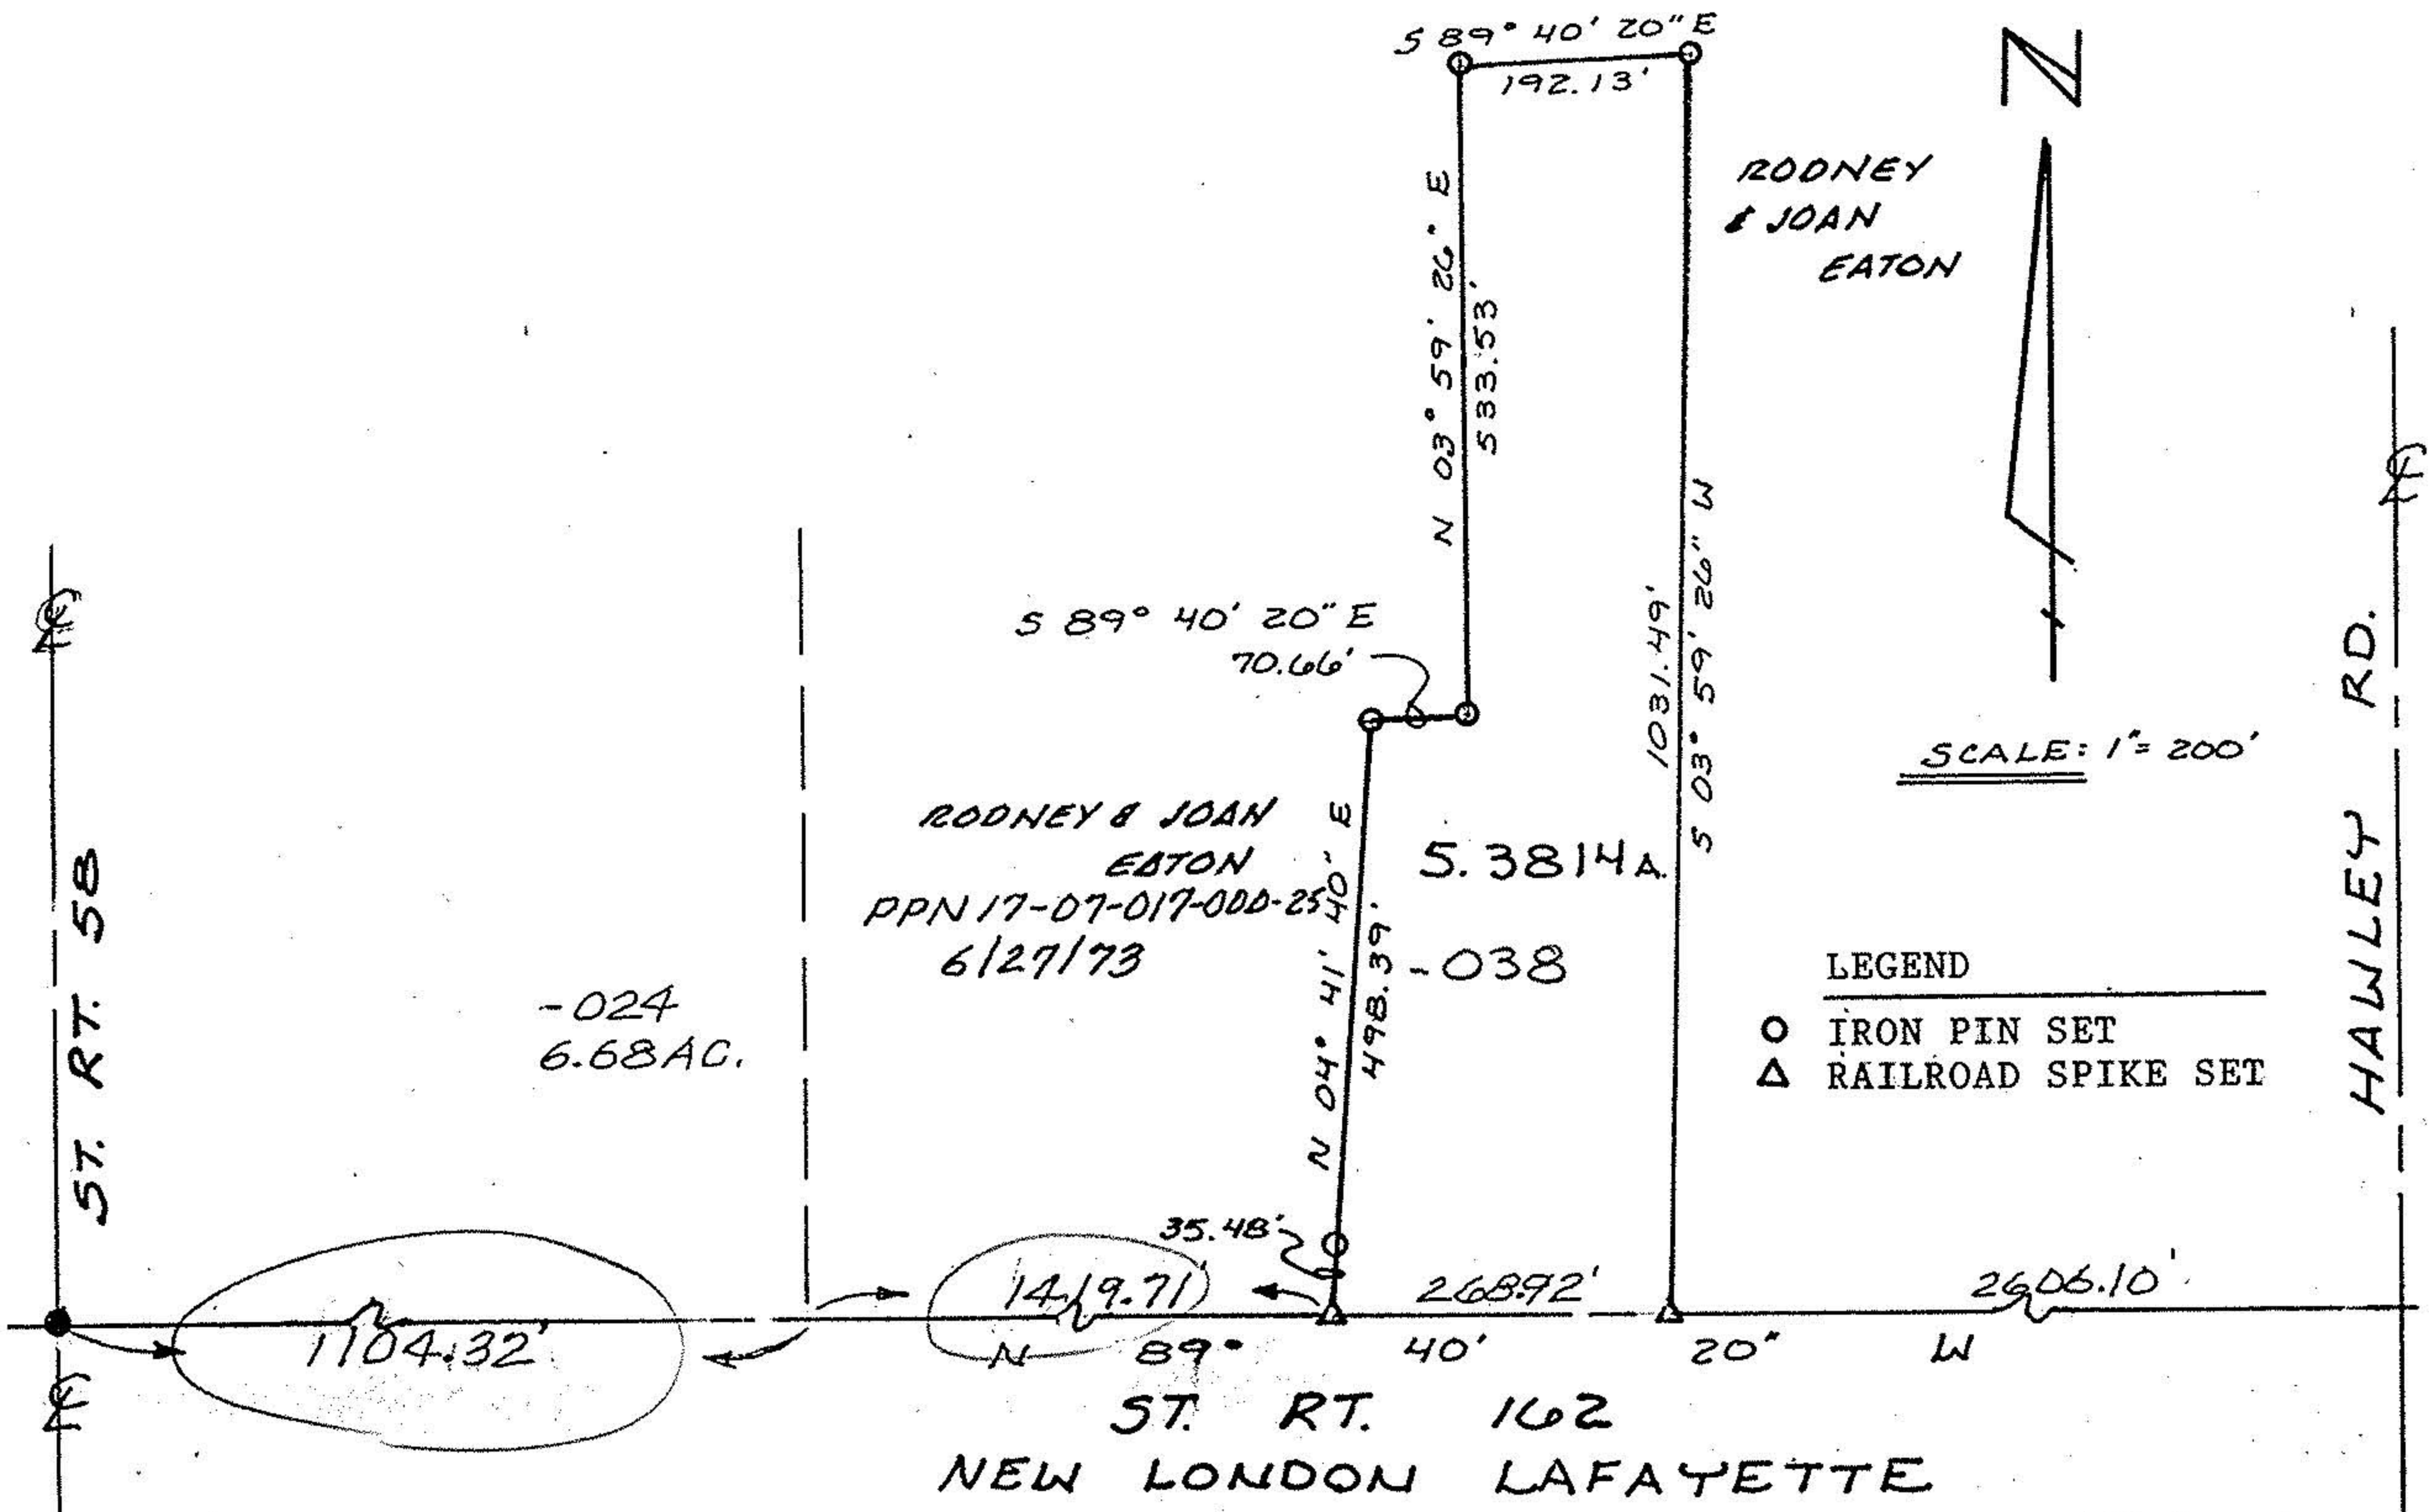

William L. Fox
William L. Fox, P.S.
Registered Surveyor #5878



All bearings are magnetic and are to be used for the determination of angles only.

190