


21-06-000-000

#19255

21-06-000-A

PLAT OF SURVEY

FOR RODNEY & JOAN EATON
PART OF TRACT 6, HUNTINGTON TOWNSHIP
LORAIN COUNTY, OHIO

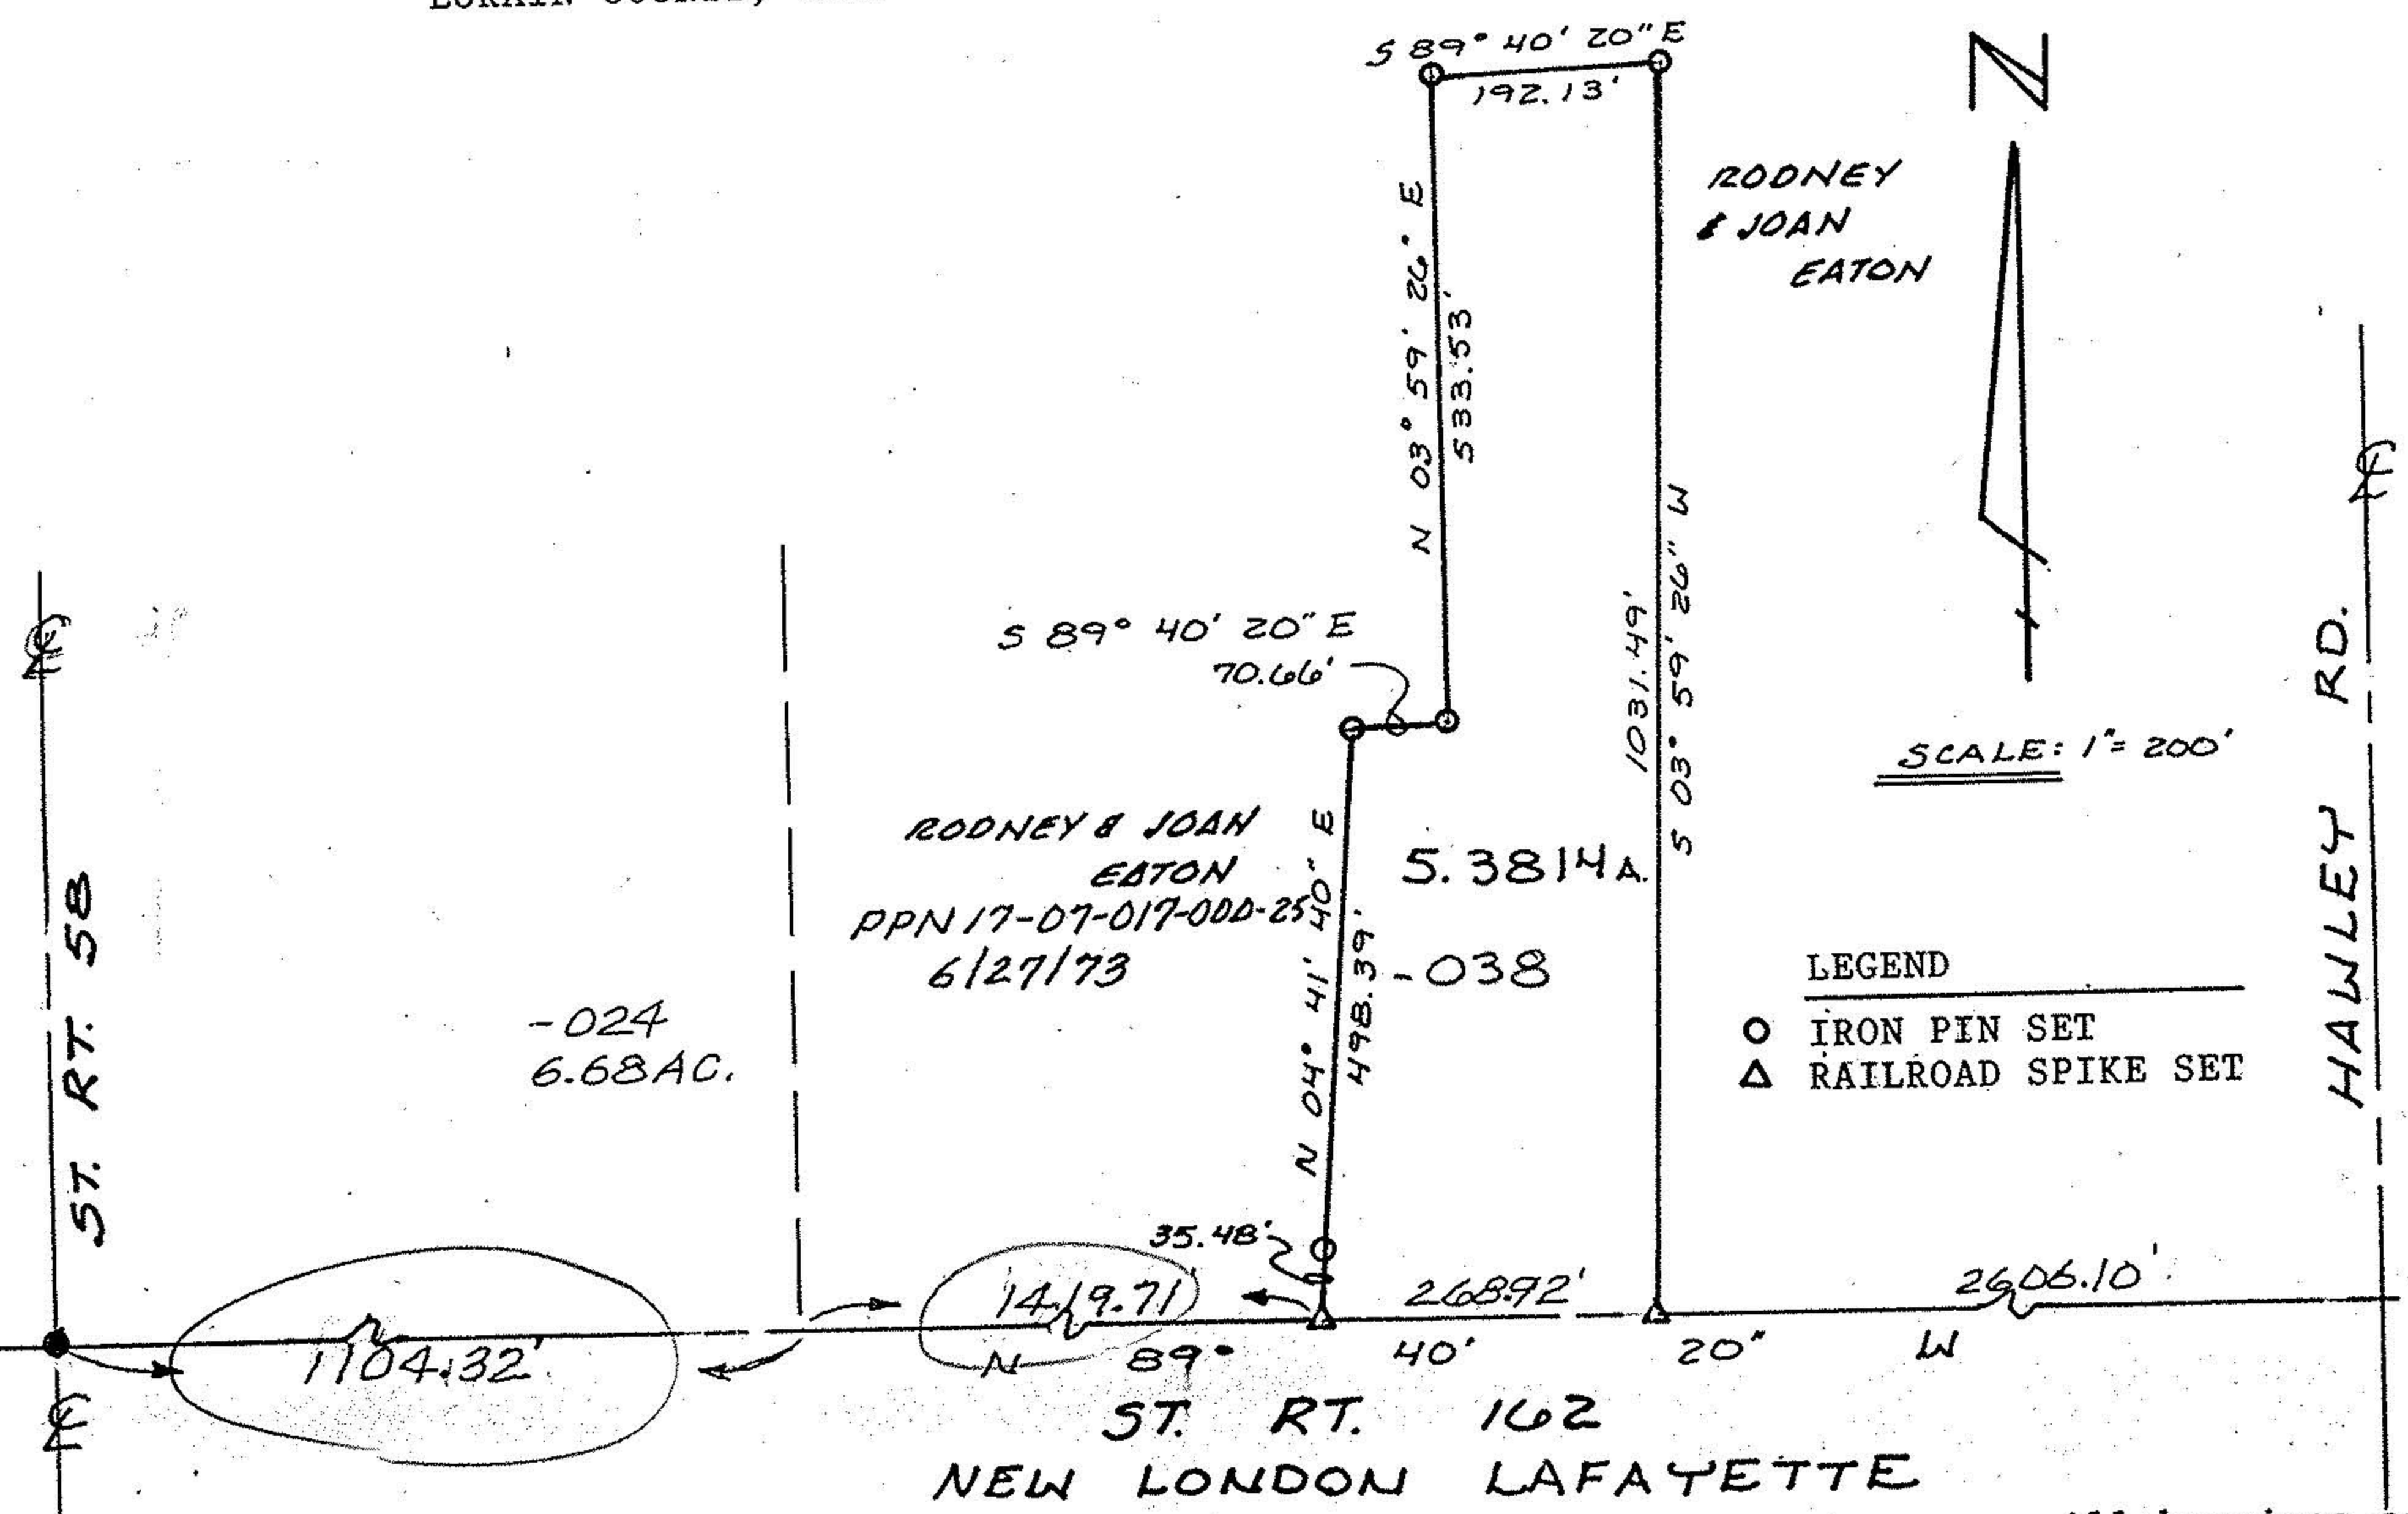

William L. Fox
William L. Fox, P.S.
Registered Surveyor #5878



All bearings are magnetic and are to be used for the determination of angles only.

JOB NO. 118652