

# PLAT OF SURVEY

Boundary and Subdivision Survey for  
 Dave McMillan  
 Part of Tract No. 12  
 Huntington Twp. Lorain County, Ohio  
 Date of Survey: March 1997

Nathan Orchard 6-16-97  
 NATHAN ORCHARD P.S. DATE  
 P.S. # 7461




CONTACT  
 TOM JONES FOR ANY  
 DESCRIPTION REV.  
 (330) 723-9559  
 PER CALL 12/1/98

NOTE:  
 ORIGINAL McMILLAN PARCEL NUMBER: 21-12-000-000-051  
 TOTAL ACREAGE OF THE McMILLAN PROPERTY, PRIOR TO  
 SUBDIVISION = 122.270 ACRES


### Legend

- IRON PIN/PIPE FOUND
- FENCE POST FOUND
- EXISTING PROPERTY LINE
- 5/8"X30" REBAR STAMPED "ORCHARD #7461" SET
- PROPOSED PROPERTY LINE
- APPROXIMATE GAS LINE

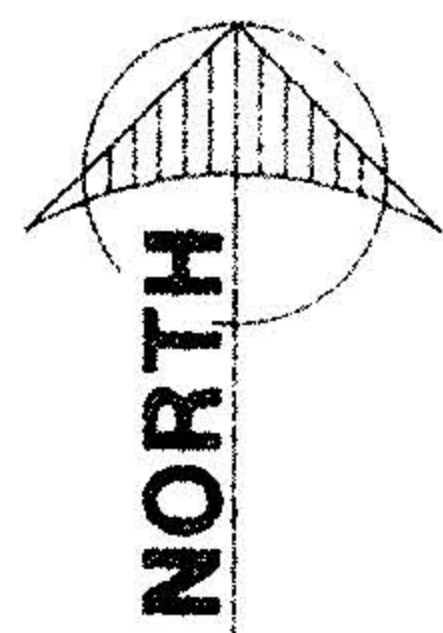

0 50 100 200  
 SCALE 1" = 200'

ALL BEARINGS ARE DERIVED  
 FROM AN ASSUMED MERIDIAN  
 AND ARE USED TO DENOTE  
 ANGLES ONLY

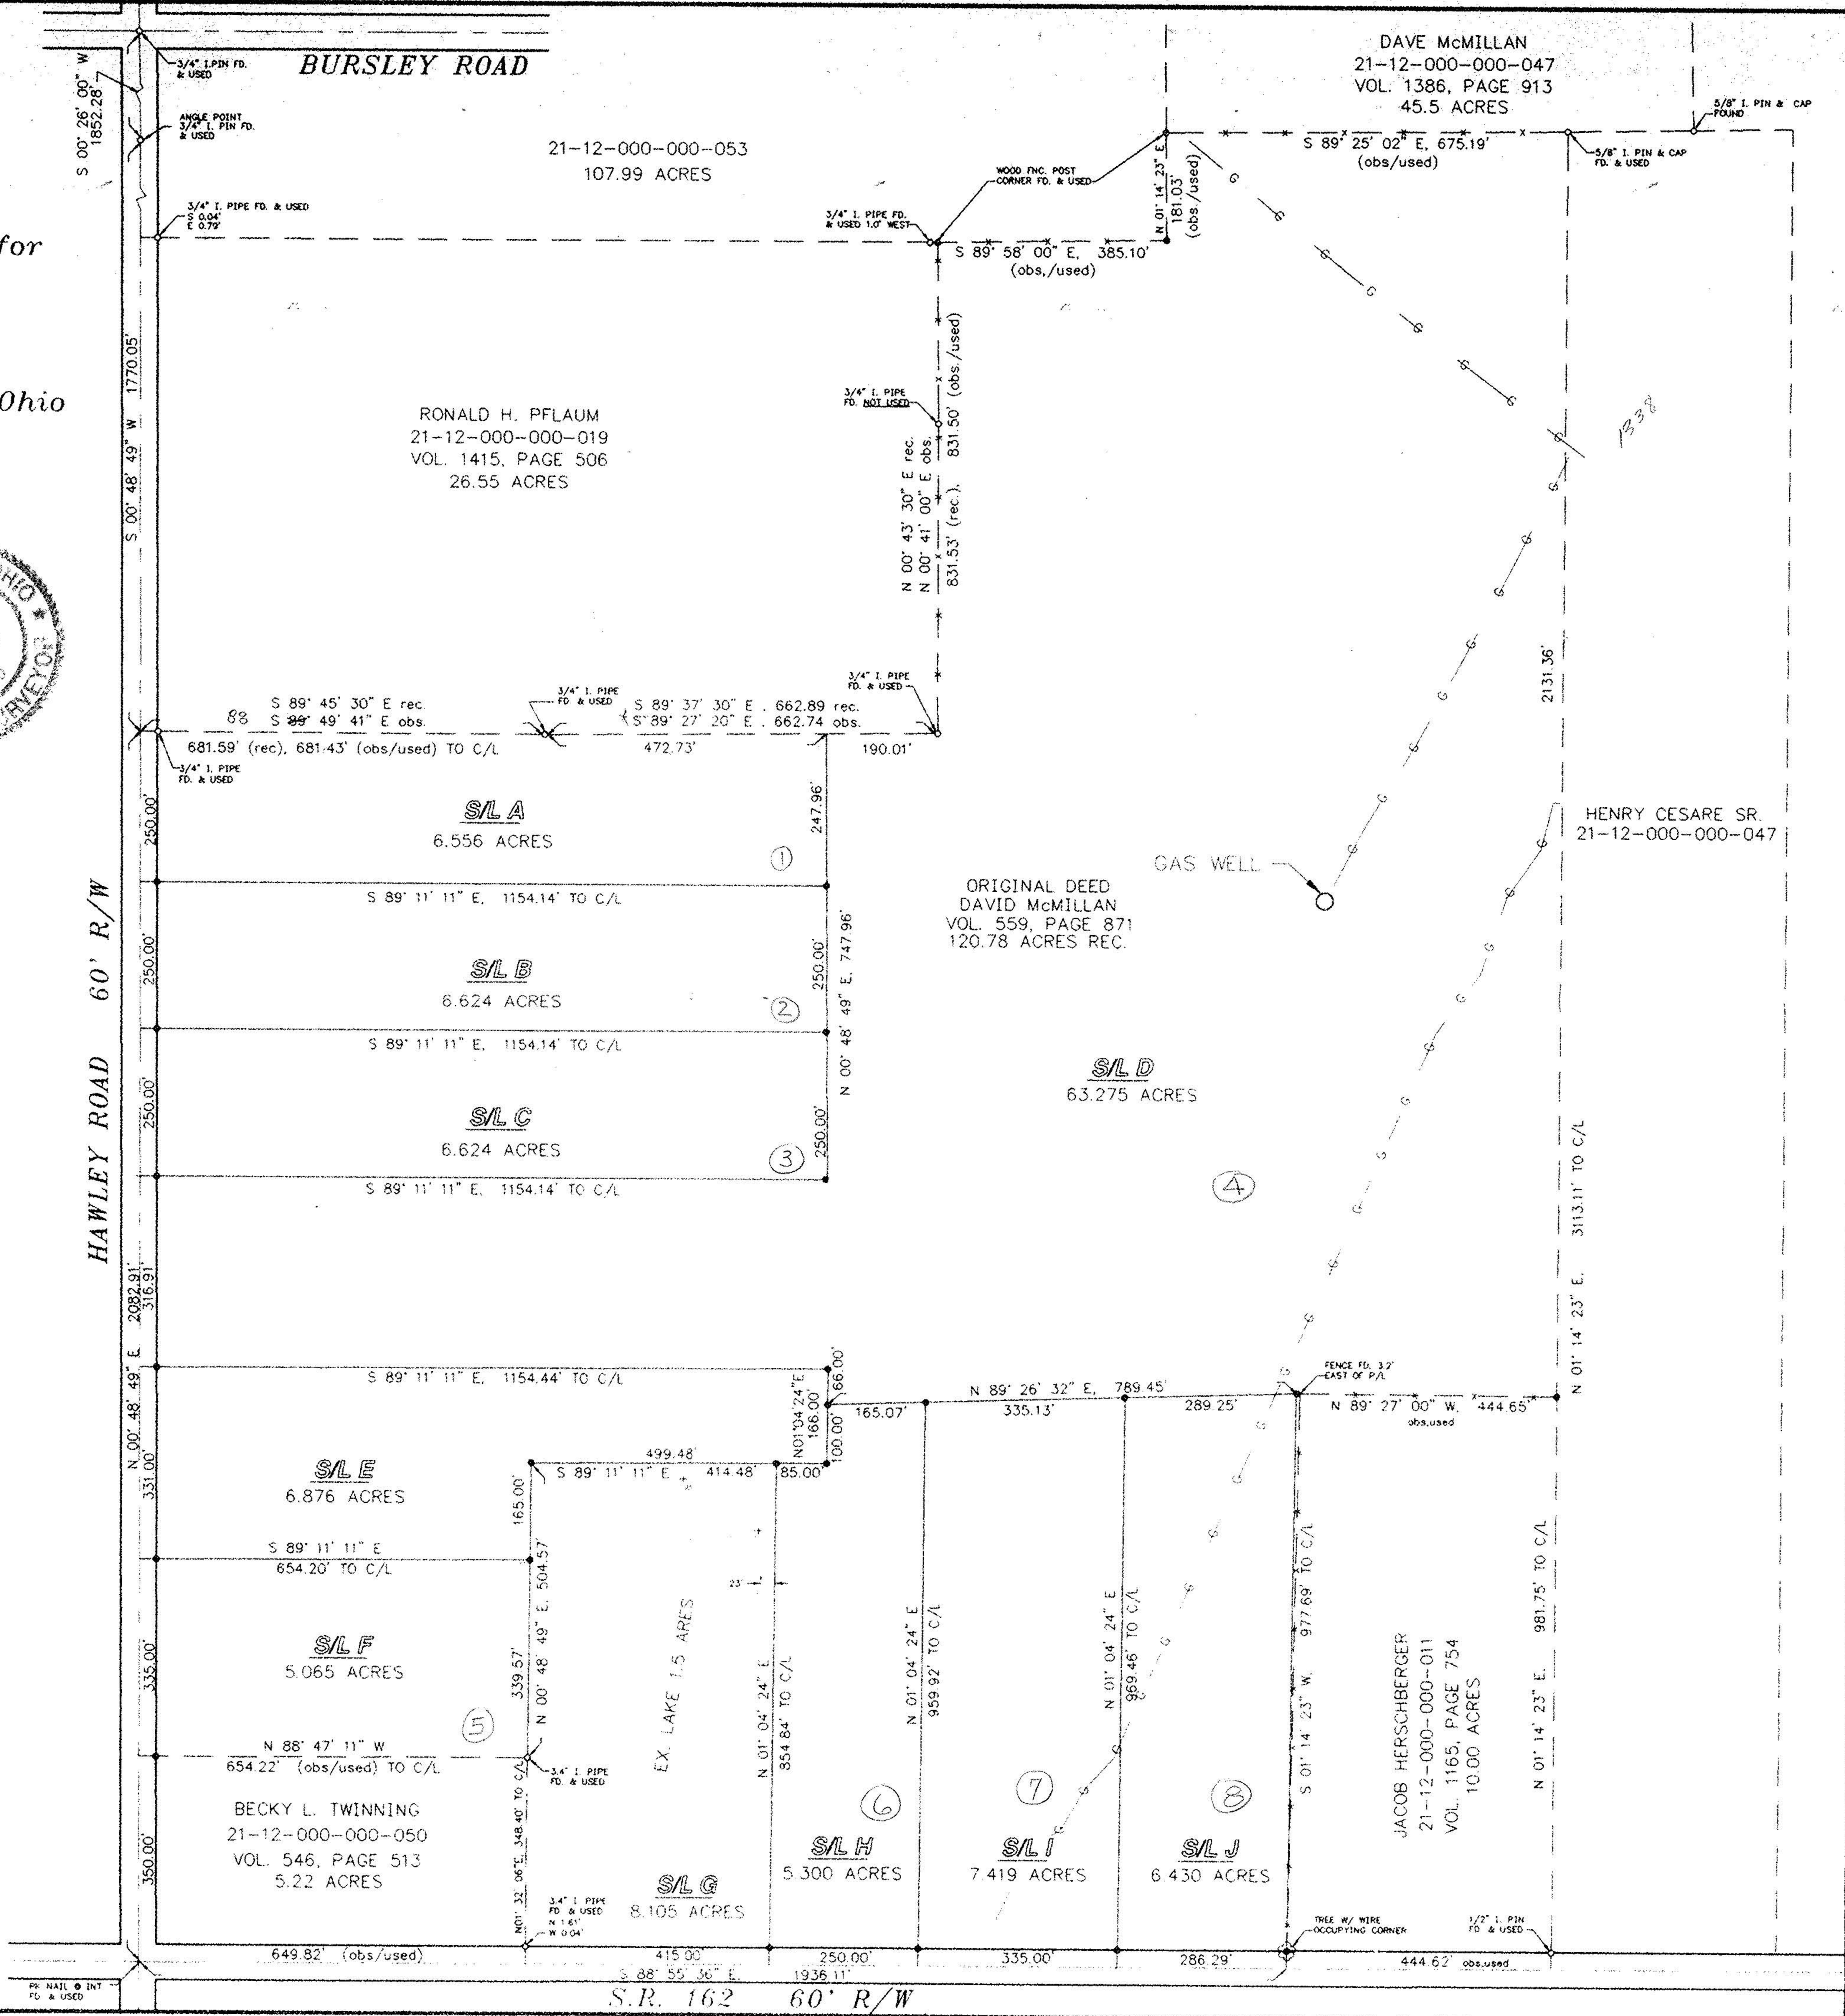

**ENGINEERS · SURVEYORS**  
 PHONE: 330-725-8977  
 FAX: 330-725-1451

**J&L ENGINEERING**  
 4702 PARADISE RD.  
 SEVILLE, OHIO 44273

**DAVE McMILLAN SURVEY**  
 SUBDIVISION PLAT

JOB NO. S97002  
 DRAWN BY TBUT  
 CHECKED BY N.O.  
 SHEET NO. 1 of 1