


01-00-017-000-076  
 01-00-017-000-192  
 1-00-017-A

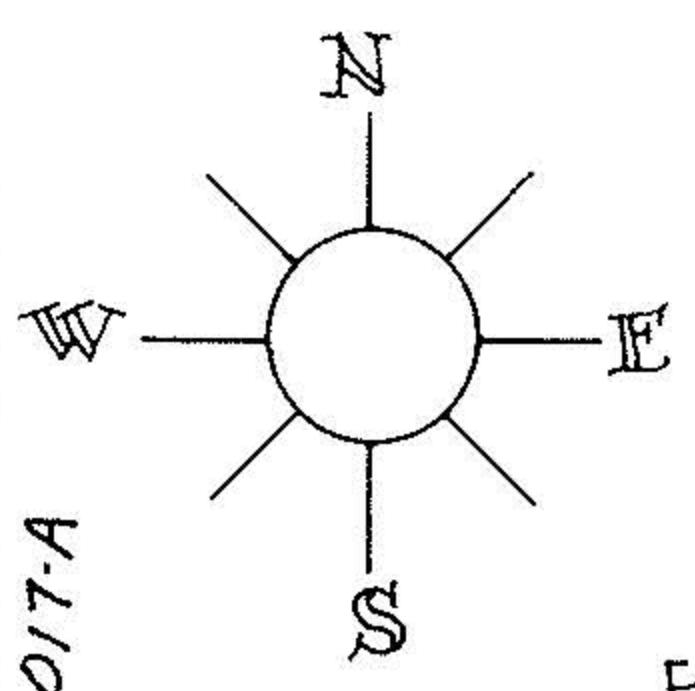

CENTERLINE OF DITCH  
 3 FT EAST OF SKLADAN  
 LINE AT THIS CORNER

EAST LINE OF ROLLING  
 MEADOWS SUBD'N N°1  
 S 2°23'00"E

589°37'00"E 91.07

WEST LINE OF  
 1980 PURCHASE  
 BY SKLADAN  
 BASED ON 1962  
 SURVEY OF R.E.  
 HOLLIS & INFO.  
 RECORDED IN PLAT  
 OF BIG OAKS SUBN #1  
 N 1°19'00"W

20-FT. DRAINAGE EASEMENT

DITCH  
 BOTTOM

589°37'00"E 85.88

CENTERLINE OF DITCH  
 3 FT. EAST OF SKLADAN  
 LINE AT THIS CORNER

-076  
 SKLADAN  
 RESIDENCE



NOTE INFORMATION CHECKED  
 ALONG MAPLE VIEW DRIVE TO  
 CENTER OF MONUMENT BOX LIDS,  
 NO MONUMENTS IN PART. CONSE-  
 QUENTLY WERE UNABLE TO  
 VERIFY ANGULAR MEASUREMENT.  
 CENTERLINE NOT TO SCALE.

SHITTY ENSEMBLING  
 JOB

HOLLY VIEW DRIVE

CENTERLINE OF DITCH  
 ON SKLADAN LINE  
 AT THIS CORNER

ROLLING MEADOWS

TANGENT  
 99.93 RECORD  
 98.60 MEAS  
 1'-4" SHORTAGE

CHORD  
 98.68 RECORD  
 98.95 MEAS  
 3/4" LONG

222.78 RECORD  
 222.26 MEAS  
 6/4" SHORTAGE

CHORD  
 92.42 RECORD  
 91.50 MEAS  
 11" SHORTAGE

CHORD  
 137.04 RECORD  
 137.80 MEAS  
 9/8" LONG

R=230.0 L=86.56

MAPLE VIEW DRIVE

174.74  
 181.87  
 N 0°25'E, 356.53'

PART OF 0-17 BOUNDARY SURVEY  
 SUBJECT =  
 29 2500 08 000 ± 1.0000 ± 0.0000 - 192

**PERIMETER SURVEY**

Scale 1" = 50'  
 Acreage \_\_\_\_\_

SUBLOT \_\_\_\_\_ of \_\_\_\_\_  
 SKLADAN RESIDENCE

Plat Vol \_\_\_\_\_ Page \_\_\_\_\_

Part of O.L. \_\_\_\_\_ Section \_\_\_\_\_

Tract \_\_\_\_\_ TWP \_\_\_\_\_

City of VERMILION  
 LORAIN Co., Ohio

**Michael G. Hura & Associates**

4560 Liberty Ave. Vermilion, Ohio

drawn UGH

date 07-31-80

scale 1"=50'

field book

PERMANENT  
 PARCEL NUMBER