



MONUMENT IRON PIN @ N.E. CORNER OBERLIN & ELEVENTH ST USED

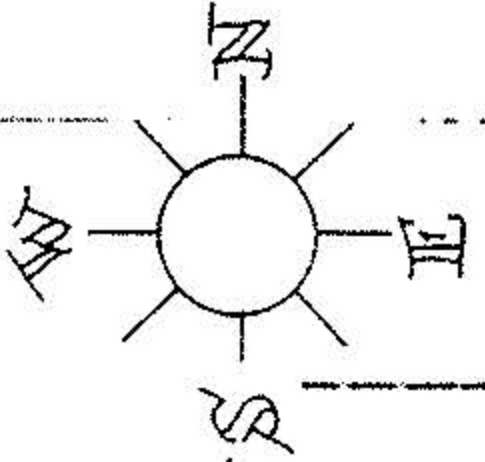

OBERLIN AVE. 66'

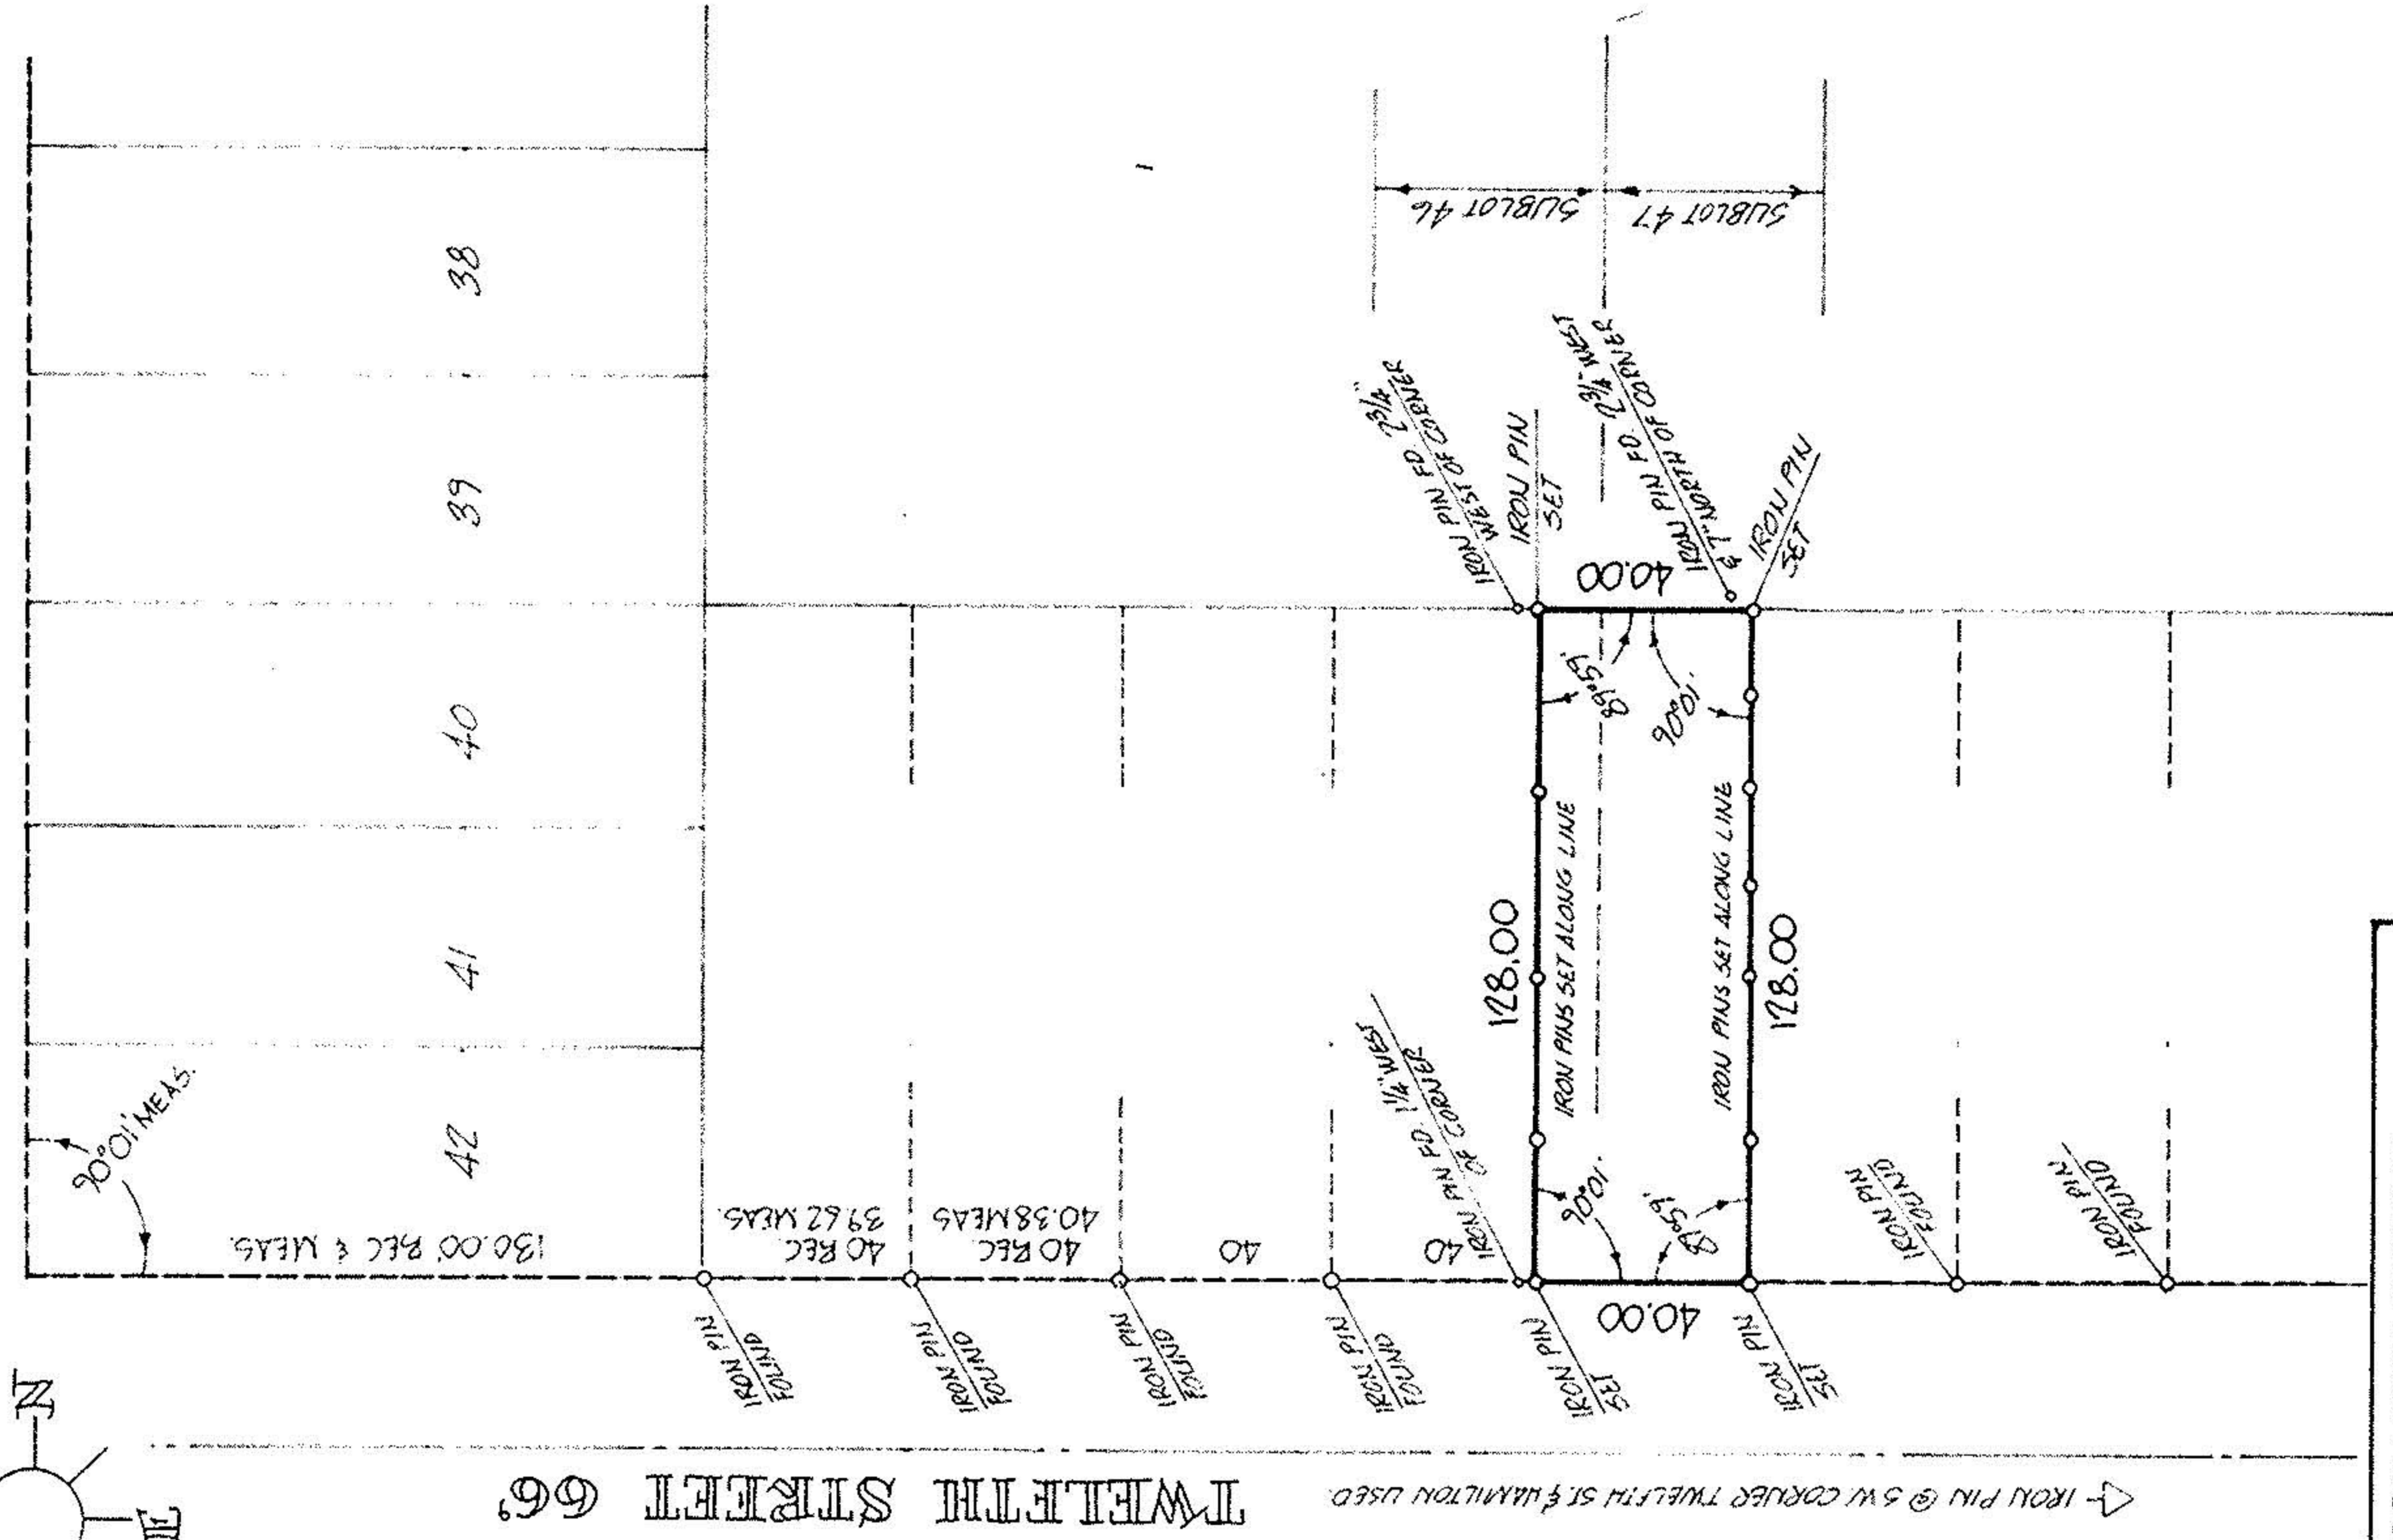

TWELFTH STREET 66'

IRON PIN @ S.W. CORNER TWELFTH ST. & HAMILTON USED

PERIMETER SURVEY  
perm. parcel 02-01-006-119-025  
acreage

MICHAEL G. HURA & ASSOCIATES  
3409 LIBERTY AVE. VERMILION, OHIO

WESTERLY 1104 FT. OF 46  
SUBLOT 47 & EASTERLY 28.96 FT. OF 47  
of E.R. PERKINS ADDN

as recorded in Plat Vol. 7 Page 21

PART of Original Lot 66, Tract 1 Section of  
BLACK RIVER Township LORAIN County

City of LORAIN

OHIO

drawn MG  
date 08-20-81  
scale 1" = 50 ft

02-01-006-119-025  
2-01-006-C

