


04-00-010-114-034
04-00-010-E

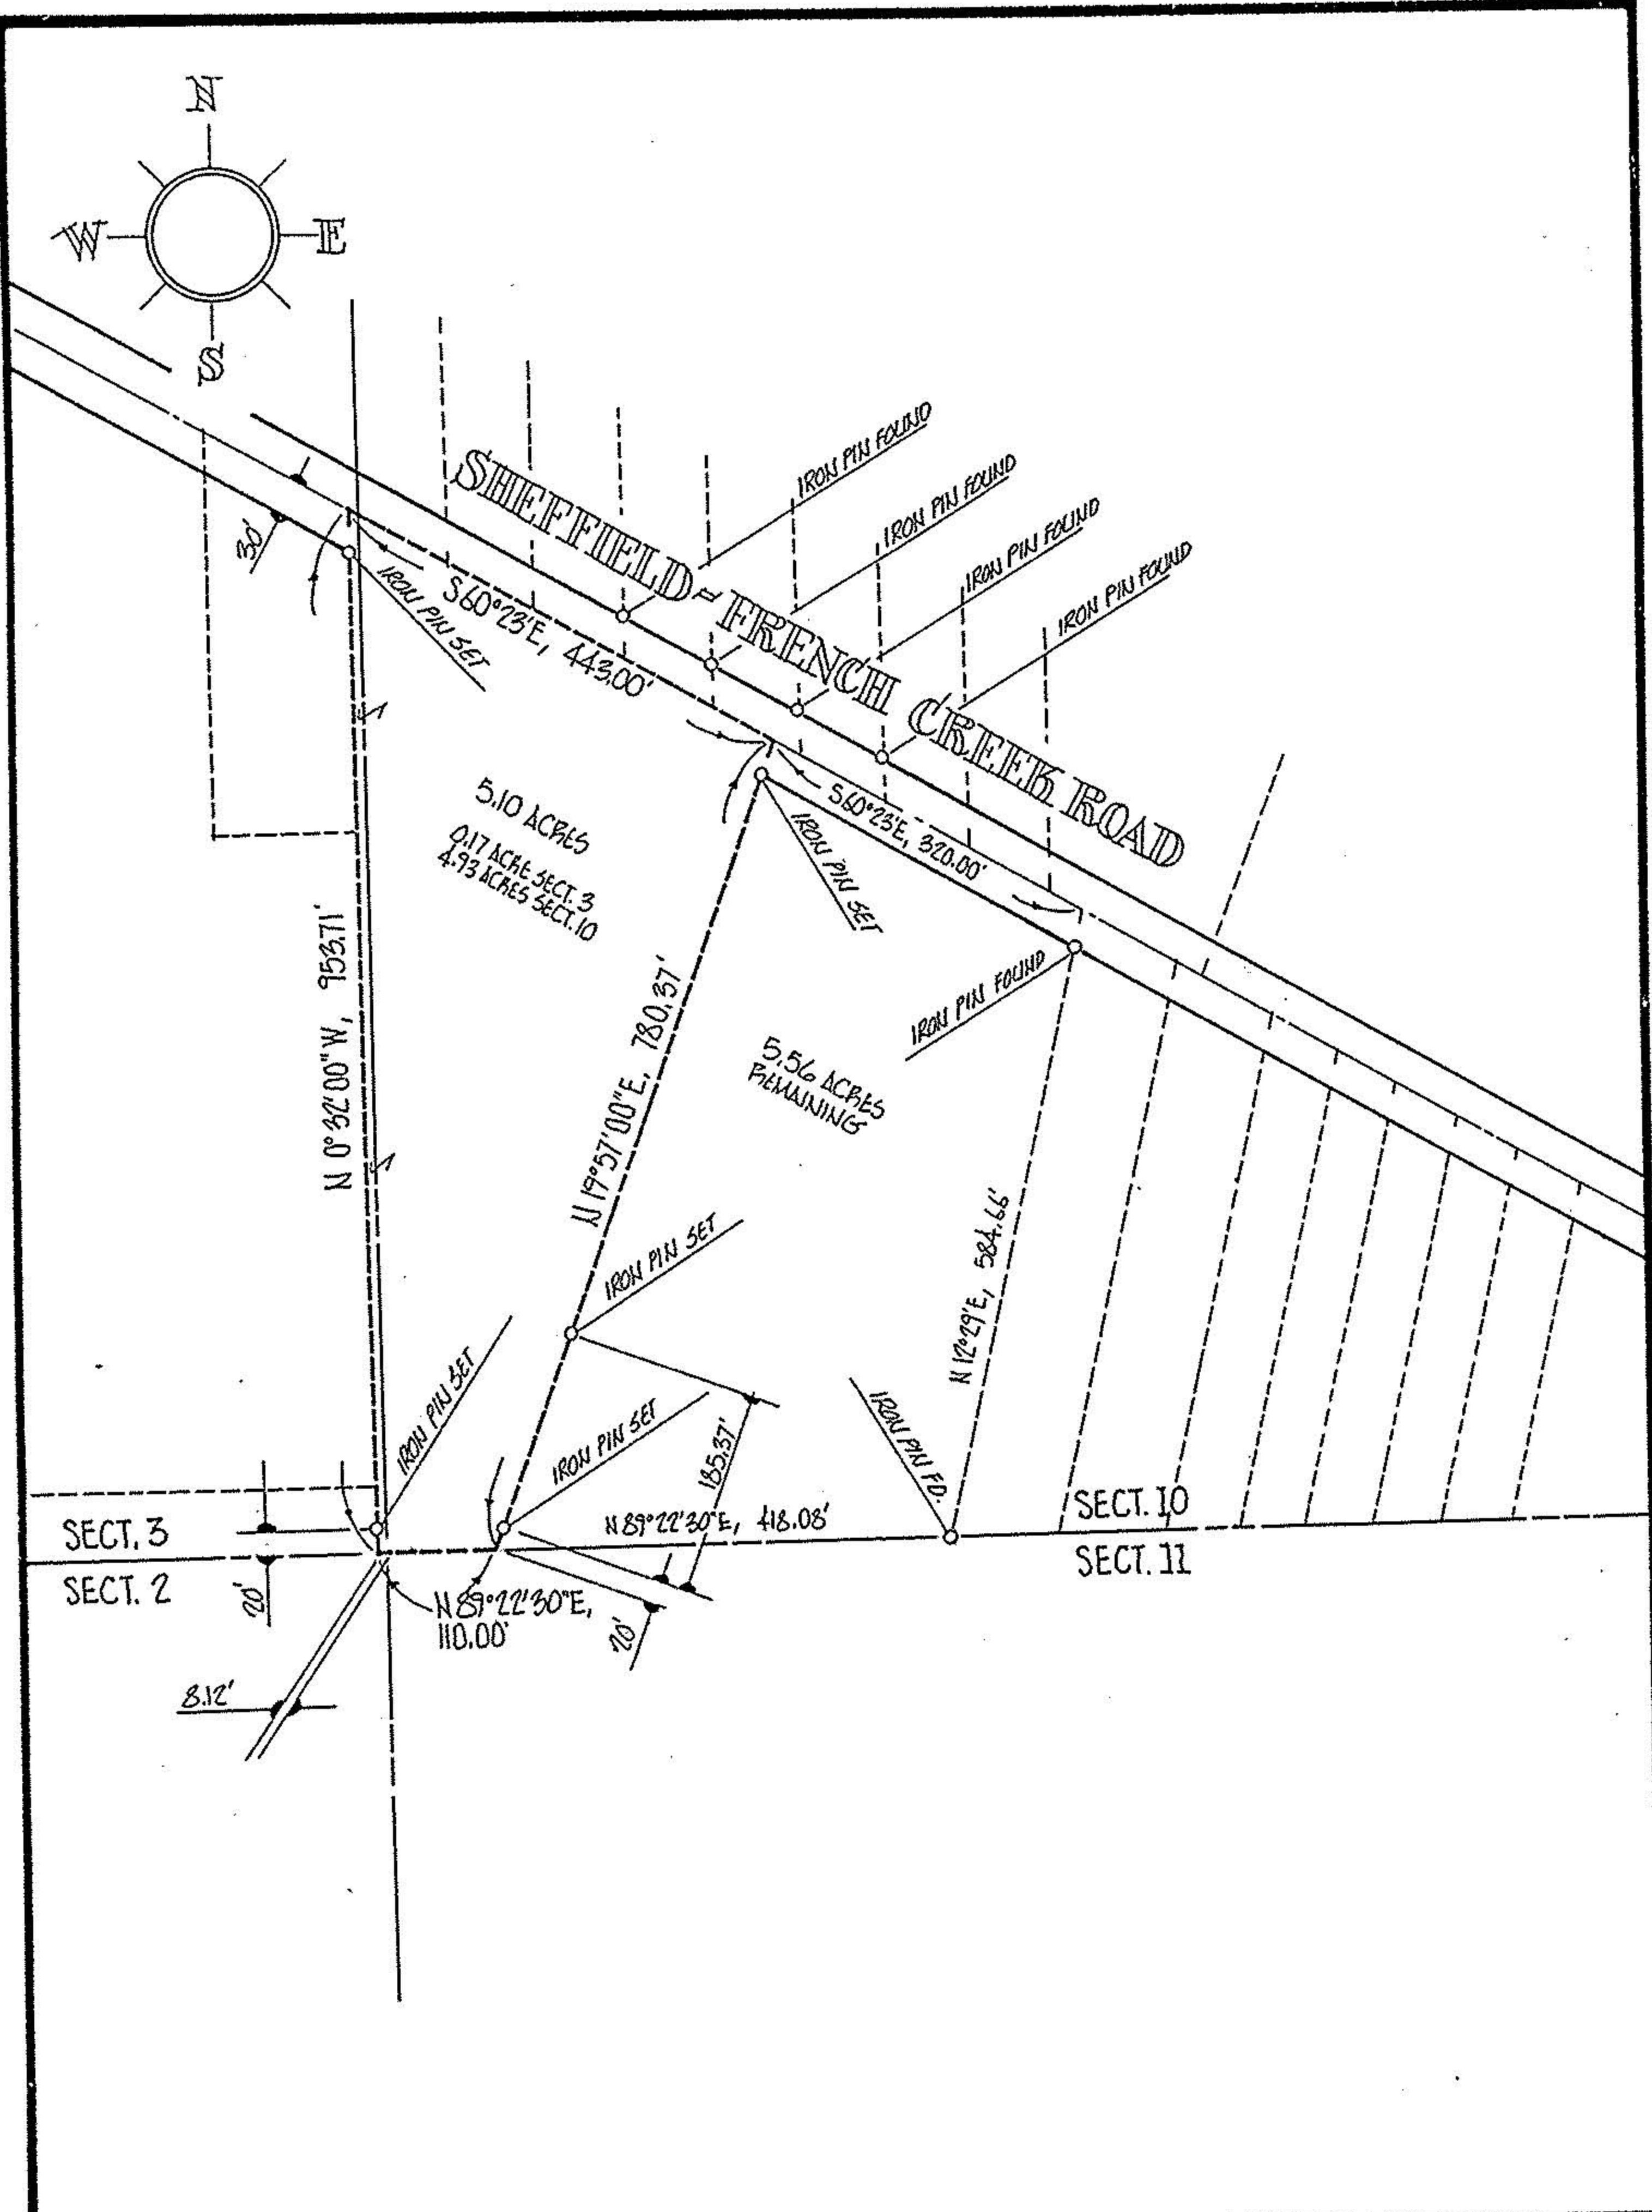

ACREAGE 10.66
DATE 09-25-84
DRAWN MGH
SCALE 1" = 200 ft.

PREPARED FOR MR. DON LAW 934-4593
38017 FRENCH CREEK ROAD, AVON, O.

MICHAEL G. HURA, registered surveyor
12706 MASON RD., VERMILION, O., Ph(216) 965 4040



PERIMETER SURVEY

SUBLOT(s) _____ of _____
Volume _____ Page _____ of PLATS
PART OF O.L. _____ TRACT _____ SECTIONS 3 & 10 OF
AVON TOWNSHIP LORAIN CO., OHIO
PERMANENT PARCEL NO. _____

CITY OF
AVON