


05-00-038-105-076
5-00-038-A



NOTE: BEARINGS ASSIGNED TO THE LINES ON THIS PLAT ARE ASSUMED FOR PURPOSES OF DESCRIBING ANGLES ONLY AND ARE NOT OF TRUE MERIDIAN. SURPLUS DIMENSIONS IN AN EAST-WEST DIRECTION WAS OBSERVED AND NOTED HEREON

REVISION, 6-10-74 - SOUTH LINE MOVED 3" NORTH - AS NOTED.

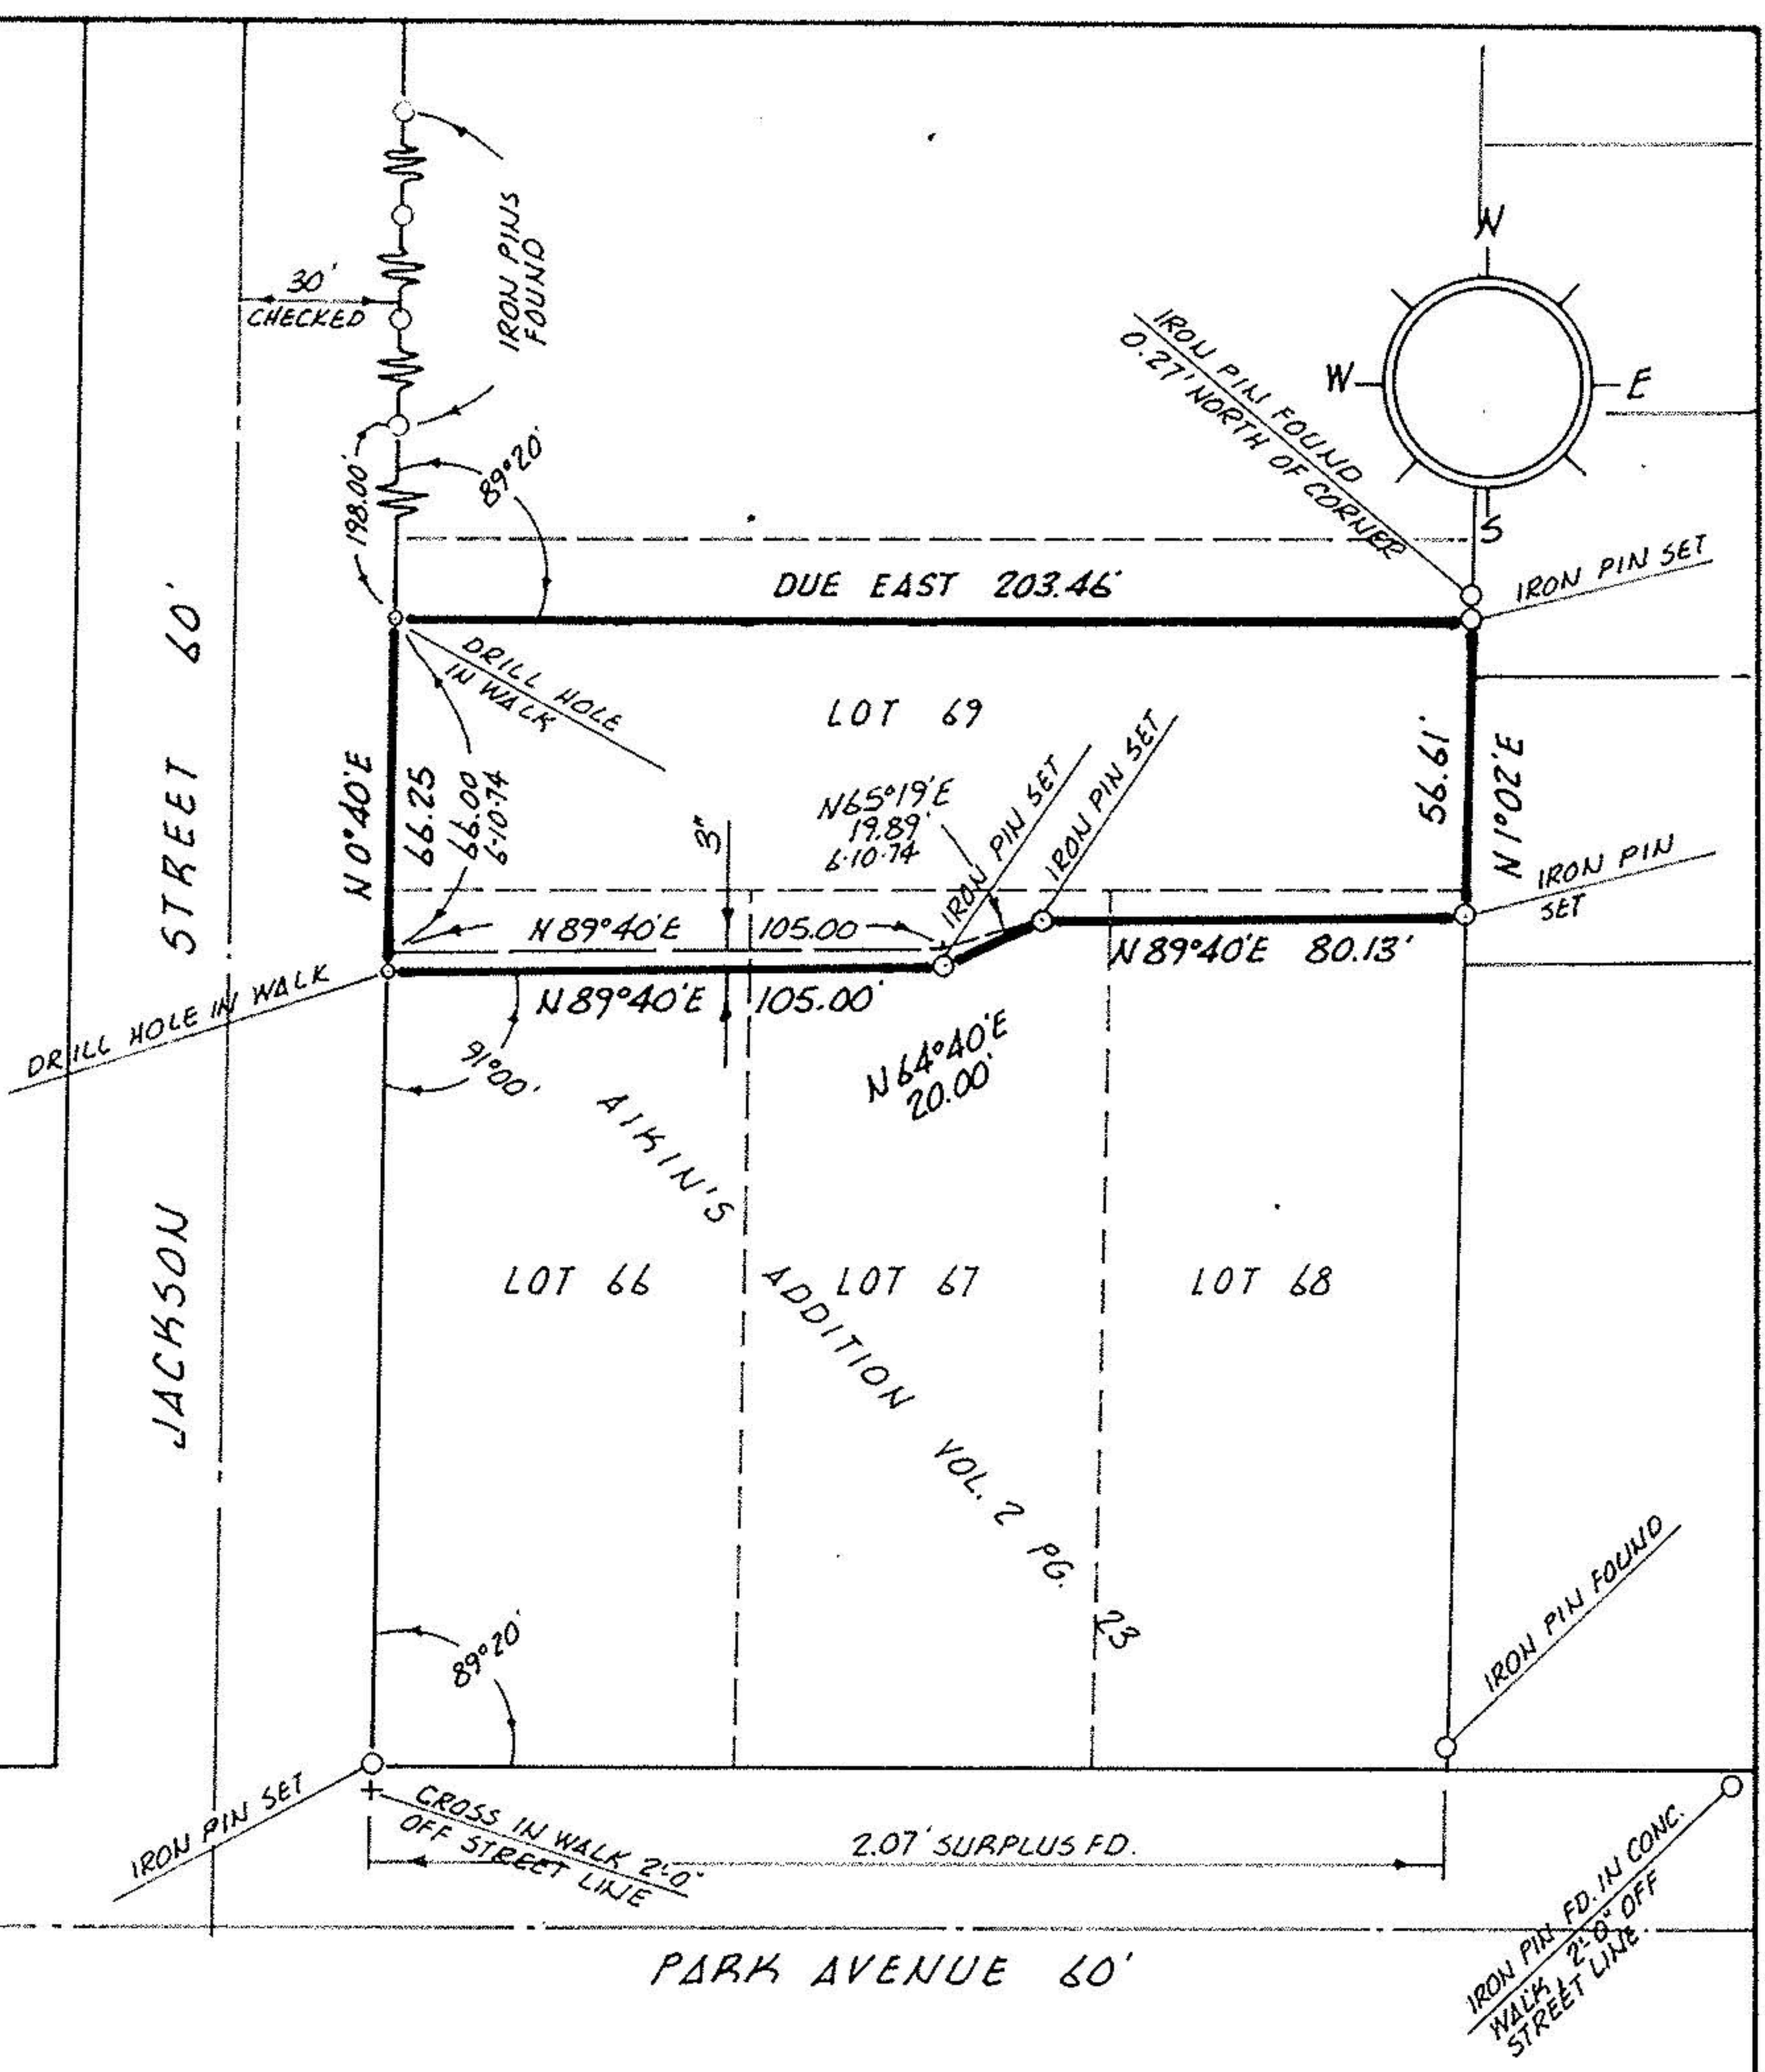

acreage

DWG No.	PERIMETER SURVEY		MICHAEL G. HURA REGISTERED SURVEYOR 199 PARK AVENUE AMHERST, OHIO 44001
	PARTS Sublot $\nabla \nabla \nabla \nabla$ of <u>AIKIN'S ADDITION</u> Vol. <u> </u> Page <u> </u> Part of O.L. <u>38</u> Sect. <u> </u> Tr. <u> </u> City of <u>AMHERST</u> <u>AMHERST</u> Twp. <u>LORDAIN</u> Co.		