



05-00-038-106-022
 05-00-038-106-023
 05-00-038-106-024
 05-00-038-106-025
 5-00-038-B

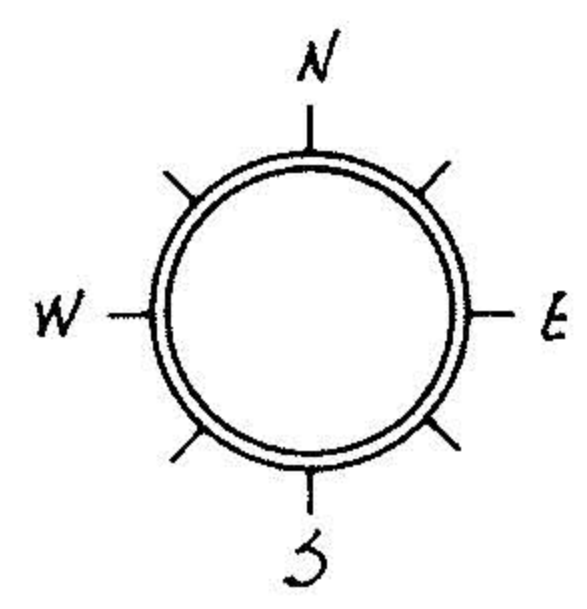

NOTE: A DEFICIENCY OF 0.04' PER 50-FT. LOT WAS OBSERVED IN MEASURING BETWEEN LOTS NORTH OF THE SUBJECT SURVEY AND THIS DEFICIENCY WAS CARRIED IN THE LOTS SOUTH.

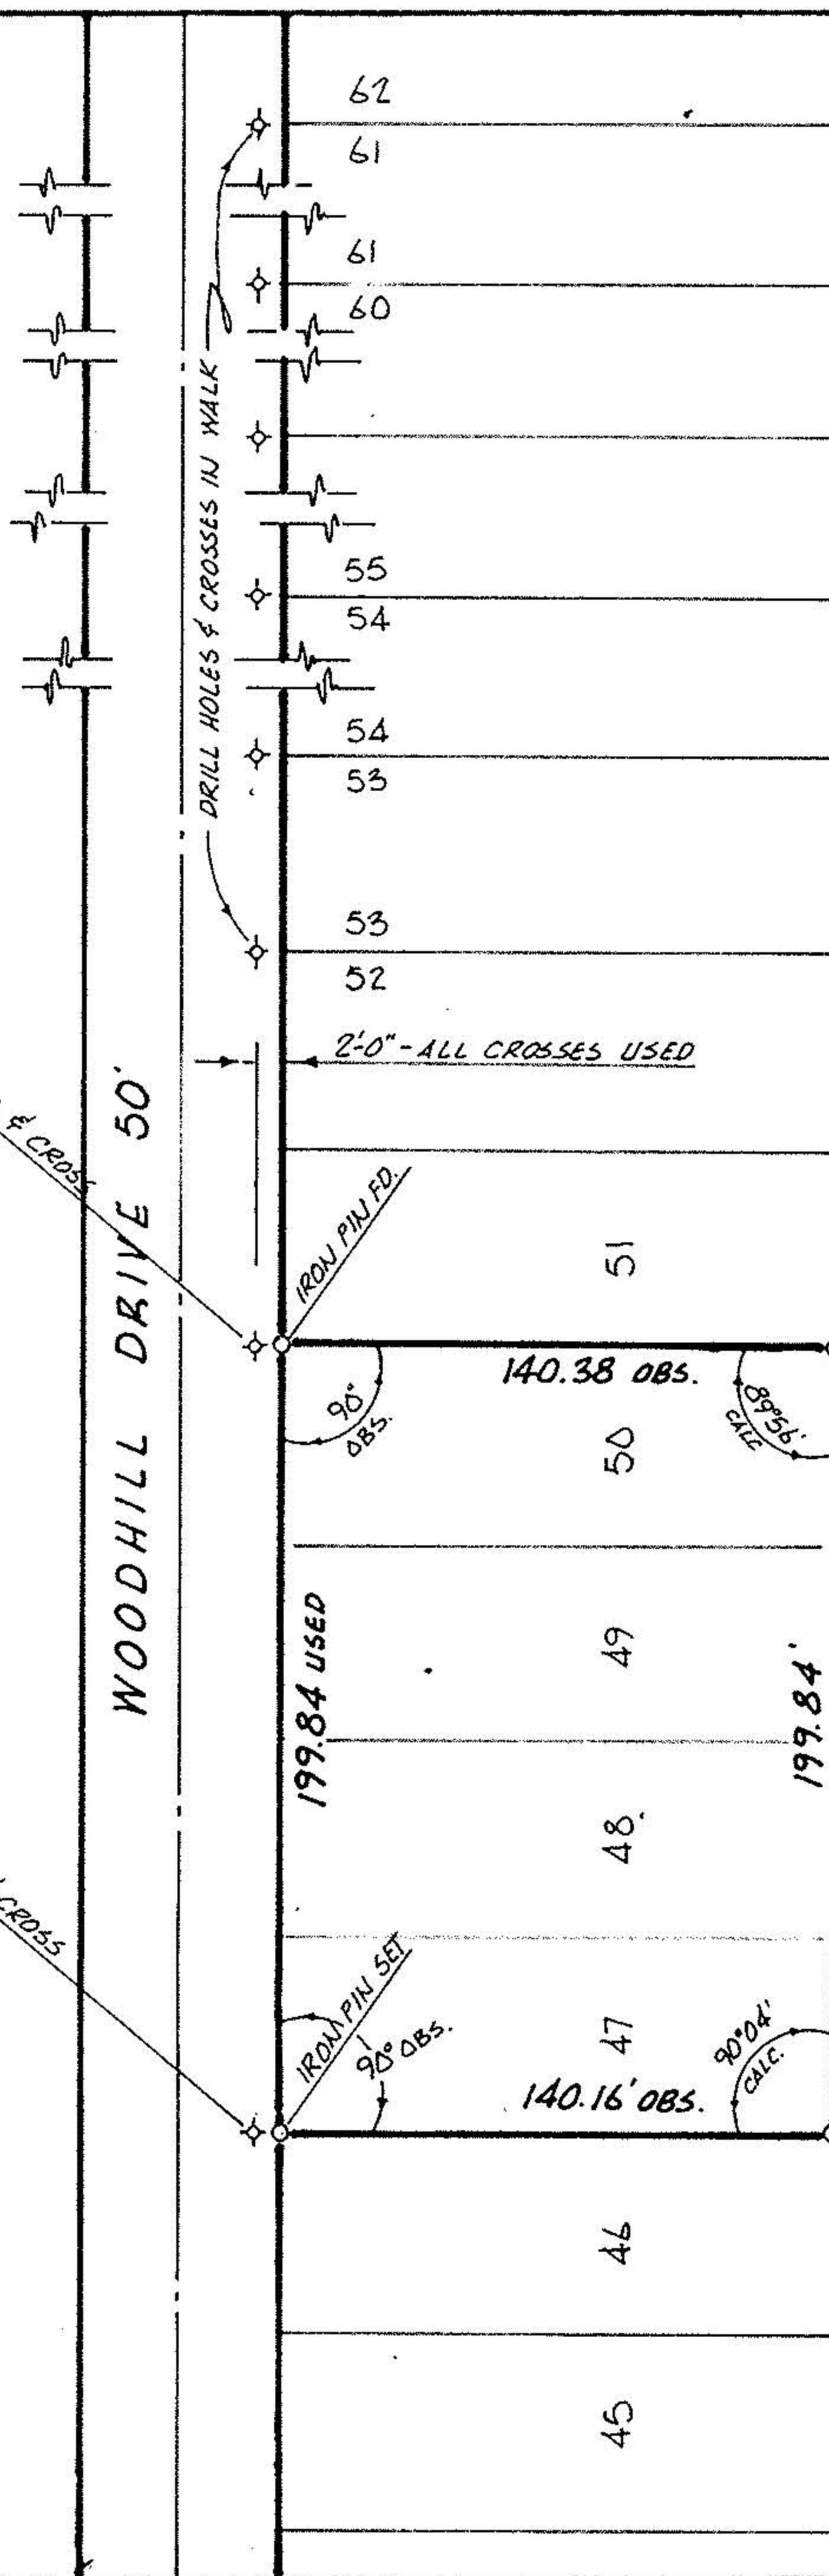

acreage

DWG No

PERIMETER SURVEY
 Sublot 11, 12, 13, 14, 15 of WOODHILL HEIGHTS
 Vol. 12 Page 30
 Part of O.L. 38 Sect. Tr.
 City of AMHERST
AMHERST Twp. LORAIN Co.

MICHAEL G. HURA
 REGISTERED SURVEYOR
 199 PARK AVENUE
 AMHERST, OHIO 44001

drawn MGH
 date 4-25-74
 scale 1" = 60'