


00-00-039-110-001  
5-00-039-B

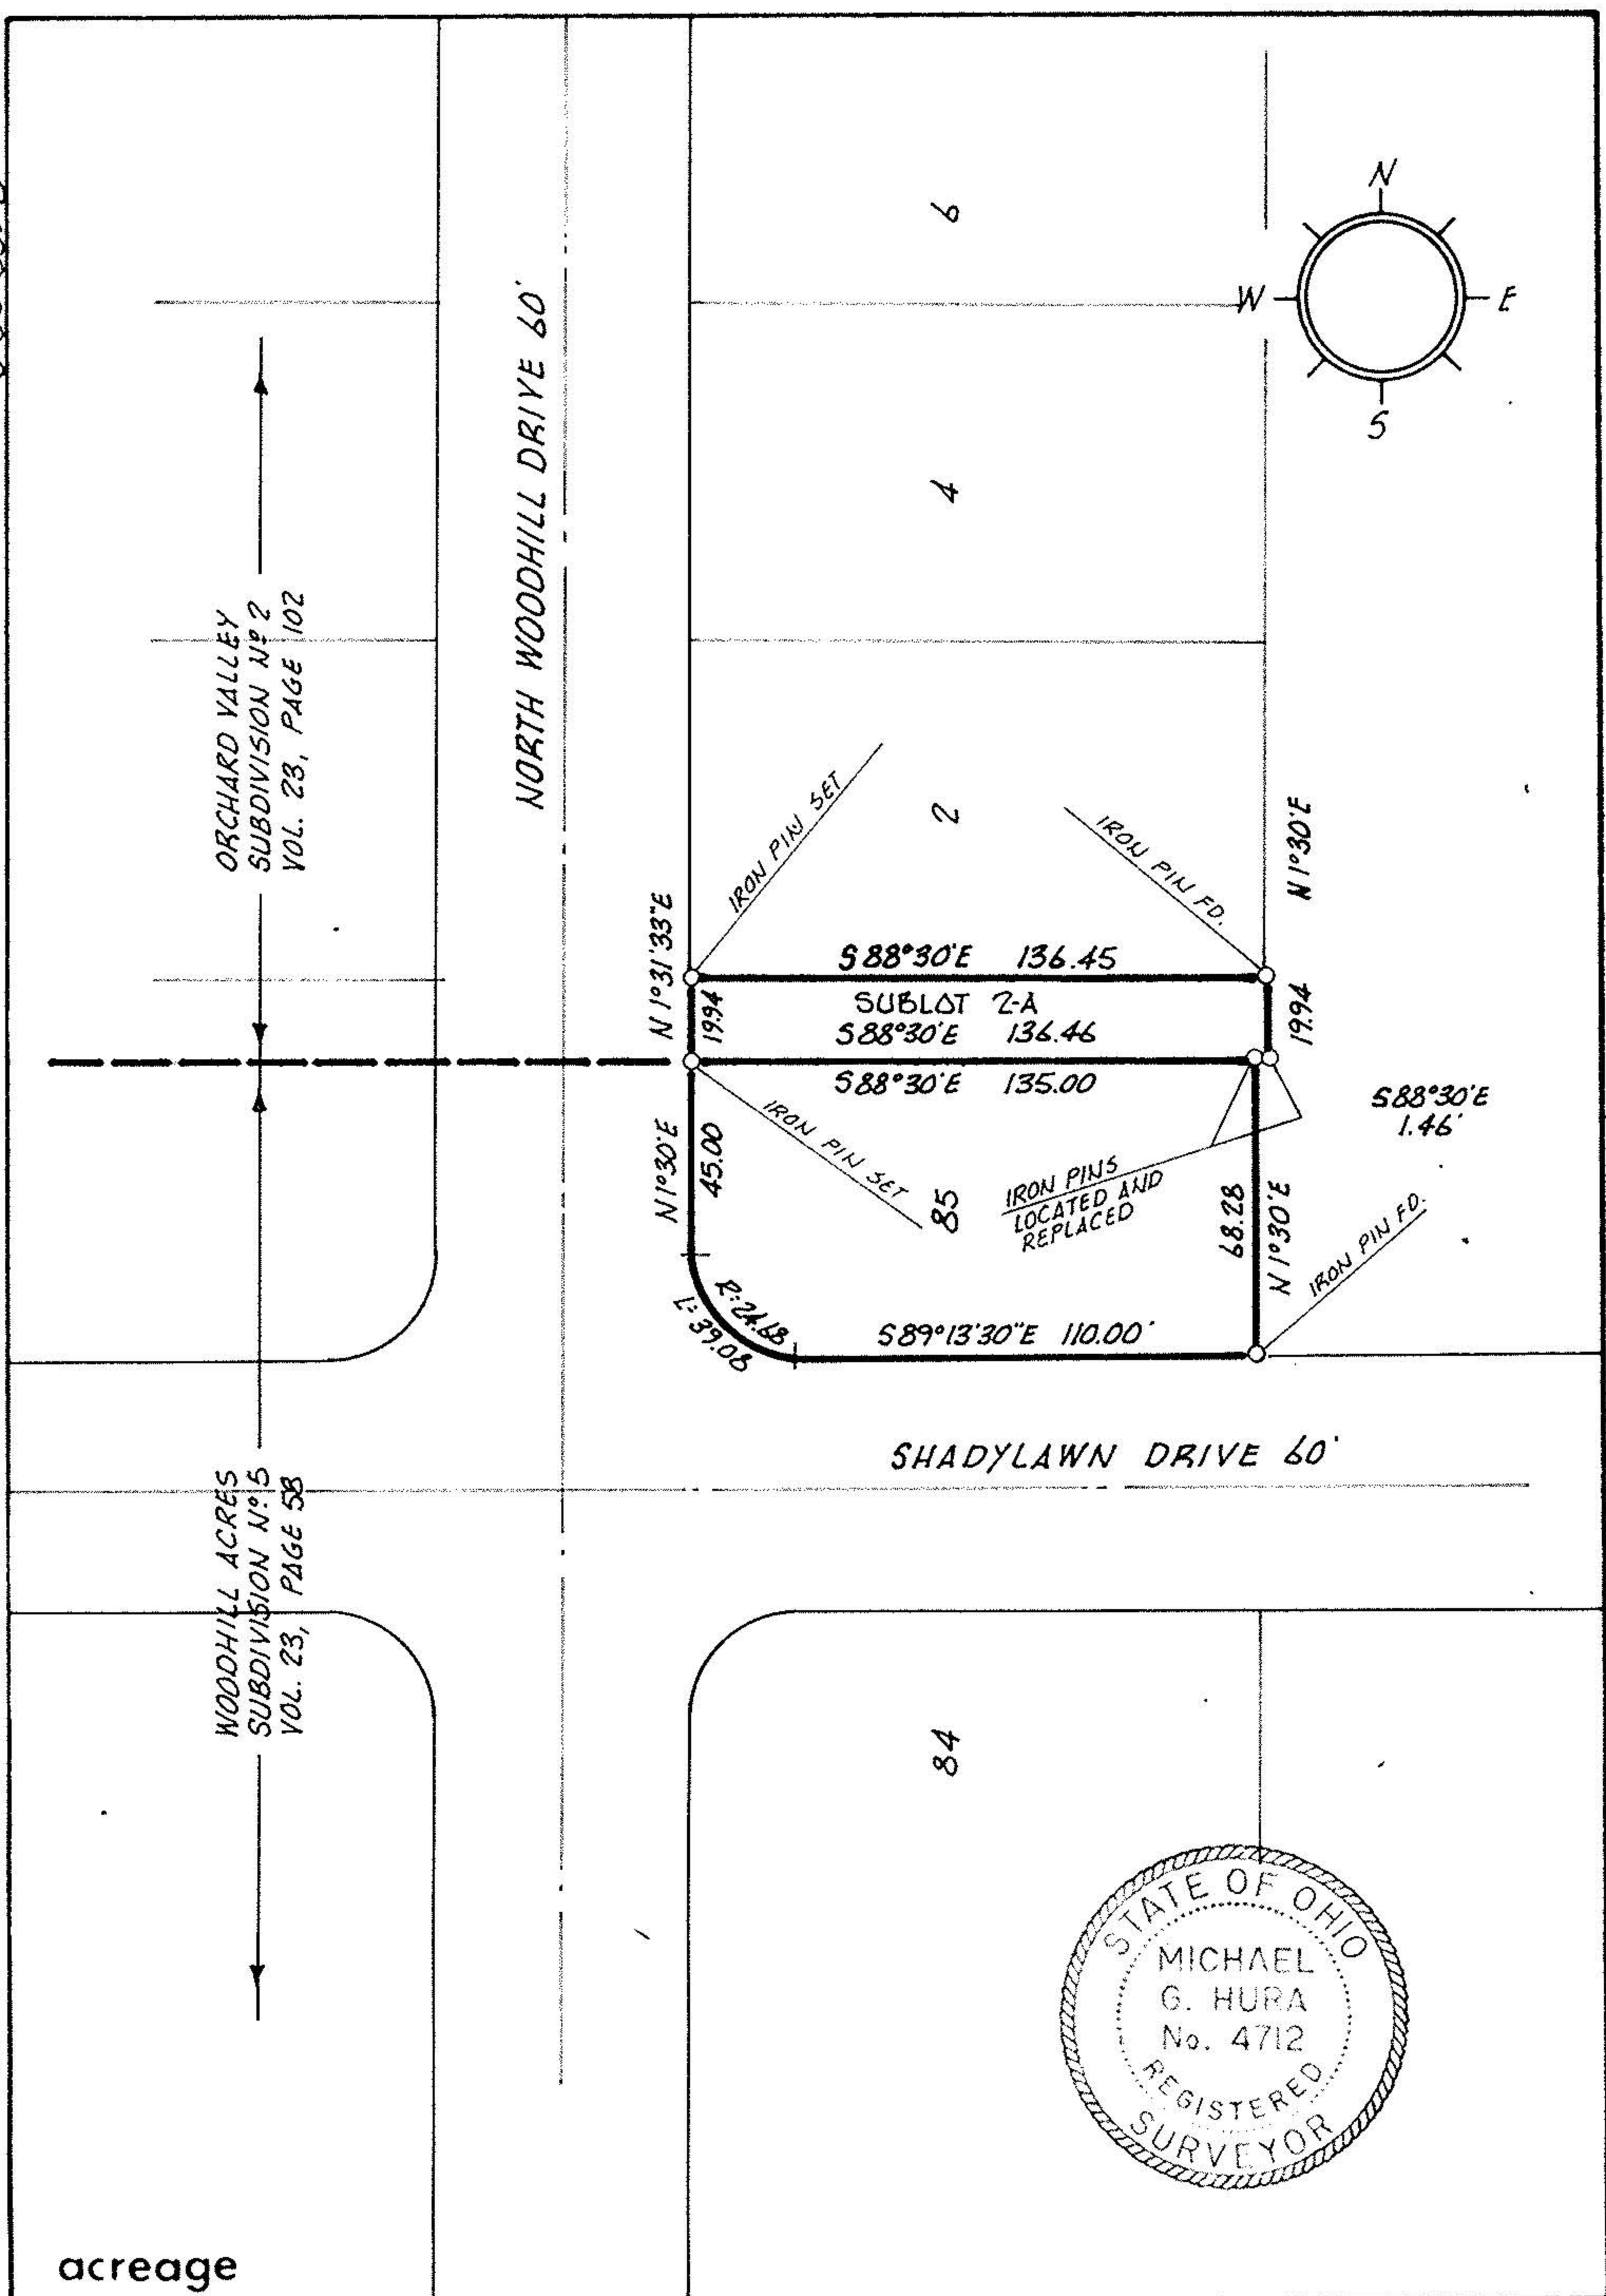

acreage

DWG  
No.

**PERIMETER SURVEY**

Sublot 2-A of ORCHARD VALLEY SUBN 2  
85 of WOODHILL ACRES SUBN 5  
Vol. 23 Page 102  
Part of O.L. 39 Sect. 1 Tr. 1  
City of AMHERST  
AMHERST Twp. LORAIN Co.

**MICHAEL G. HURA**  
REGISTERED SURVEYOR  
199 PARK AVENUE  
AMHERST, OHIO 44001

drawn MGH  
date 4-10-74  
scale 1" = 50'