


05-00-048-
5-00-048-A



A-C TIRE COMPANY

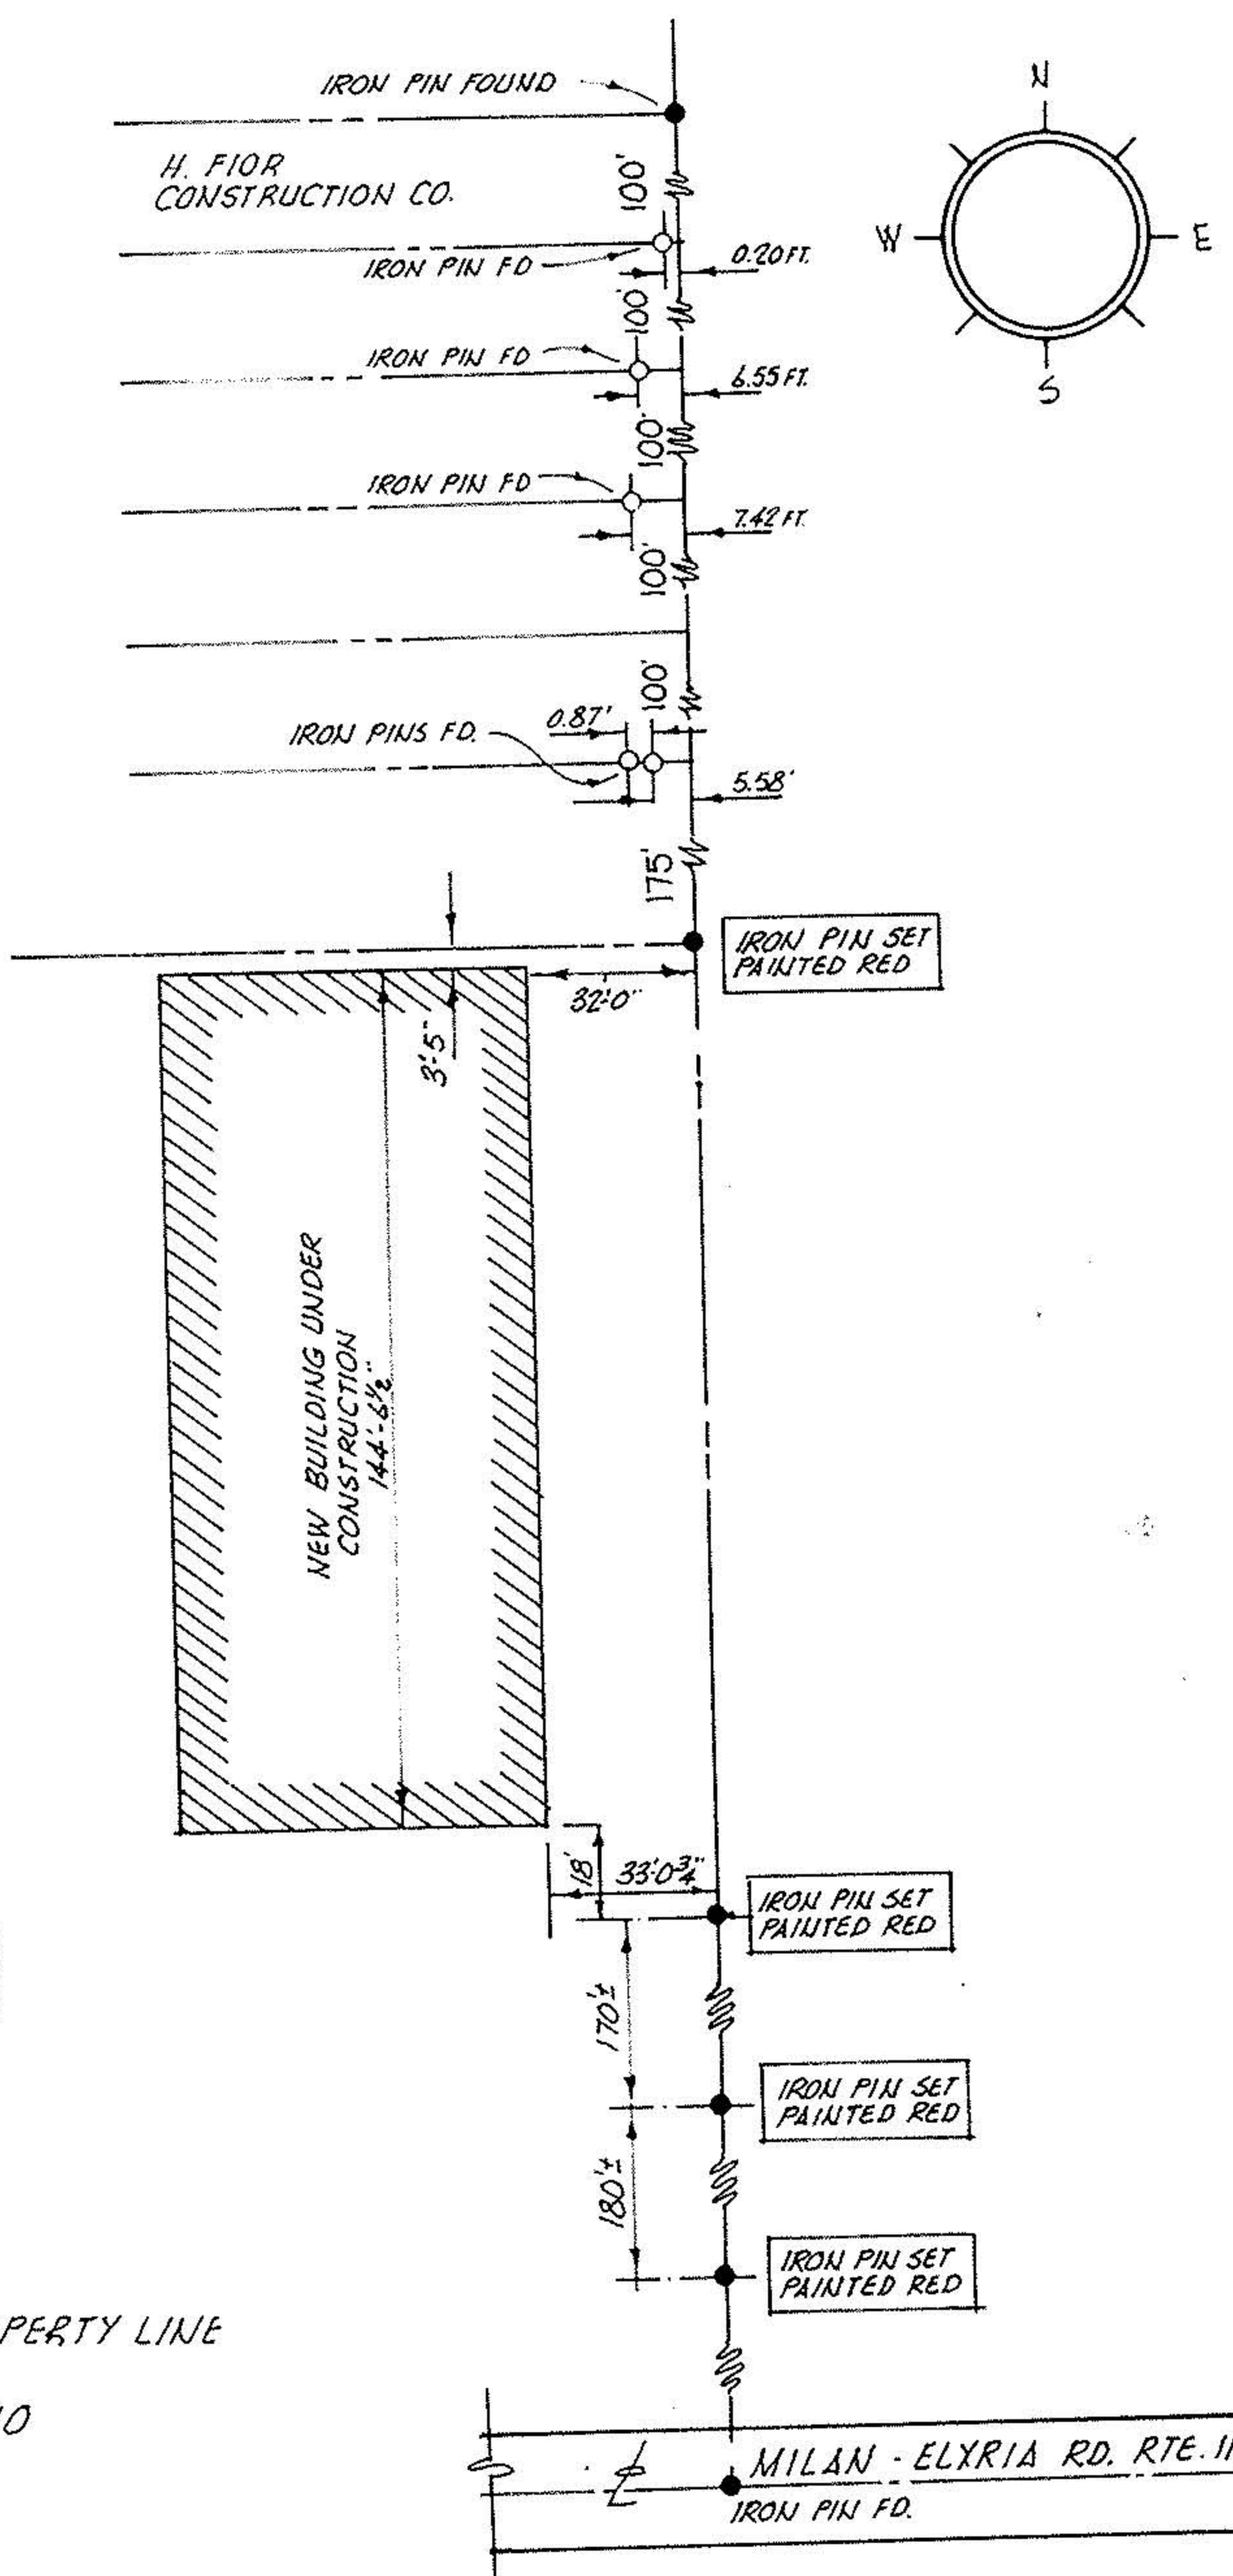

SURVEY OF EAST PROPERTY LINE
A-C TIRE COMPANY
SOUTH AMHERST, OHIO

acreage

DWG No	PERIMETER SURVEY		MICHAEL G. HURA REGISTERED SURVEYOR 199 PARK AVENUE AMHERST, OHIO 44001	
	Sublot _____ of _____	Vol. _____ Page _____	drawn MGH	
Part of O.L. _____ Sect. _____ Tr. _____	City of _____	date 04-24-77		
AMHERST Twp. LORAIN Co.		scale 1" = 50'		