


05-00-054-000
5-G

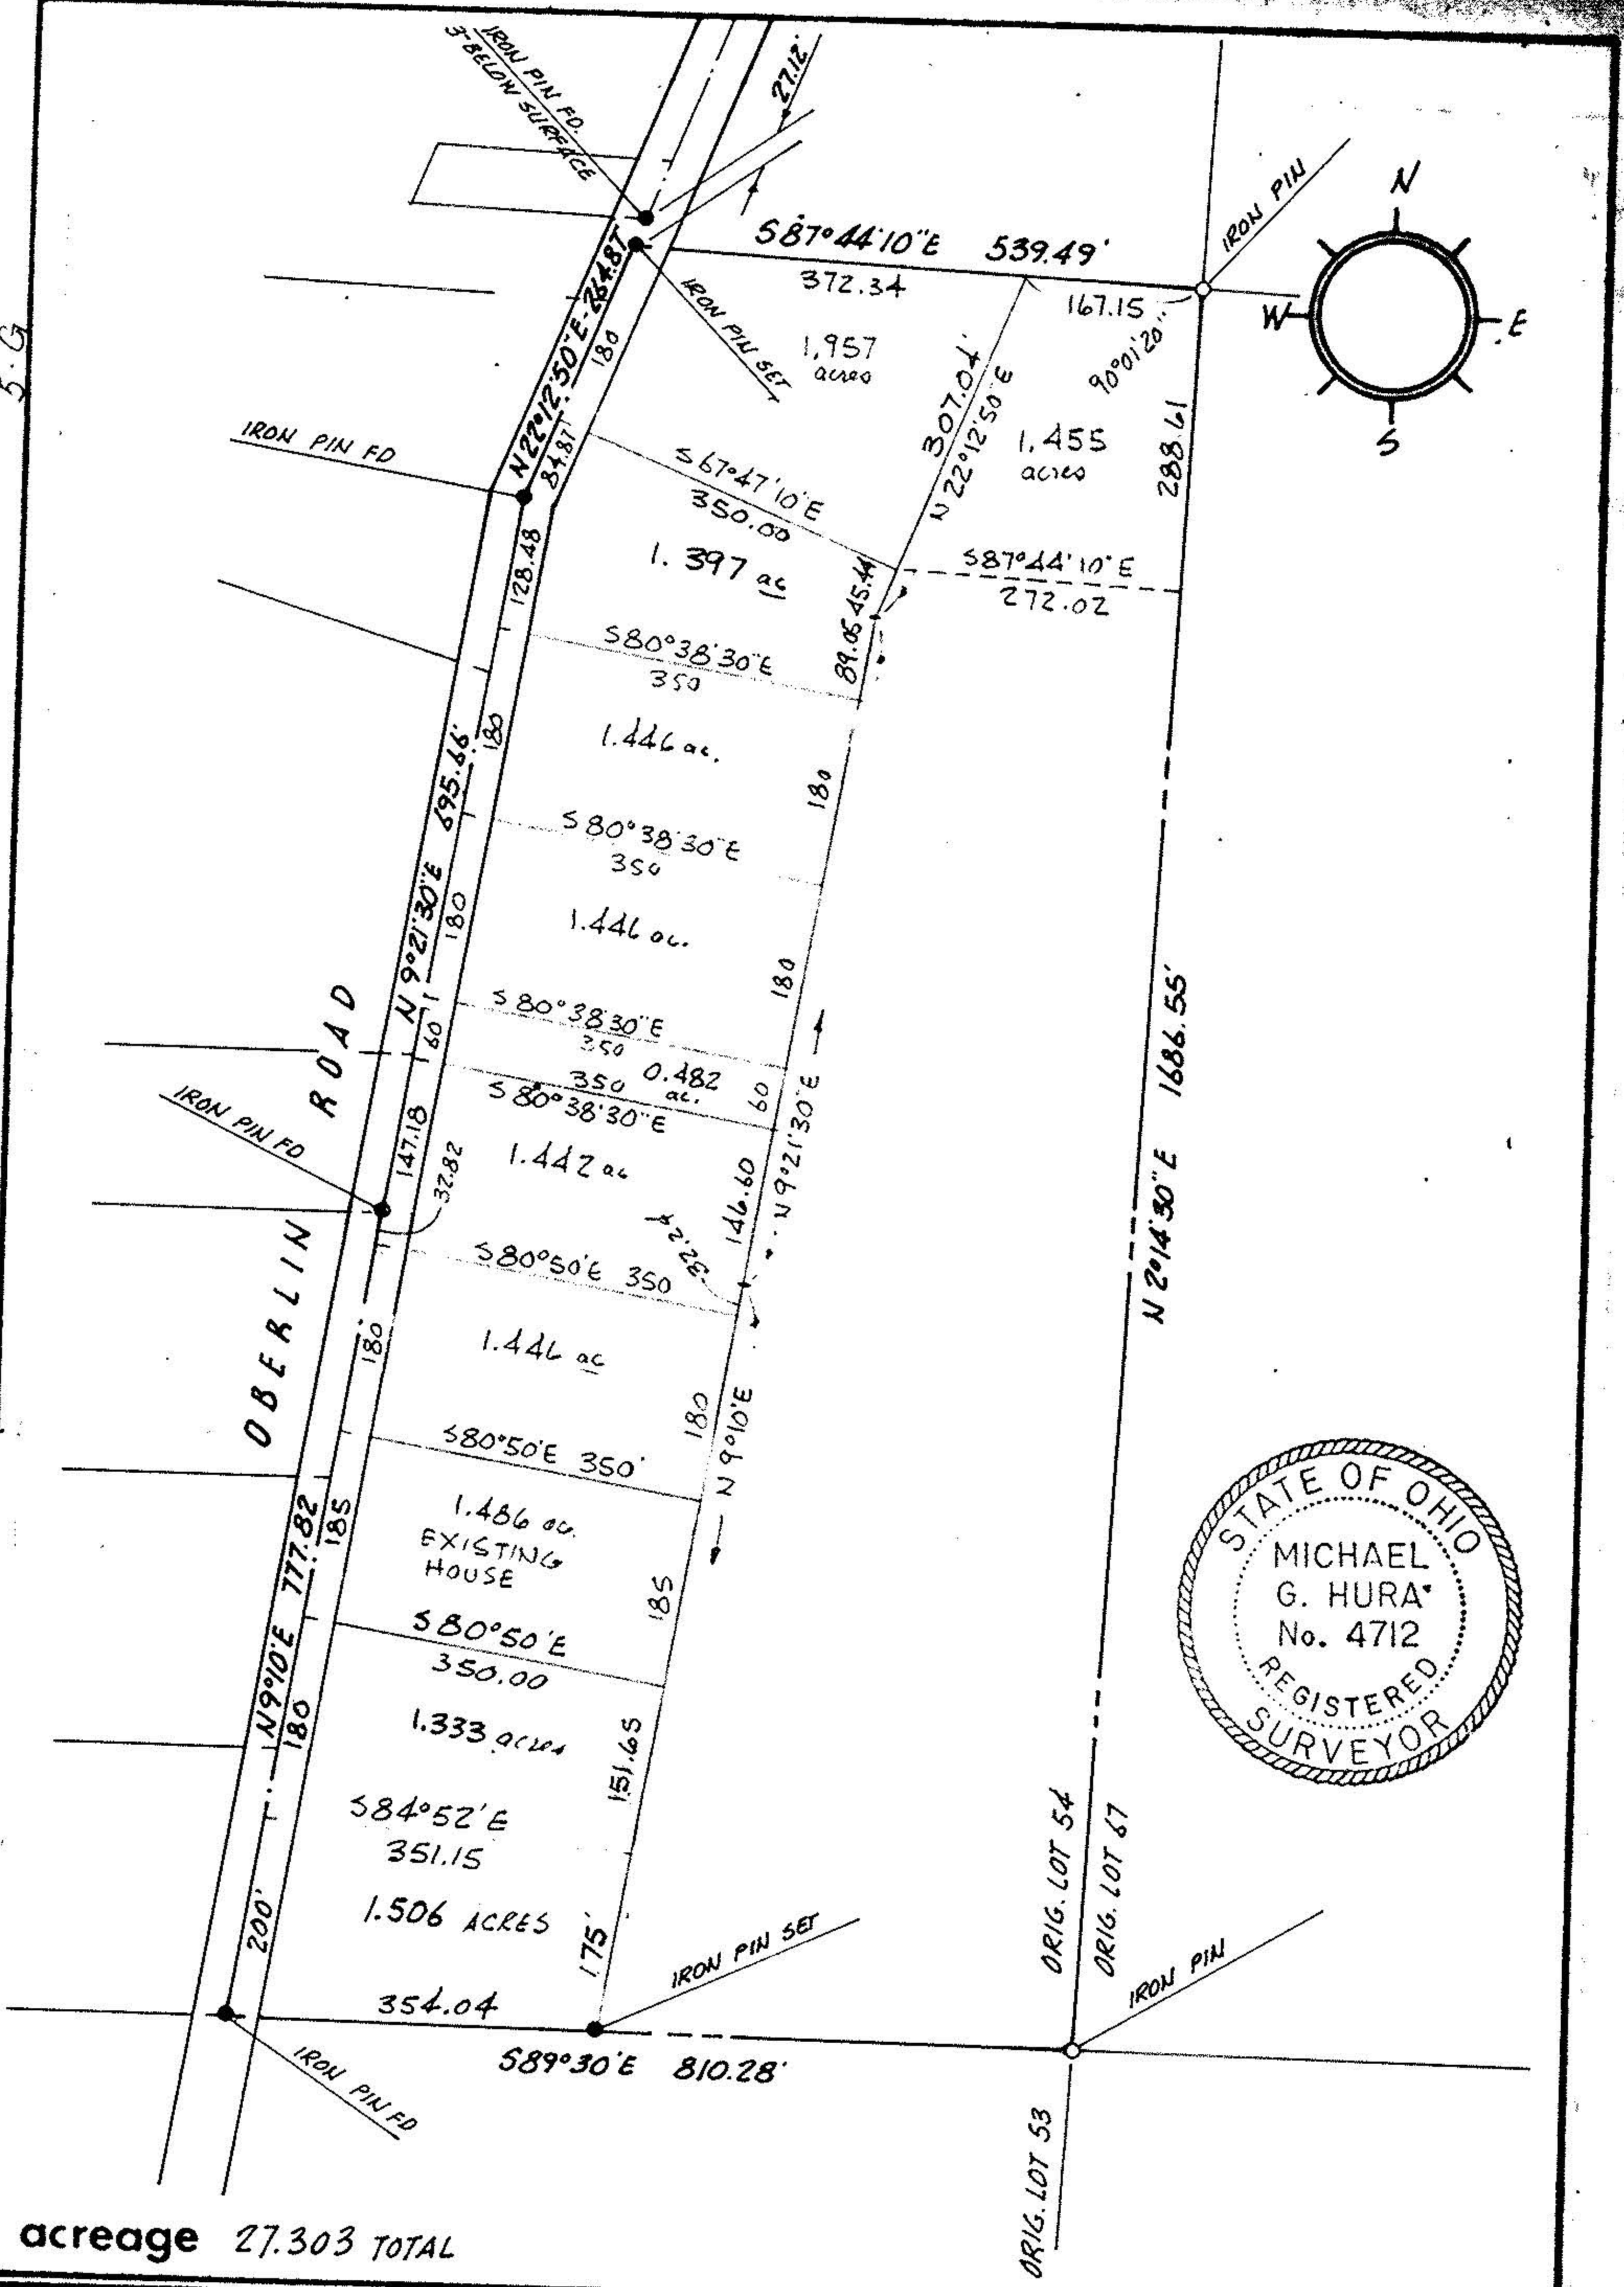

acreage 27.303 TOTAL

DWG No	PERIMETER SURVEY		MICHAEL G. HURA REGISTERED SURVEYOR 199 PARK AVENUE AMHERST, OHIO 44001	
	Sublot _____	Vol. _____ Page _____		
	Part of O.L. 54 Sect. _____ Tr. _____	City of _____	date APR. 16-74	
	AMHERST Twp. LORAIN Co.		scale 1"=200'	