
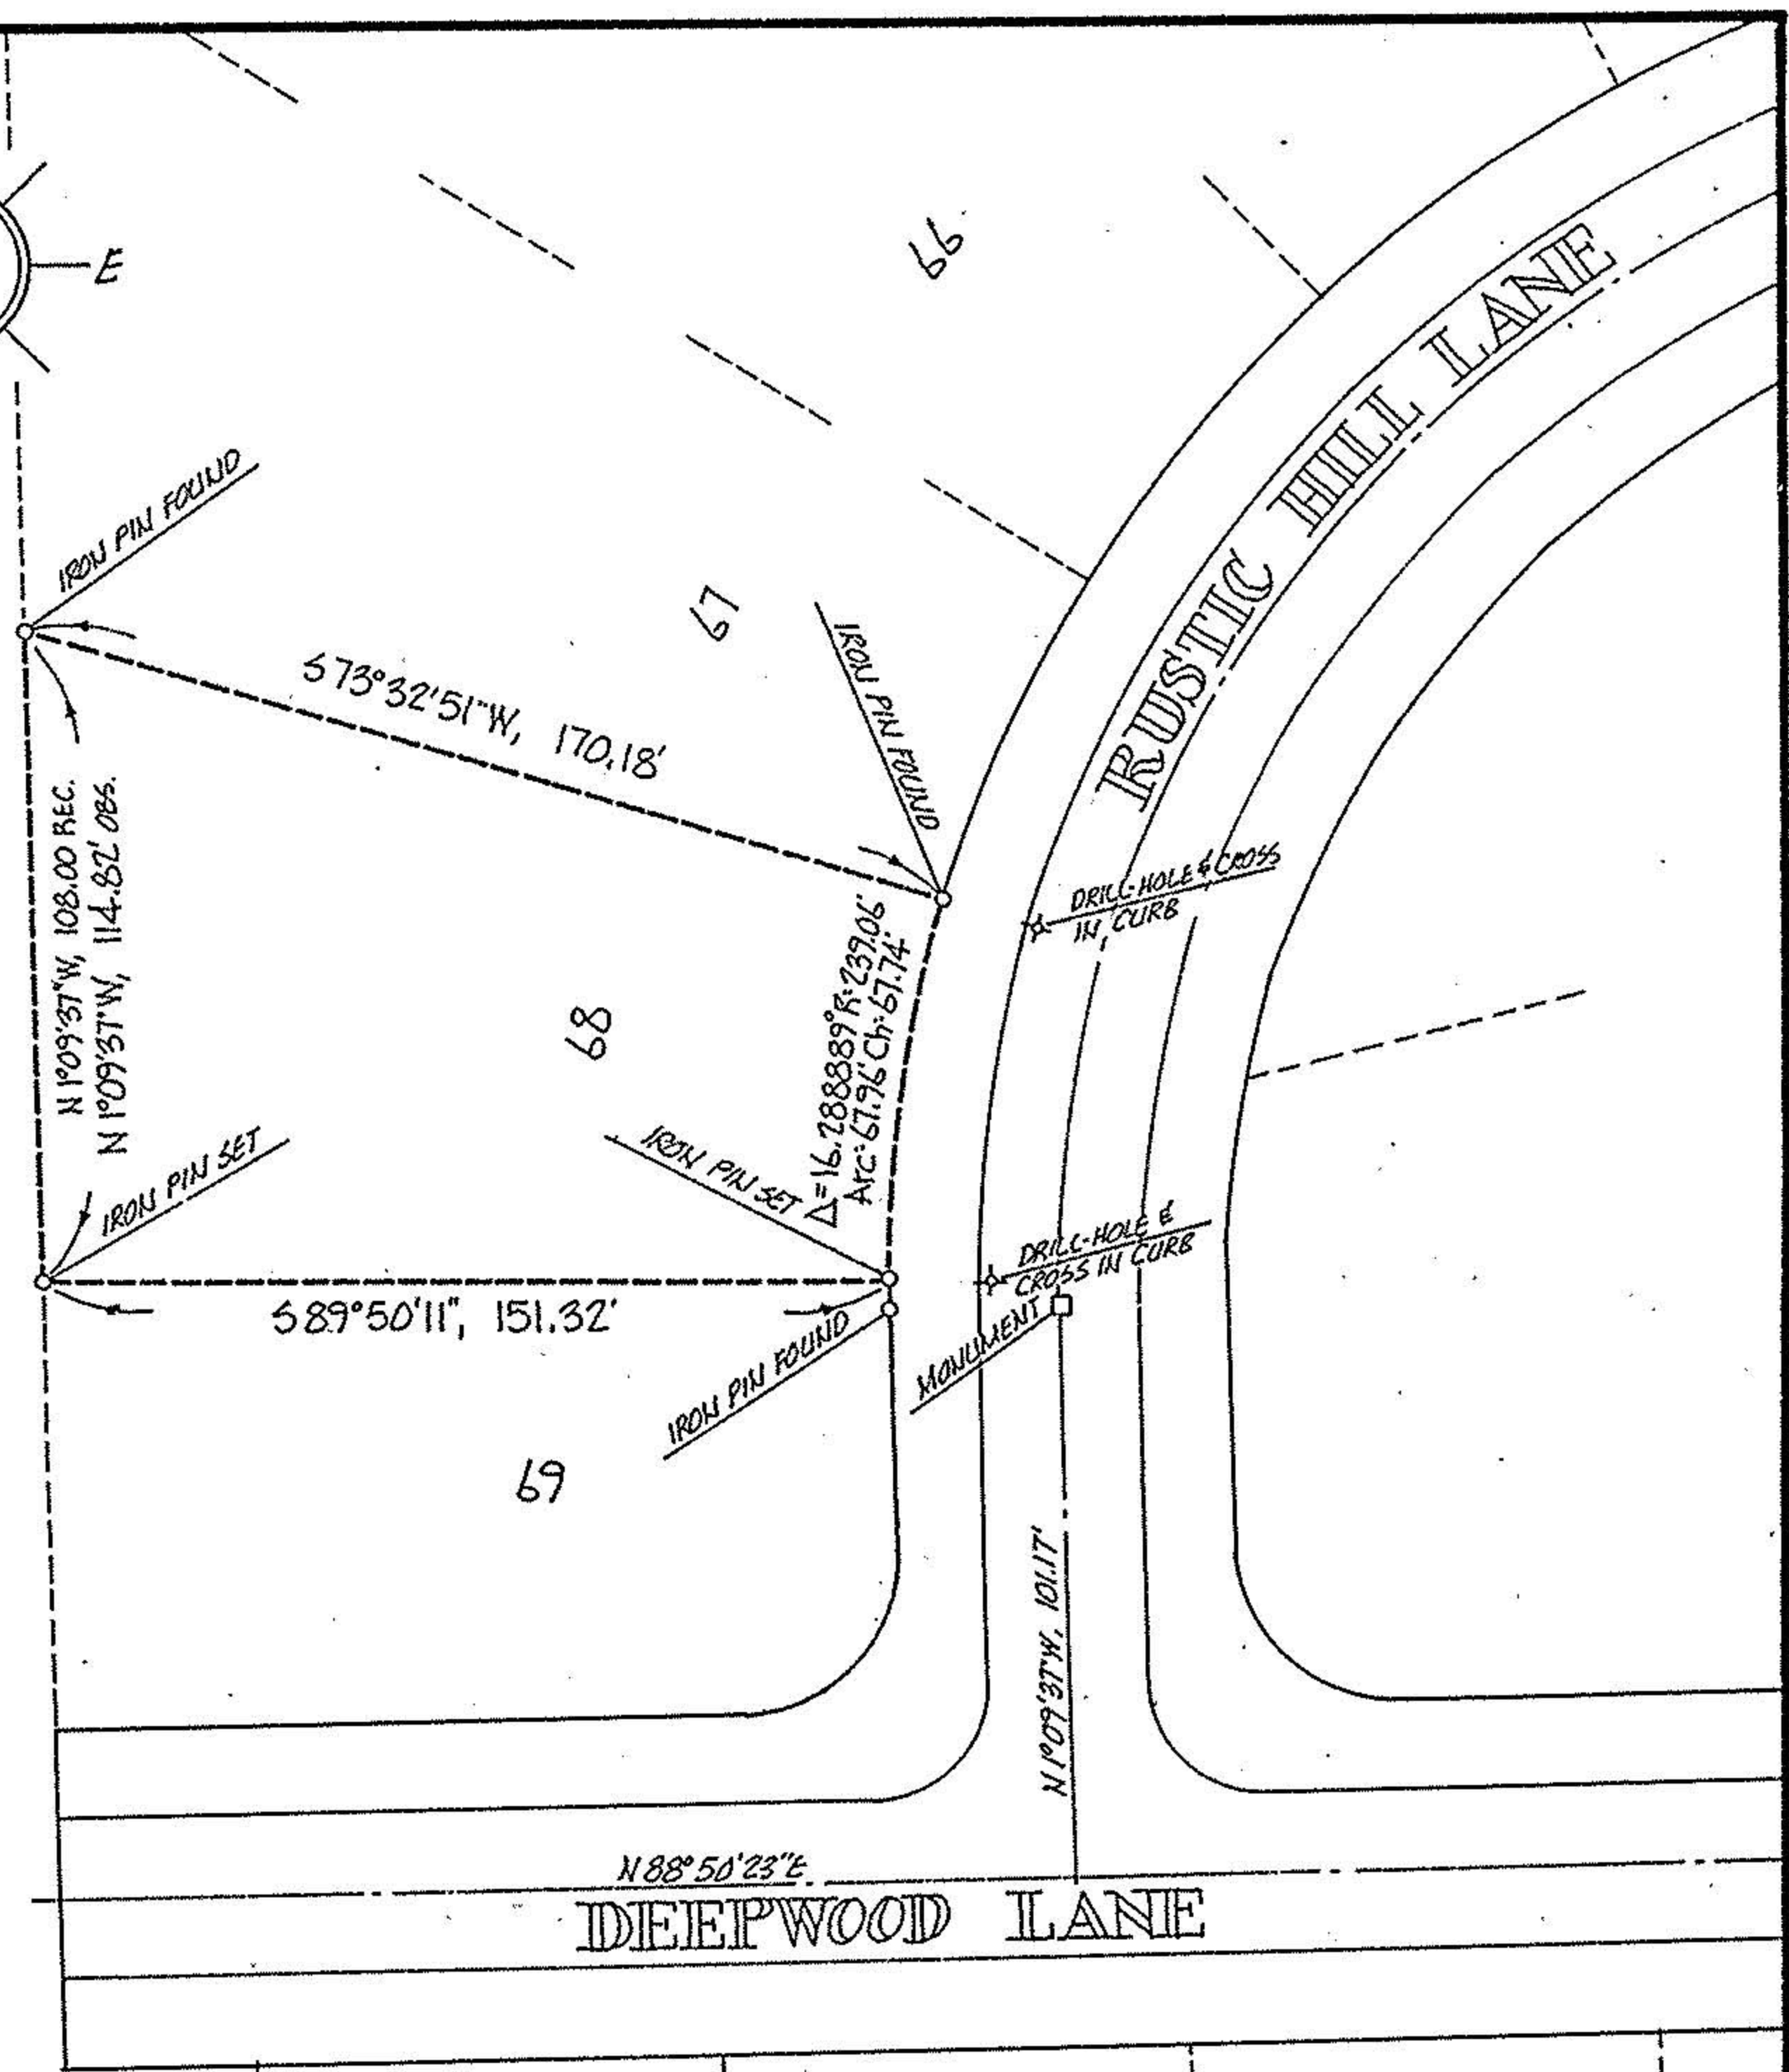


05-00-058-000-015  
05-00-058-B

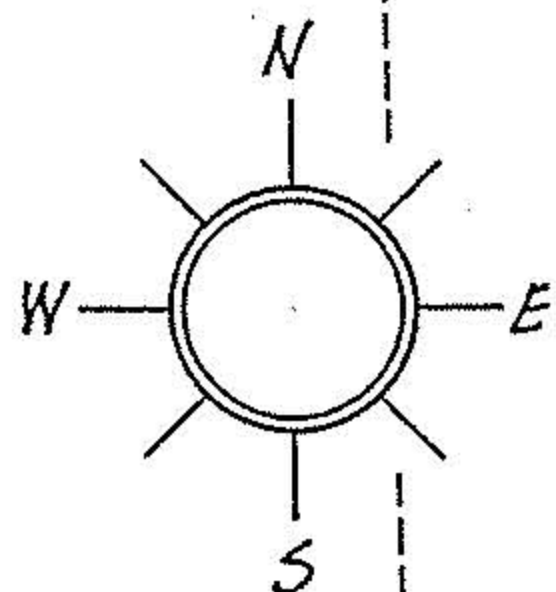

ACREAGE	PREPARED FOR	MR. & MRS LEROY REYNOLDS
DATE 06-25-86		242 RUSTIC HILL LN., LORAIN
DRAWN MGH	MICHAEL G. HURA, registered surveyor. 12706 MASON RD., VERMILION, O., Ph(216) 965 4040	
SCALE 1" = 50 ft.		

CITY OF