



05-00-094-103-022
05-00-094-B

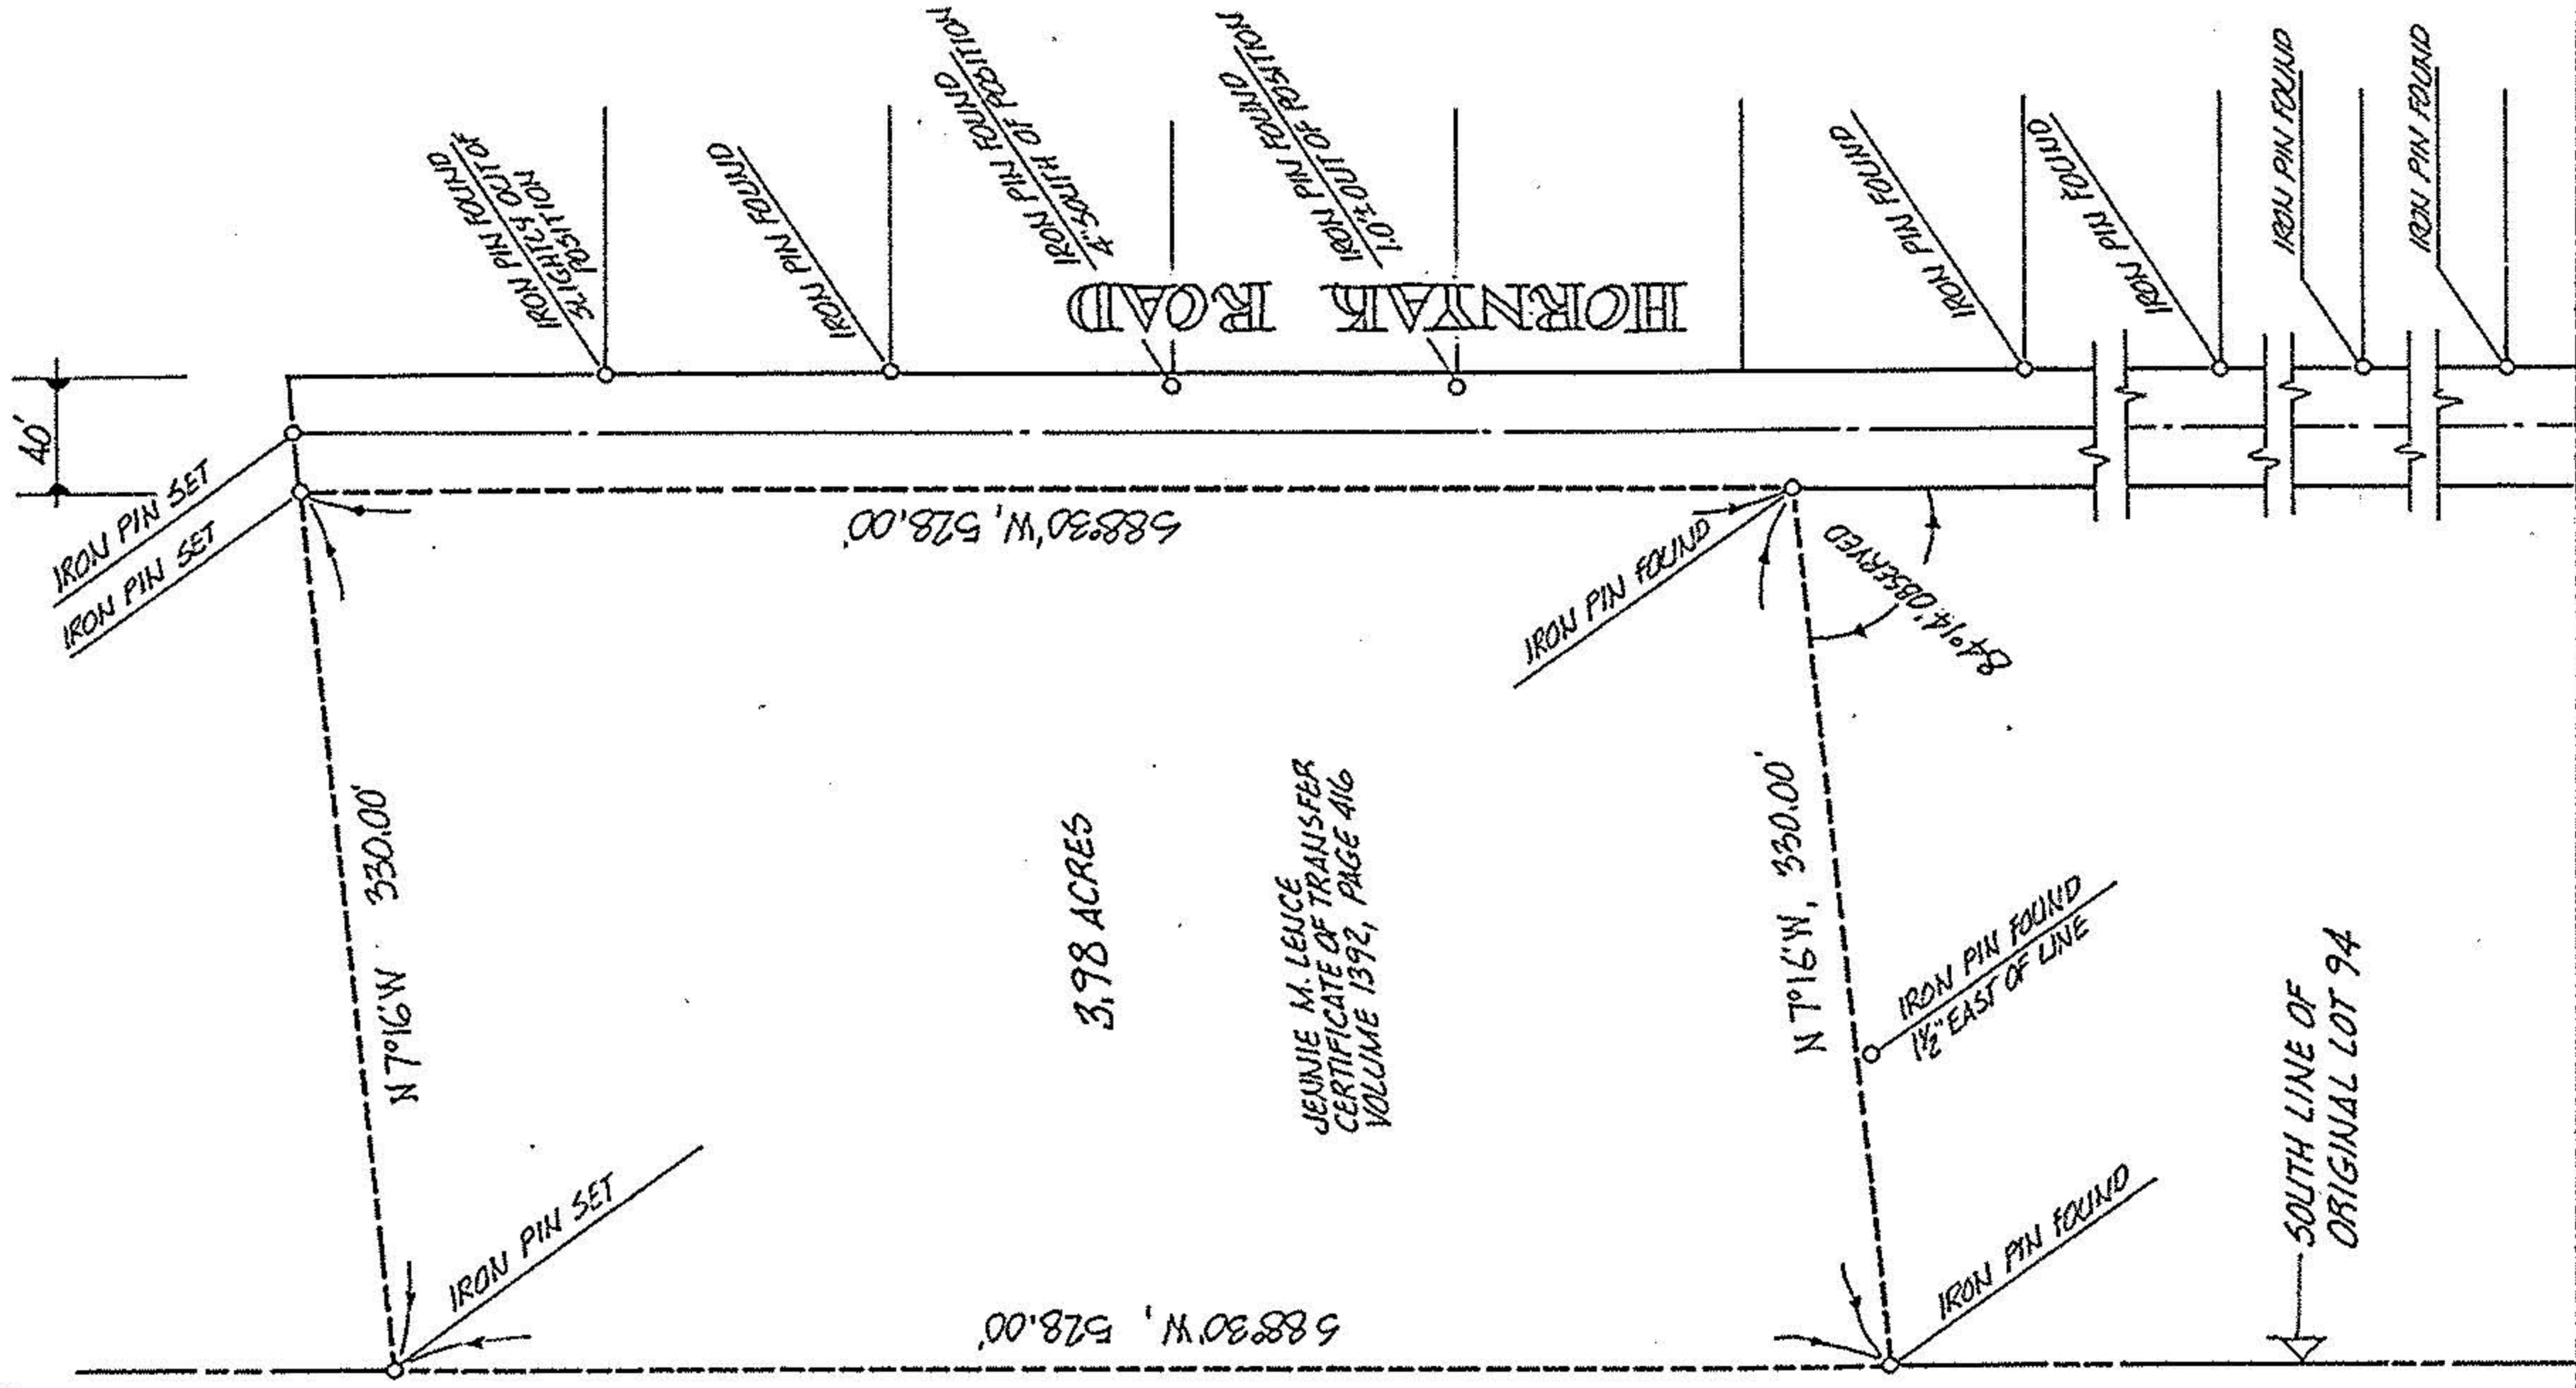

ACREAGE **3.98**
 DATE **06-20-86**
 DRAWN **MGH**
 SCALE **1" = 100 ft.**

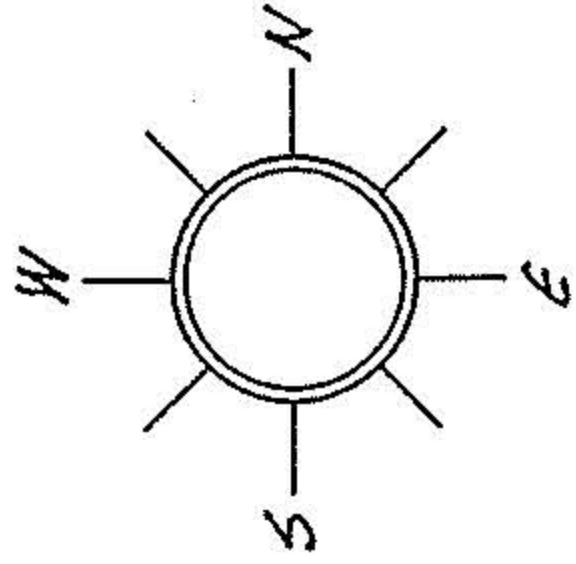

PREPARED FOR **MR. FELIX LENCE**
320 LINCOLN ST., AMHERST, O.

MICHAEL G. HURA, registered surveyor.
 12706 MASON RD., VERMILION, O., Ph (216) 965 4040

PERIMETER SURVEY

SUBLOT(s) _____ of _____ of _____ of PLATS
 PART OF O.L. **74** TRACT _____ SECTION _____ OF
AMHERST TOWNSHIP **LORAIN** CO., OHIO
 PERMANENT PARCEL NO: **05-05-00-094-103-022**

CITY OF _____