
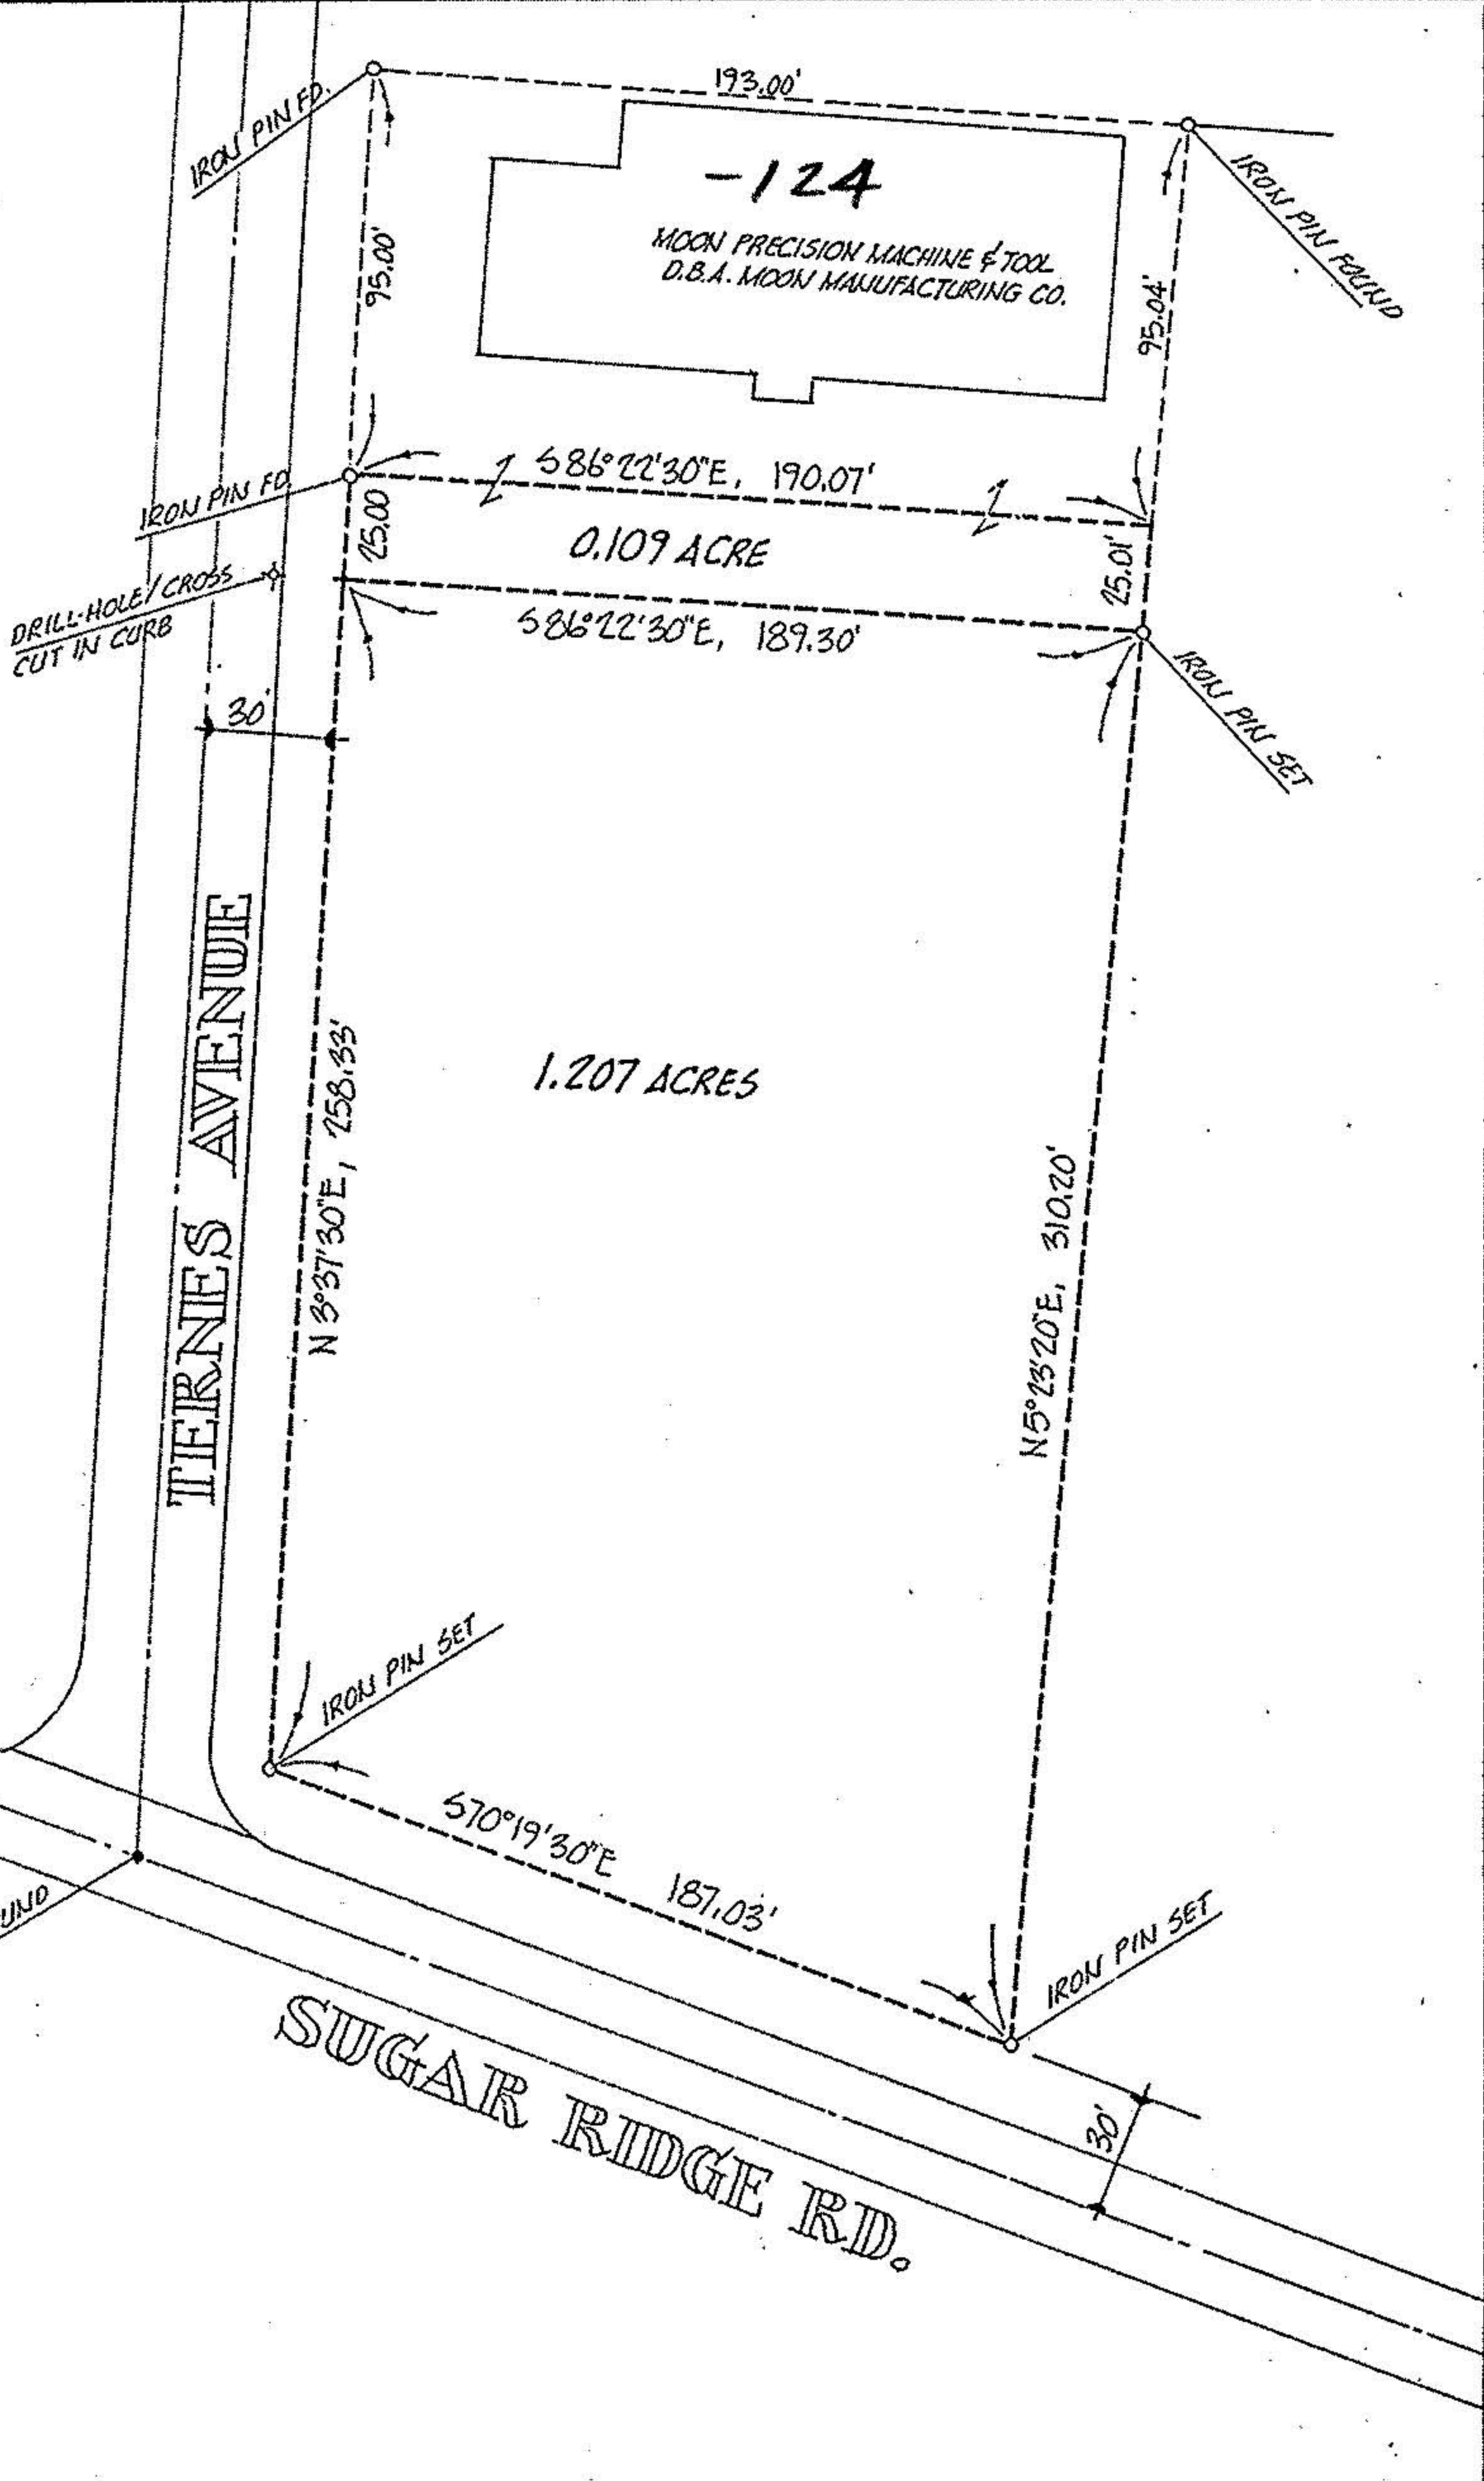


06-25-007-000-0150

06-25-007-000-0150

6-125

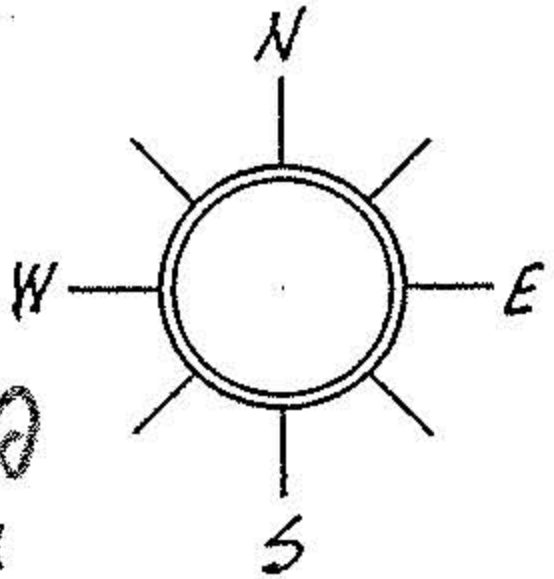

ACREAGE 0.109 & 1.207  
 DATE 06-25-86  
 DRAWN MGH  
 SCALE 1" = 60 ft.

PREPARED FOR MOON MANUFACTURING CO. 365-7676  
588 TERNES AVE, ELYRIA 44035

MICHAEL G. HURA, registered surveyor  
 12706 MASON RD., VERMILION, O., Ph(216) 965 4040

**PERIMETER SURVEY**

SUBLOT(s) \_\_\_\_\_ of \_\_\_\_\_  
 Volume \_\_\_\_\_ Page \_\_\_\_\_ of PLATS  
 PART OF O.L. 7 TRACT EAST OF RIVER SECTION \_\_\_\_\_ OF  
ELYRIA TOWNSHIP LORAIN CO., OHIO  
 PERMANENT PARCEL-Nº 06-25-007-000



CITY OF  
 ELYRIA