


9-00-076-102
9-00-076-A

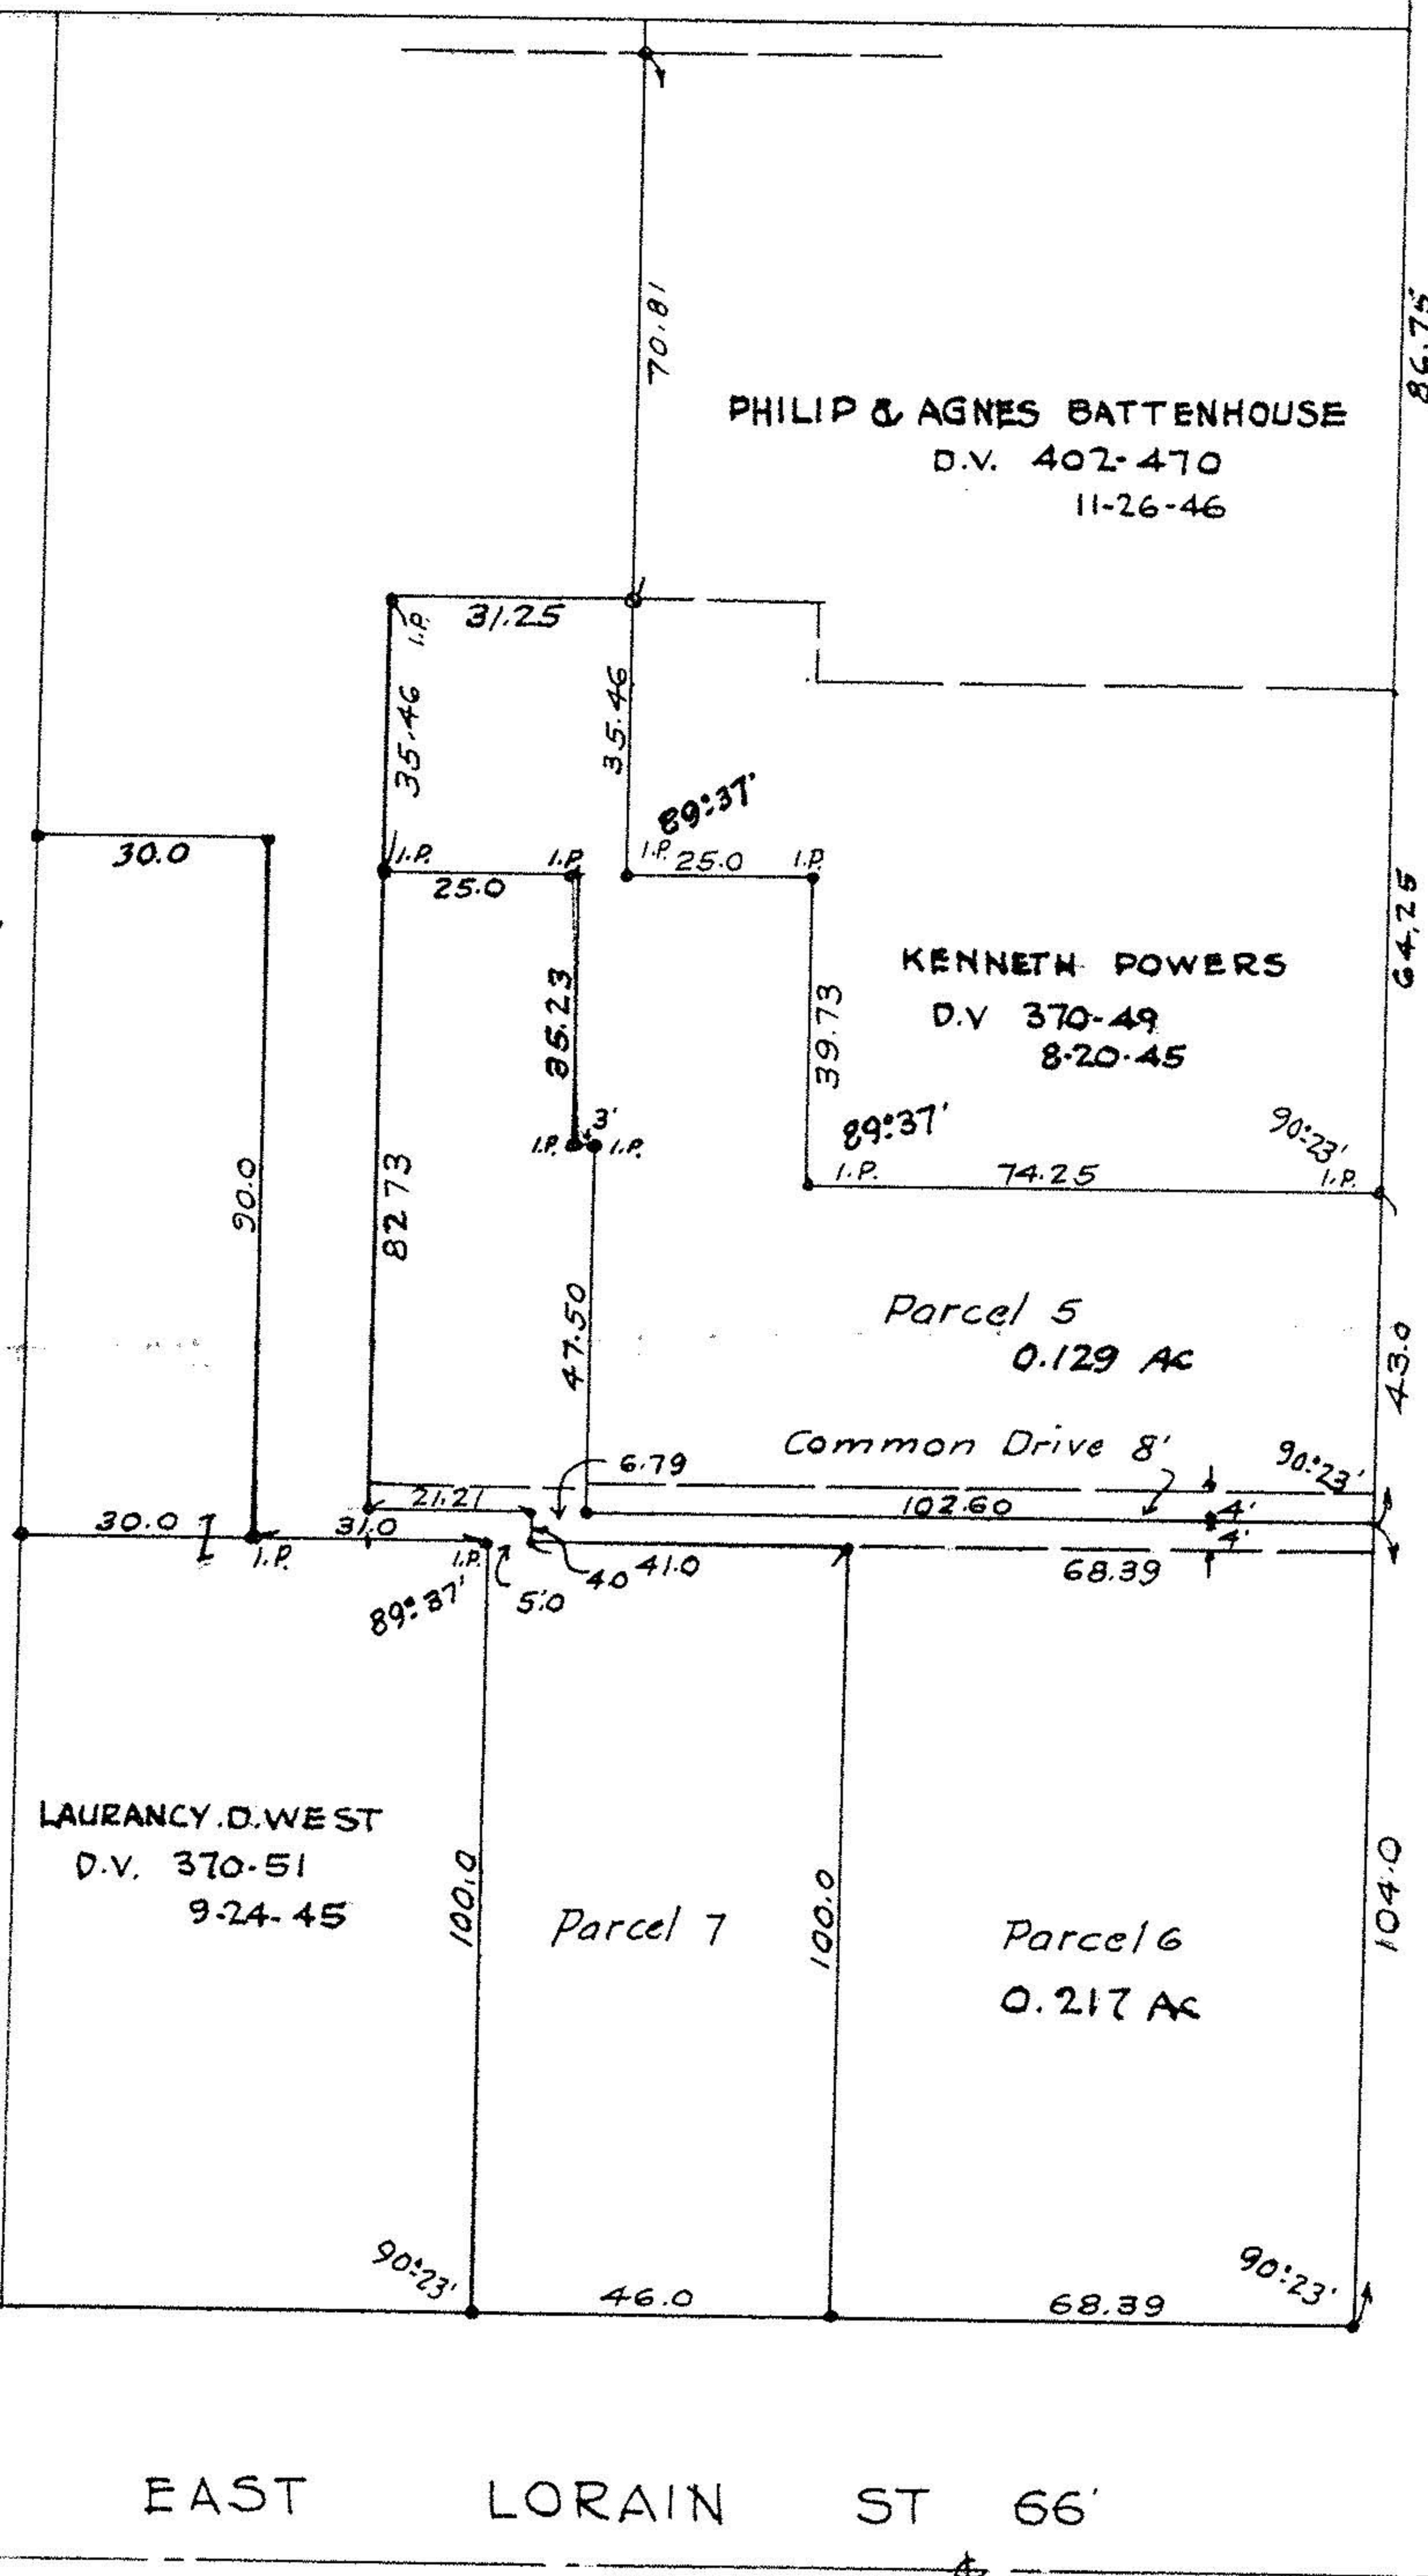

LAURANCY D. WEST
D.V. 370-51
9-24-45

PHILIP & AGNES BATTENHOUSE
D.V. 402-470
11-26-46

KENNETH POWERS
D.V. 370-49
8-20-45

Parcel 5
0.129 AC

Parcel 7

Parcel 6
0.217 AC

EAST LORAIN ST 66'

NORTH PLEASANT ST 49.50'

SURVEY FOR HENRY F. SMITH
 PART OF SUBLOT 113- TWP LOT 76 RUSSIA TWP. OBERLIN VILLAGE
 LORAIN CO. OHIO. SCALE 1" = 30' SEPT 10, 1947
 T.W. LAUNDON REGISTERED SURVEYOR