


9-00-085-112-051
9-00-085-B

WEST COLLEGE ST.

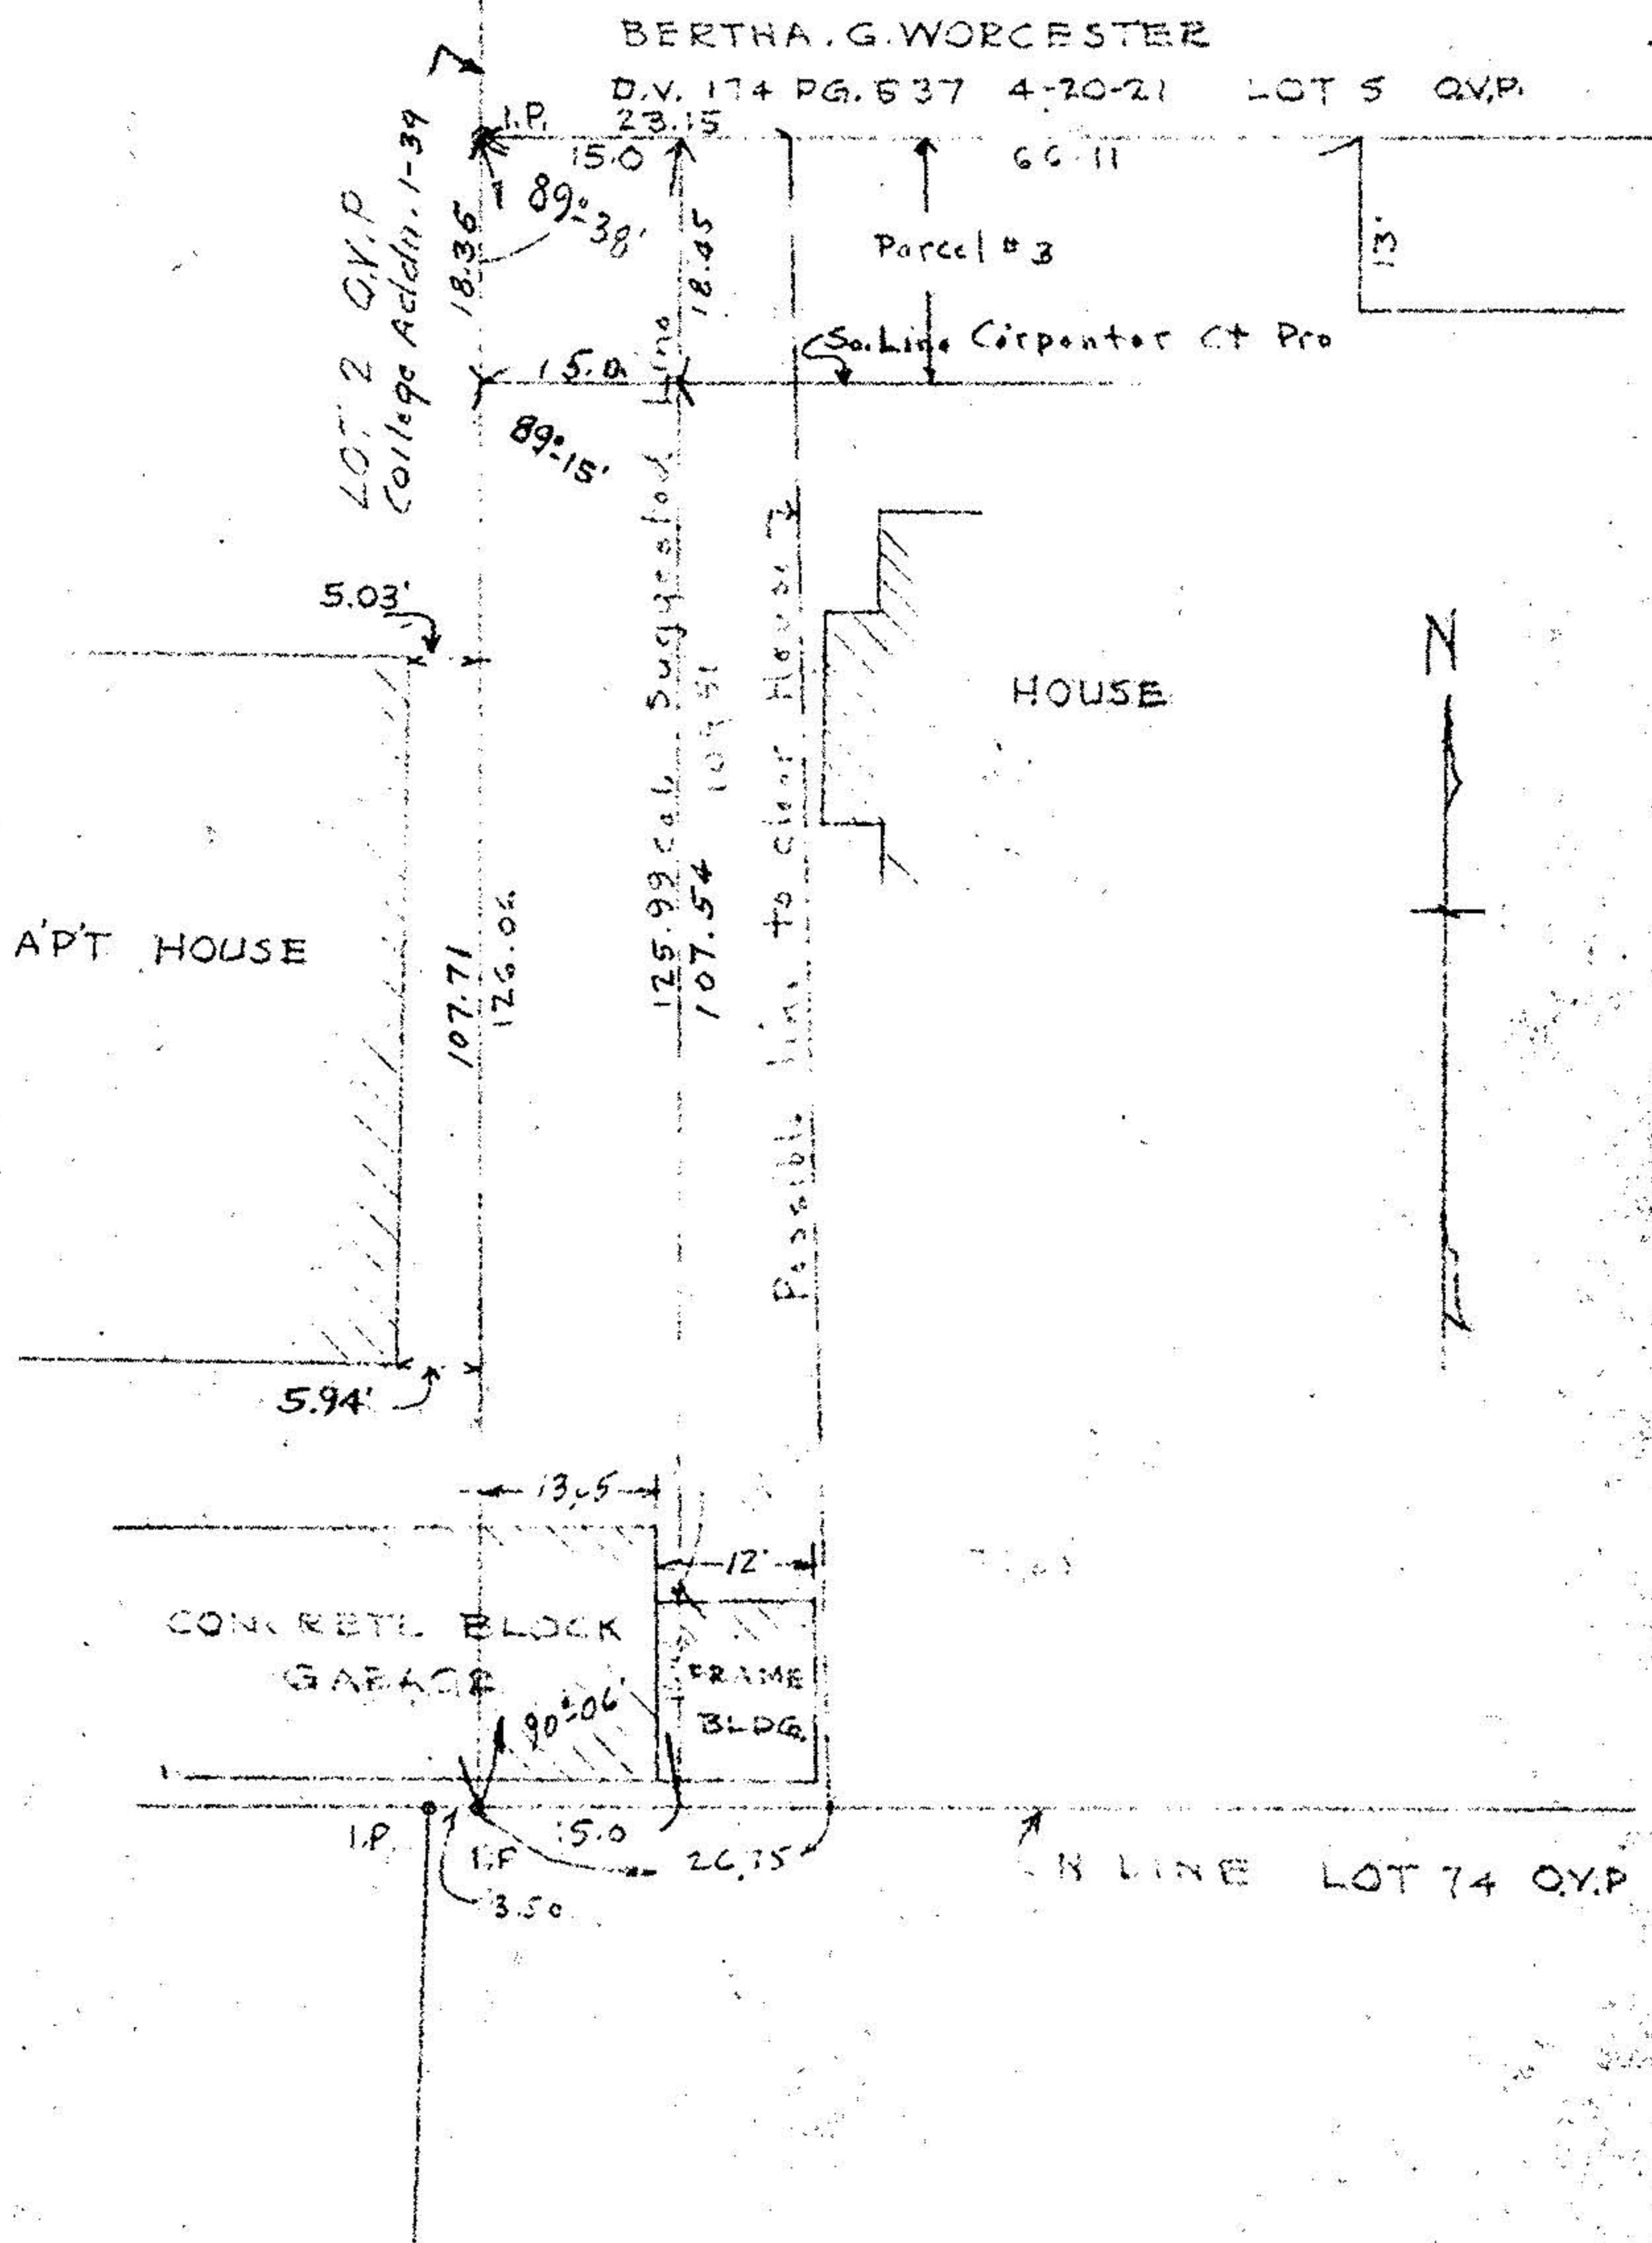

SOUTH MAIN ST.

SURVEY FOR CHARLES E. MOSHER ET AL
 PART OF ORIG. TWP. LOT 85 RUSSIA TWP.
 OBERLIN VILLAGE LORAIN CO. OHIO
 SCALE 1" = 20' JAN 30, 1948
 T.W. LINDON REGISTERED SURVEYOR
 REV. 2-13-48