




KLEINOEDER-SCHMIDT and ASSOCIATES

ENGINEERS — SURVEYORS — CONSULTANTS IN LAND PLANNING
ELYRIA • NORWALK • MEDINA OHIO

SURVEY

Sublot(s) _____
Subd'n _____

Township PITTSFIELD Tract _____
Orig. Lot(s) 101 Sec. _____
County of LORAIN State of Ohio
Corporation _____

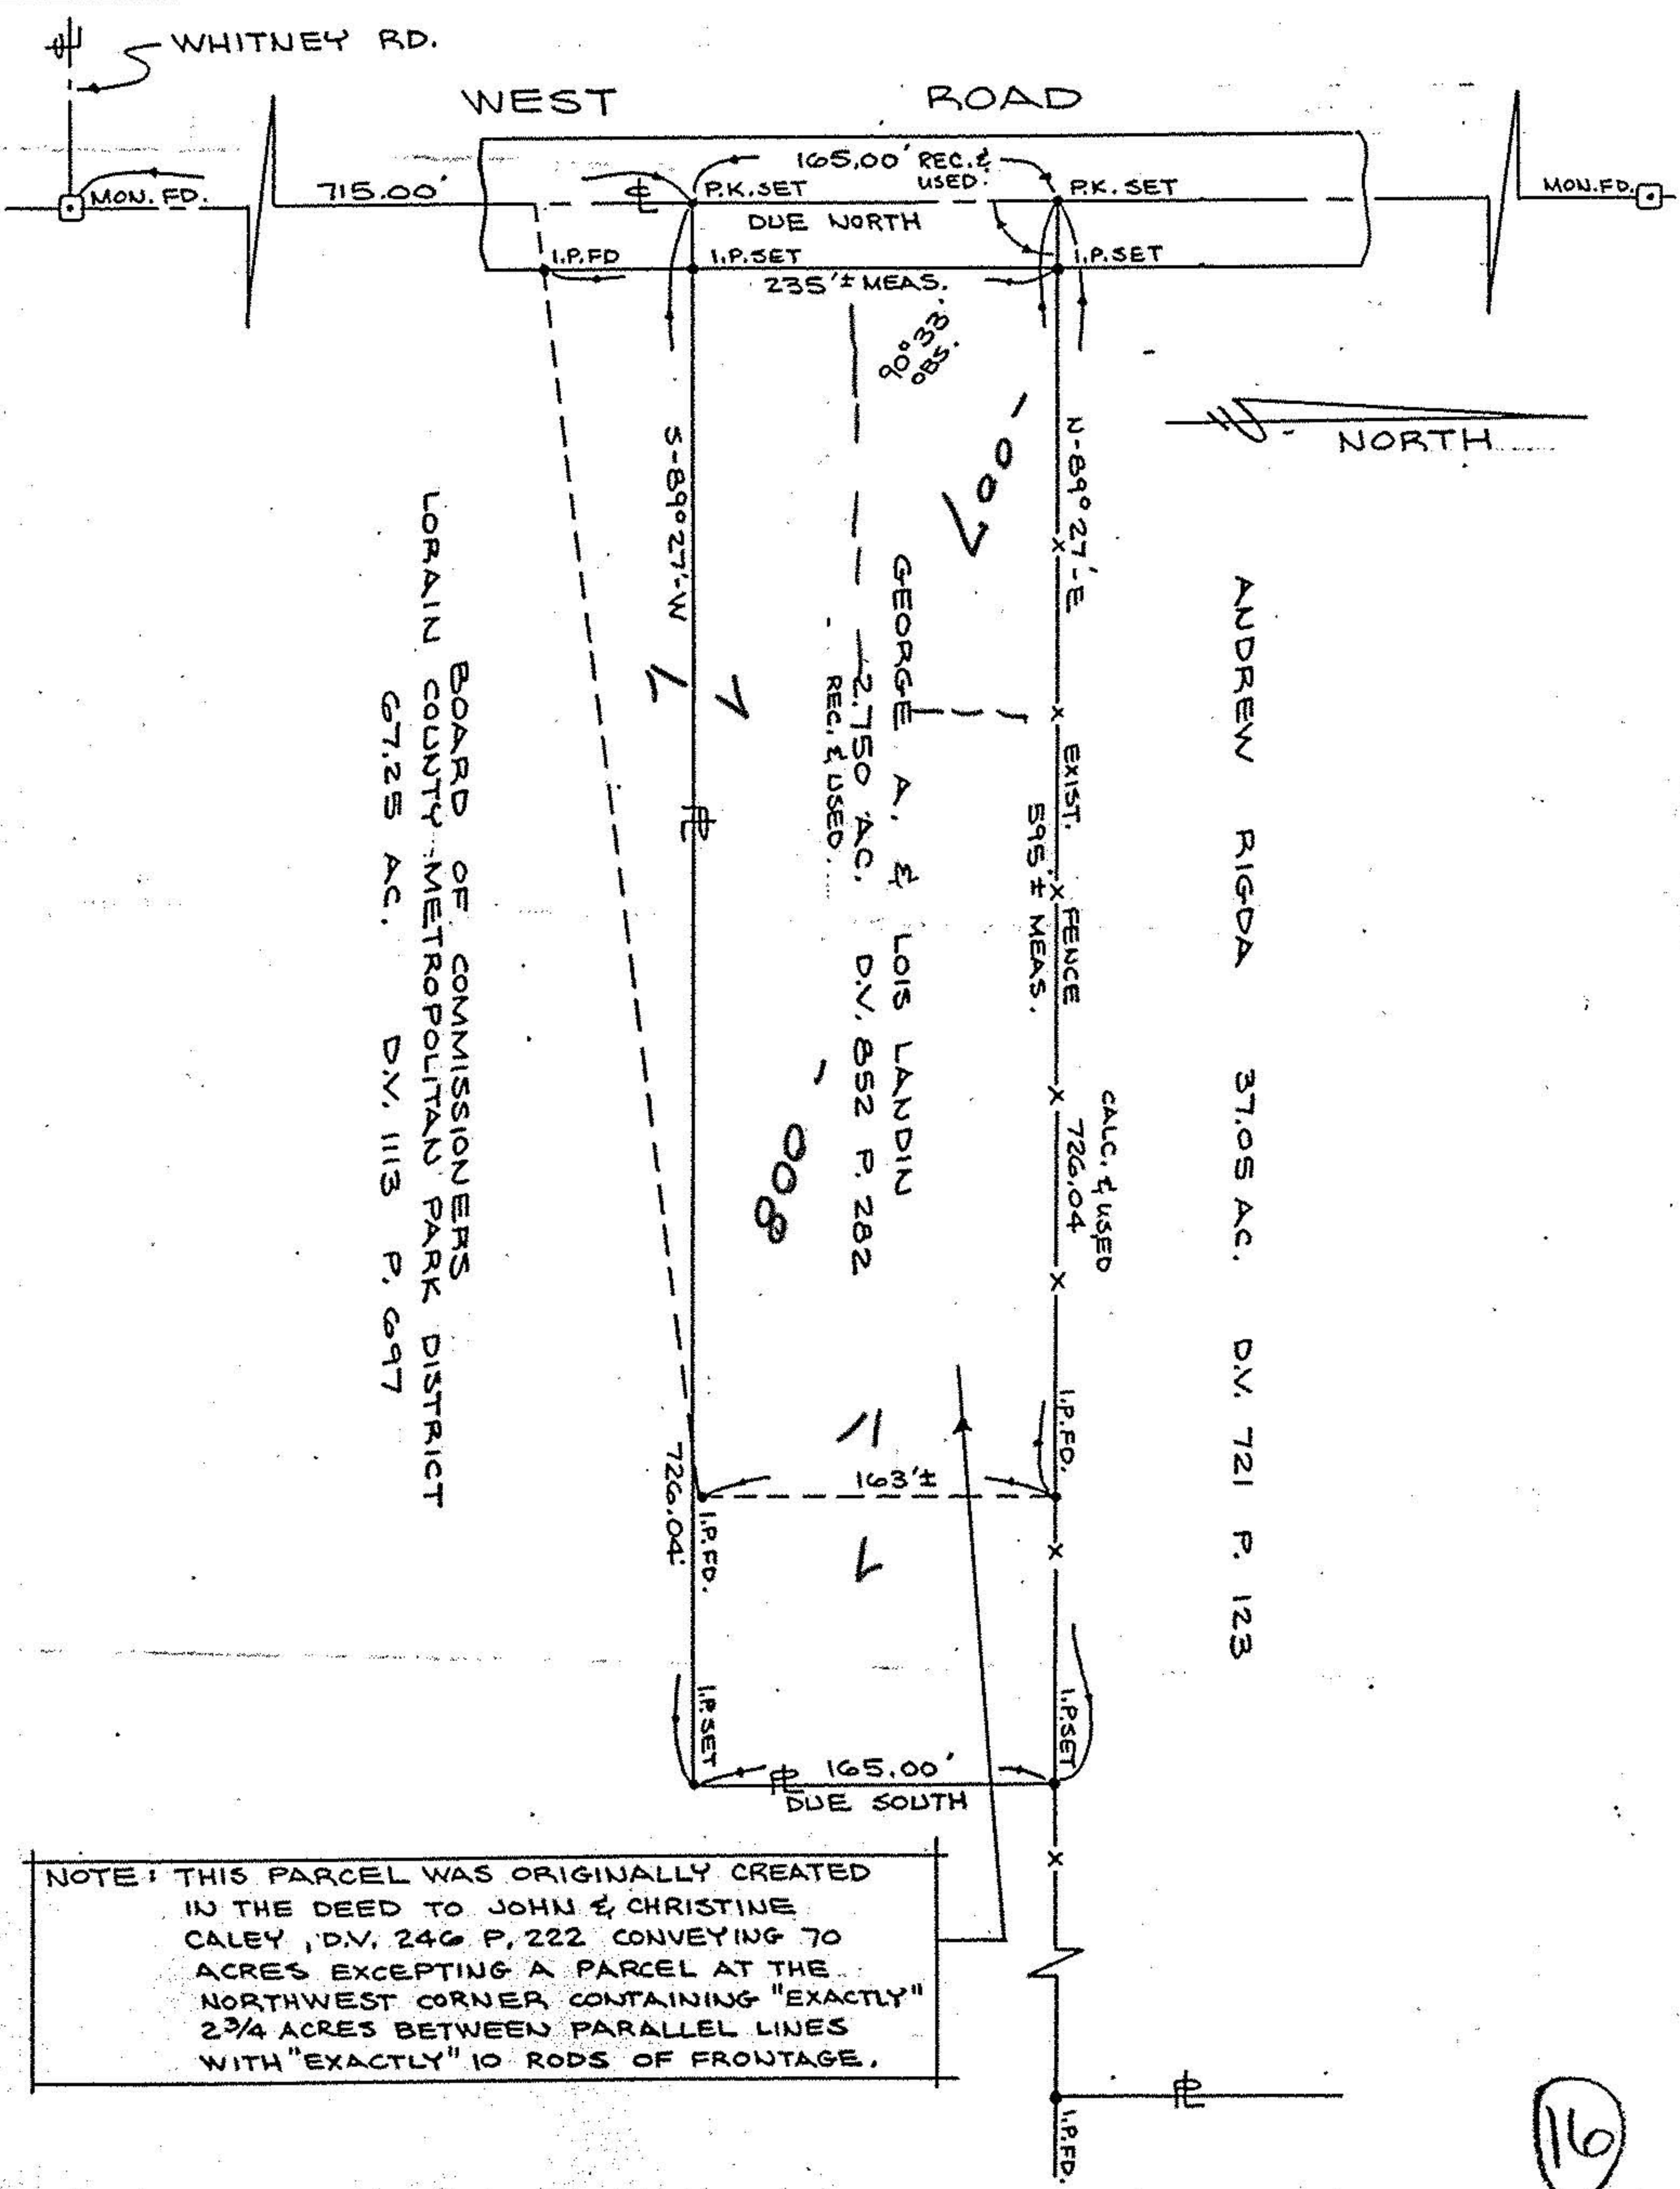

NOTE: THIS PARCEL WAS ORIGINALLY CREATED IN THE DEED TO JOHN & CHRISTINE CALEY, D.V. 246 P. 222 CONVEYING 70 ACRES EXCEPTING A PARCEL AT THE NORTHWEST CORNER CONTAINING "EXACTLY" 2 3/4 ACRES BETWEEN PARALLEL LINES WITH "EXACTLY" 10 RODS OF FRONTAGE.

16

Prepared for: **ED LANDIN**
154 S. LOGAN STREET
ELYRIA, OHIO

Scale: 1" = 100' Date: NOV. 4, 1976 Dr. by: *RS* Job No: 76-335

14-H

14-00-101-000