



18-00-034-000-007
 18-00-034-000-009
 18-00-034-000-011
 18-00-034-B


MEDINA-NORWALK RD

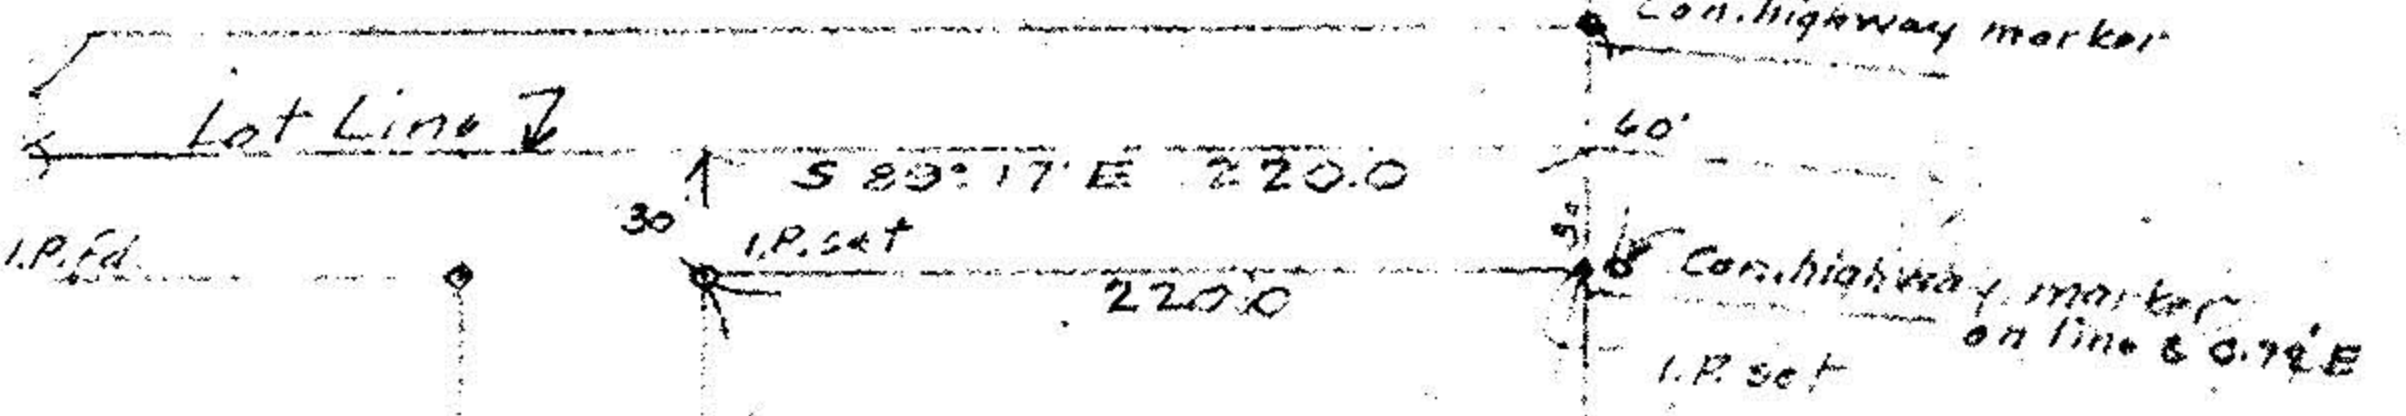

1.427 Acres
 E. St.

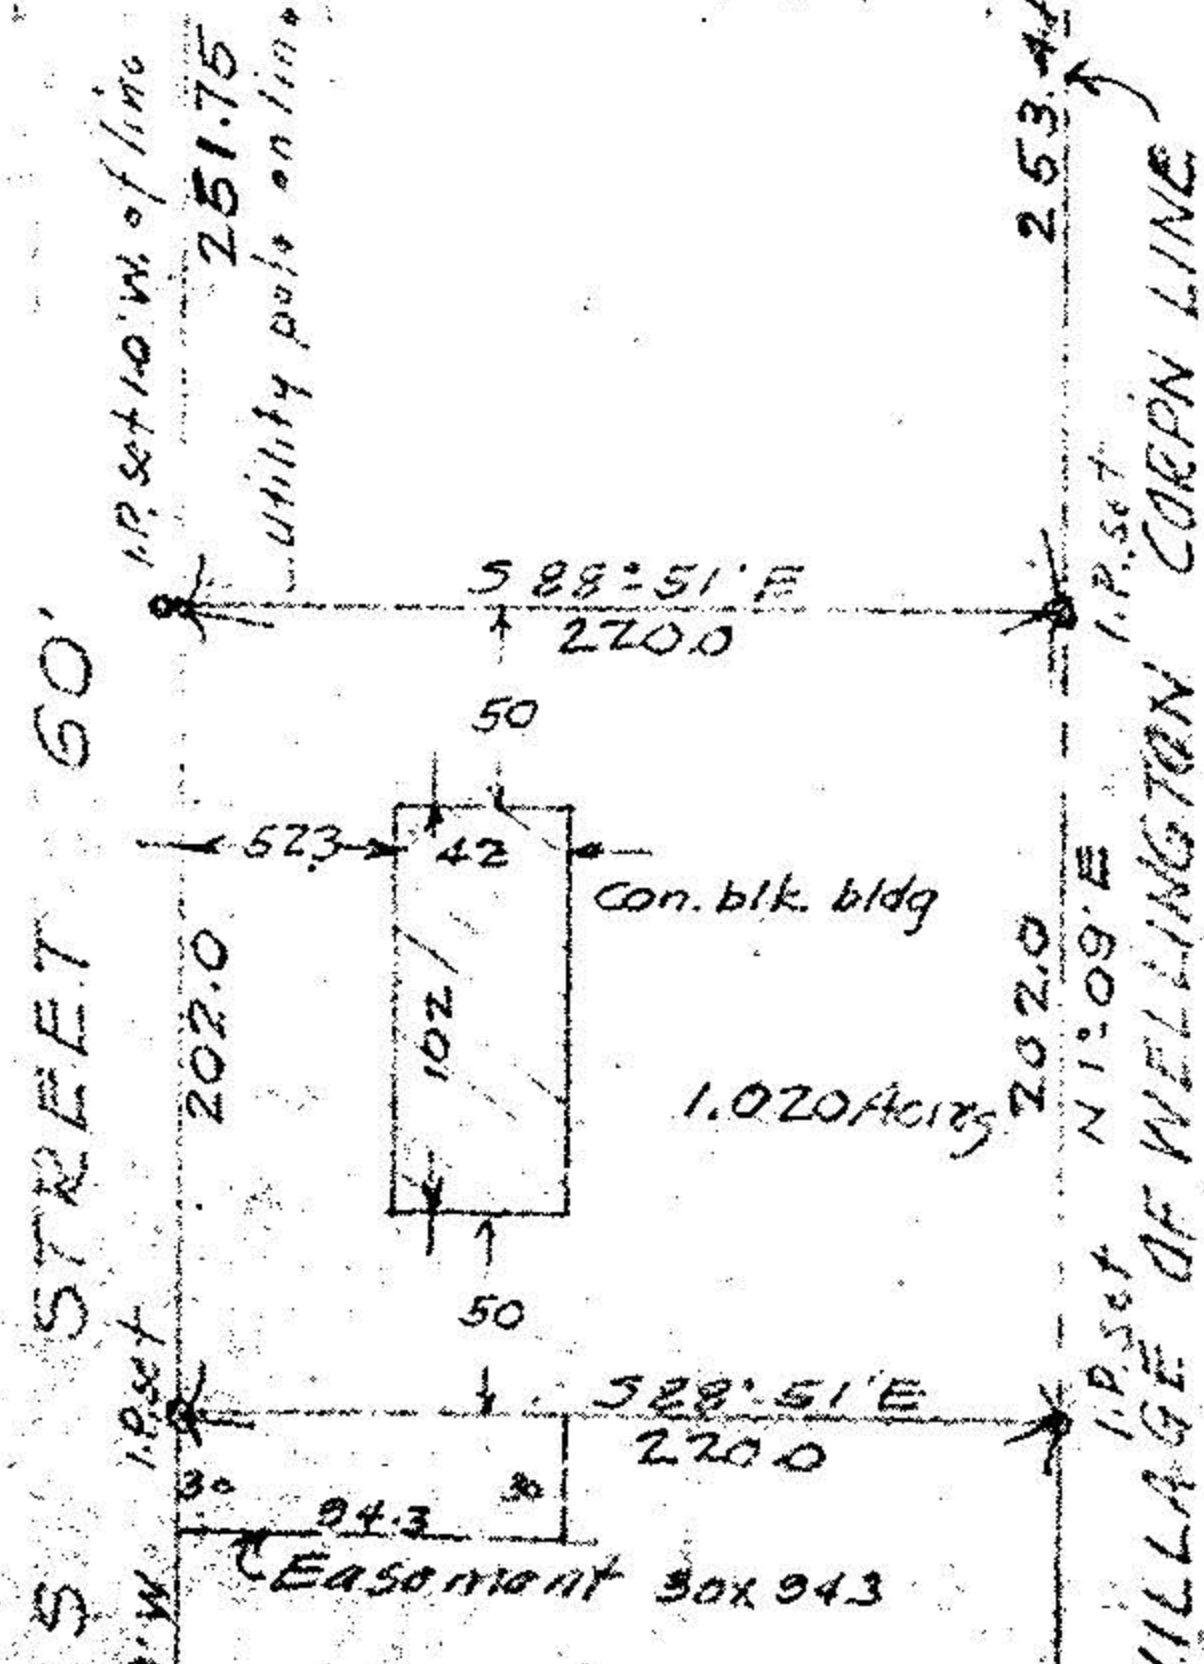

1.427 Acres
 1.514 0

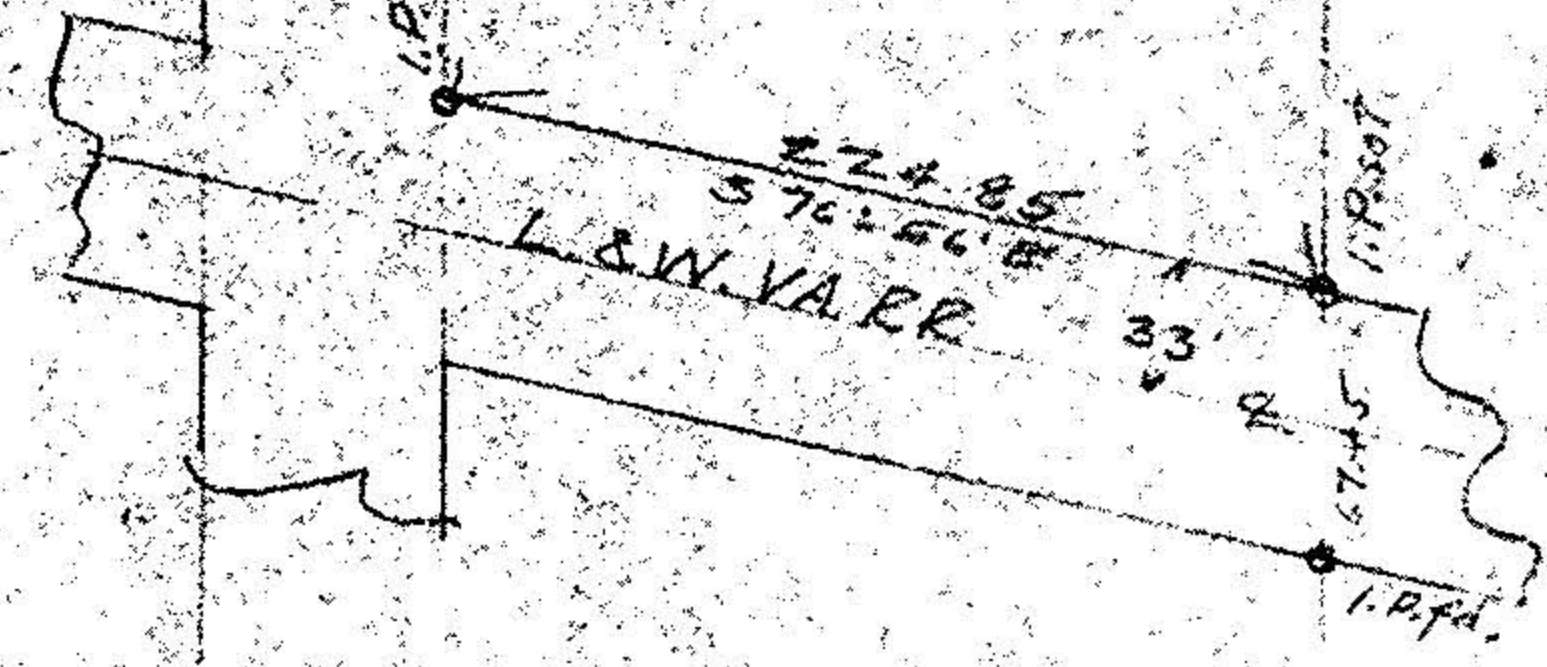

SURVEY FOR CLIFFORD W. UNSER
 PART OF ORIG. LOT 34 WELLINGTON TWP
 LORAIN CO. OHIO SCALE 1"=100'
 JAN. 7. 1949 T.W. LAUNDON REGISTERED SURVEYOR