


P.P.N 01-00-064-000-059

- monument box
- iron pipes fd
- iron pipes set


NO.	5049	78/8739
DATE		

PROPERTY OF  
Nancy Smith

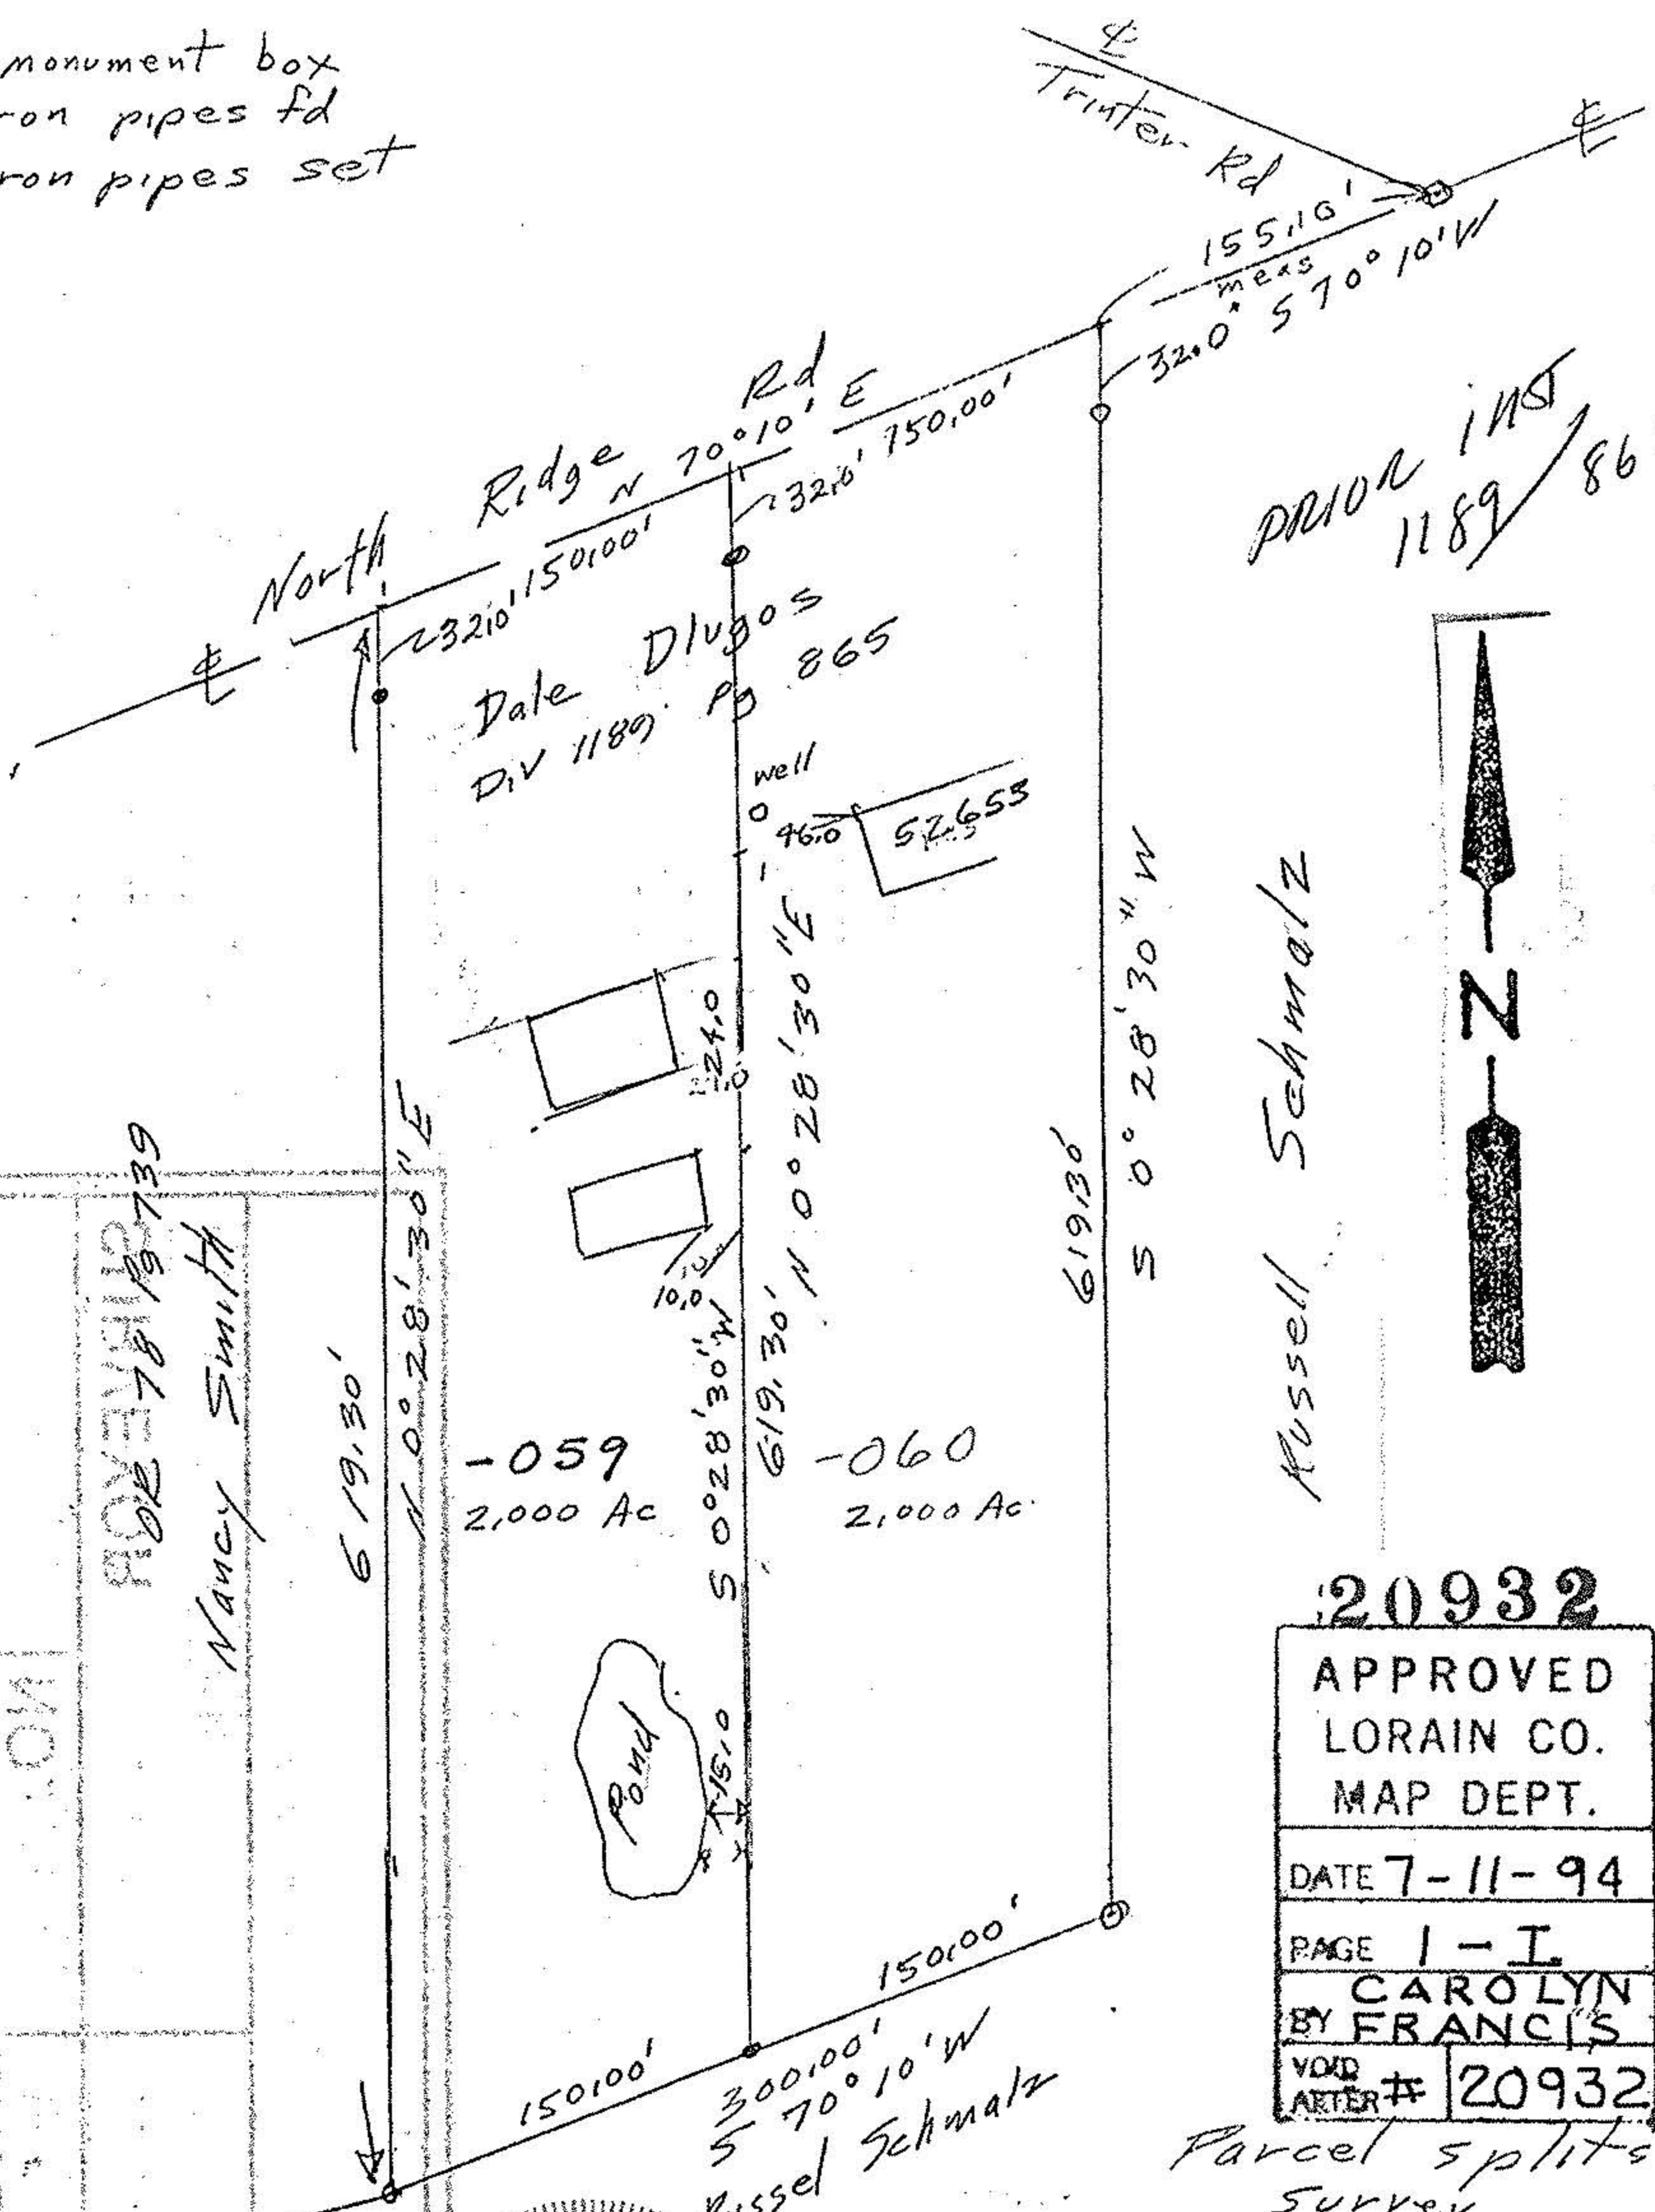

PRIOR INSTR  
1189/865

Russell Schmalz

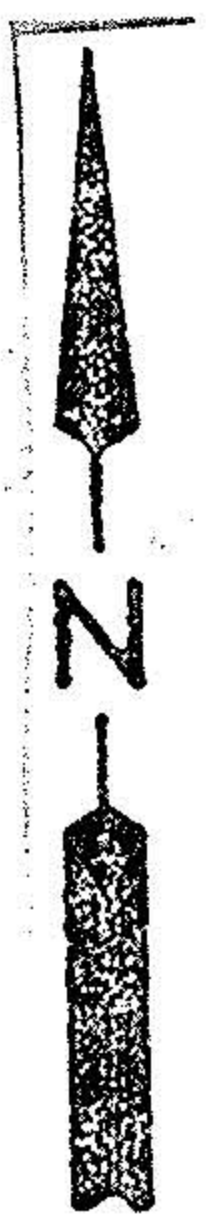

20932

APPROVED  
 LORAIN CO.  
 MAP DEPT.

DATE 7-11-94

PAGE 1-I

CAROLYN  
 BY FRANCIS

VOID AFTER # 20932

Parcel splits  
 survey  
 of land owned by  
 Dale Dugos  
 Original Lot 64  
 Brownhelm Township  
 Lorain County Ohio  
 scale 1" = 100 Apr 1994

John Pozywak  
 Reg Surveyor  
 5292

