


Map of part of O.L. 71 Brownhelm Twp. Lorain Co. Ohio

Scale 1" = 100'

May 19, 1987

By Arnold F. Koepf Reg. Surveyor No. 4306

Map revised Aug. 17, 1987 85x 2255' Parcel

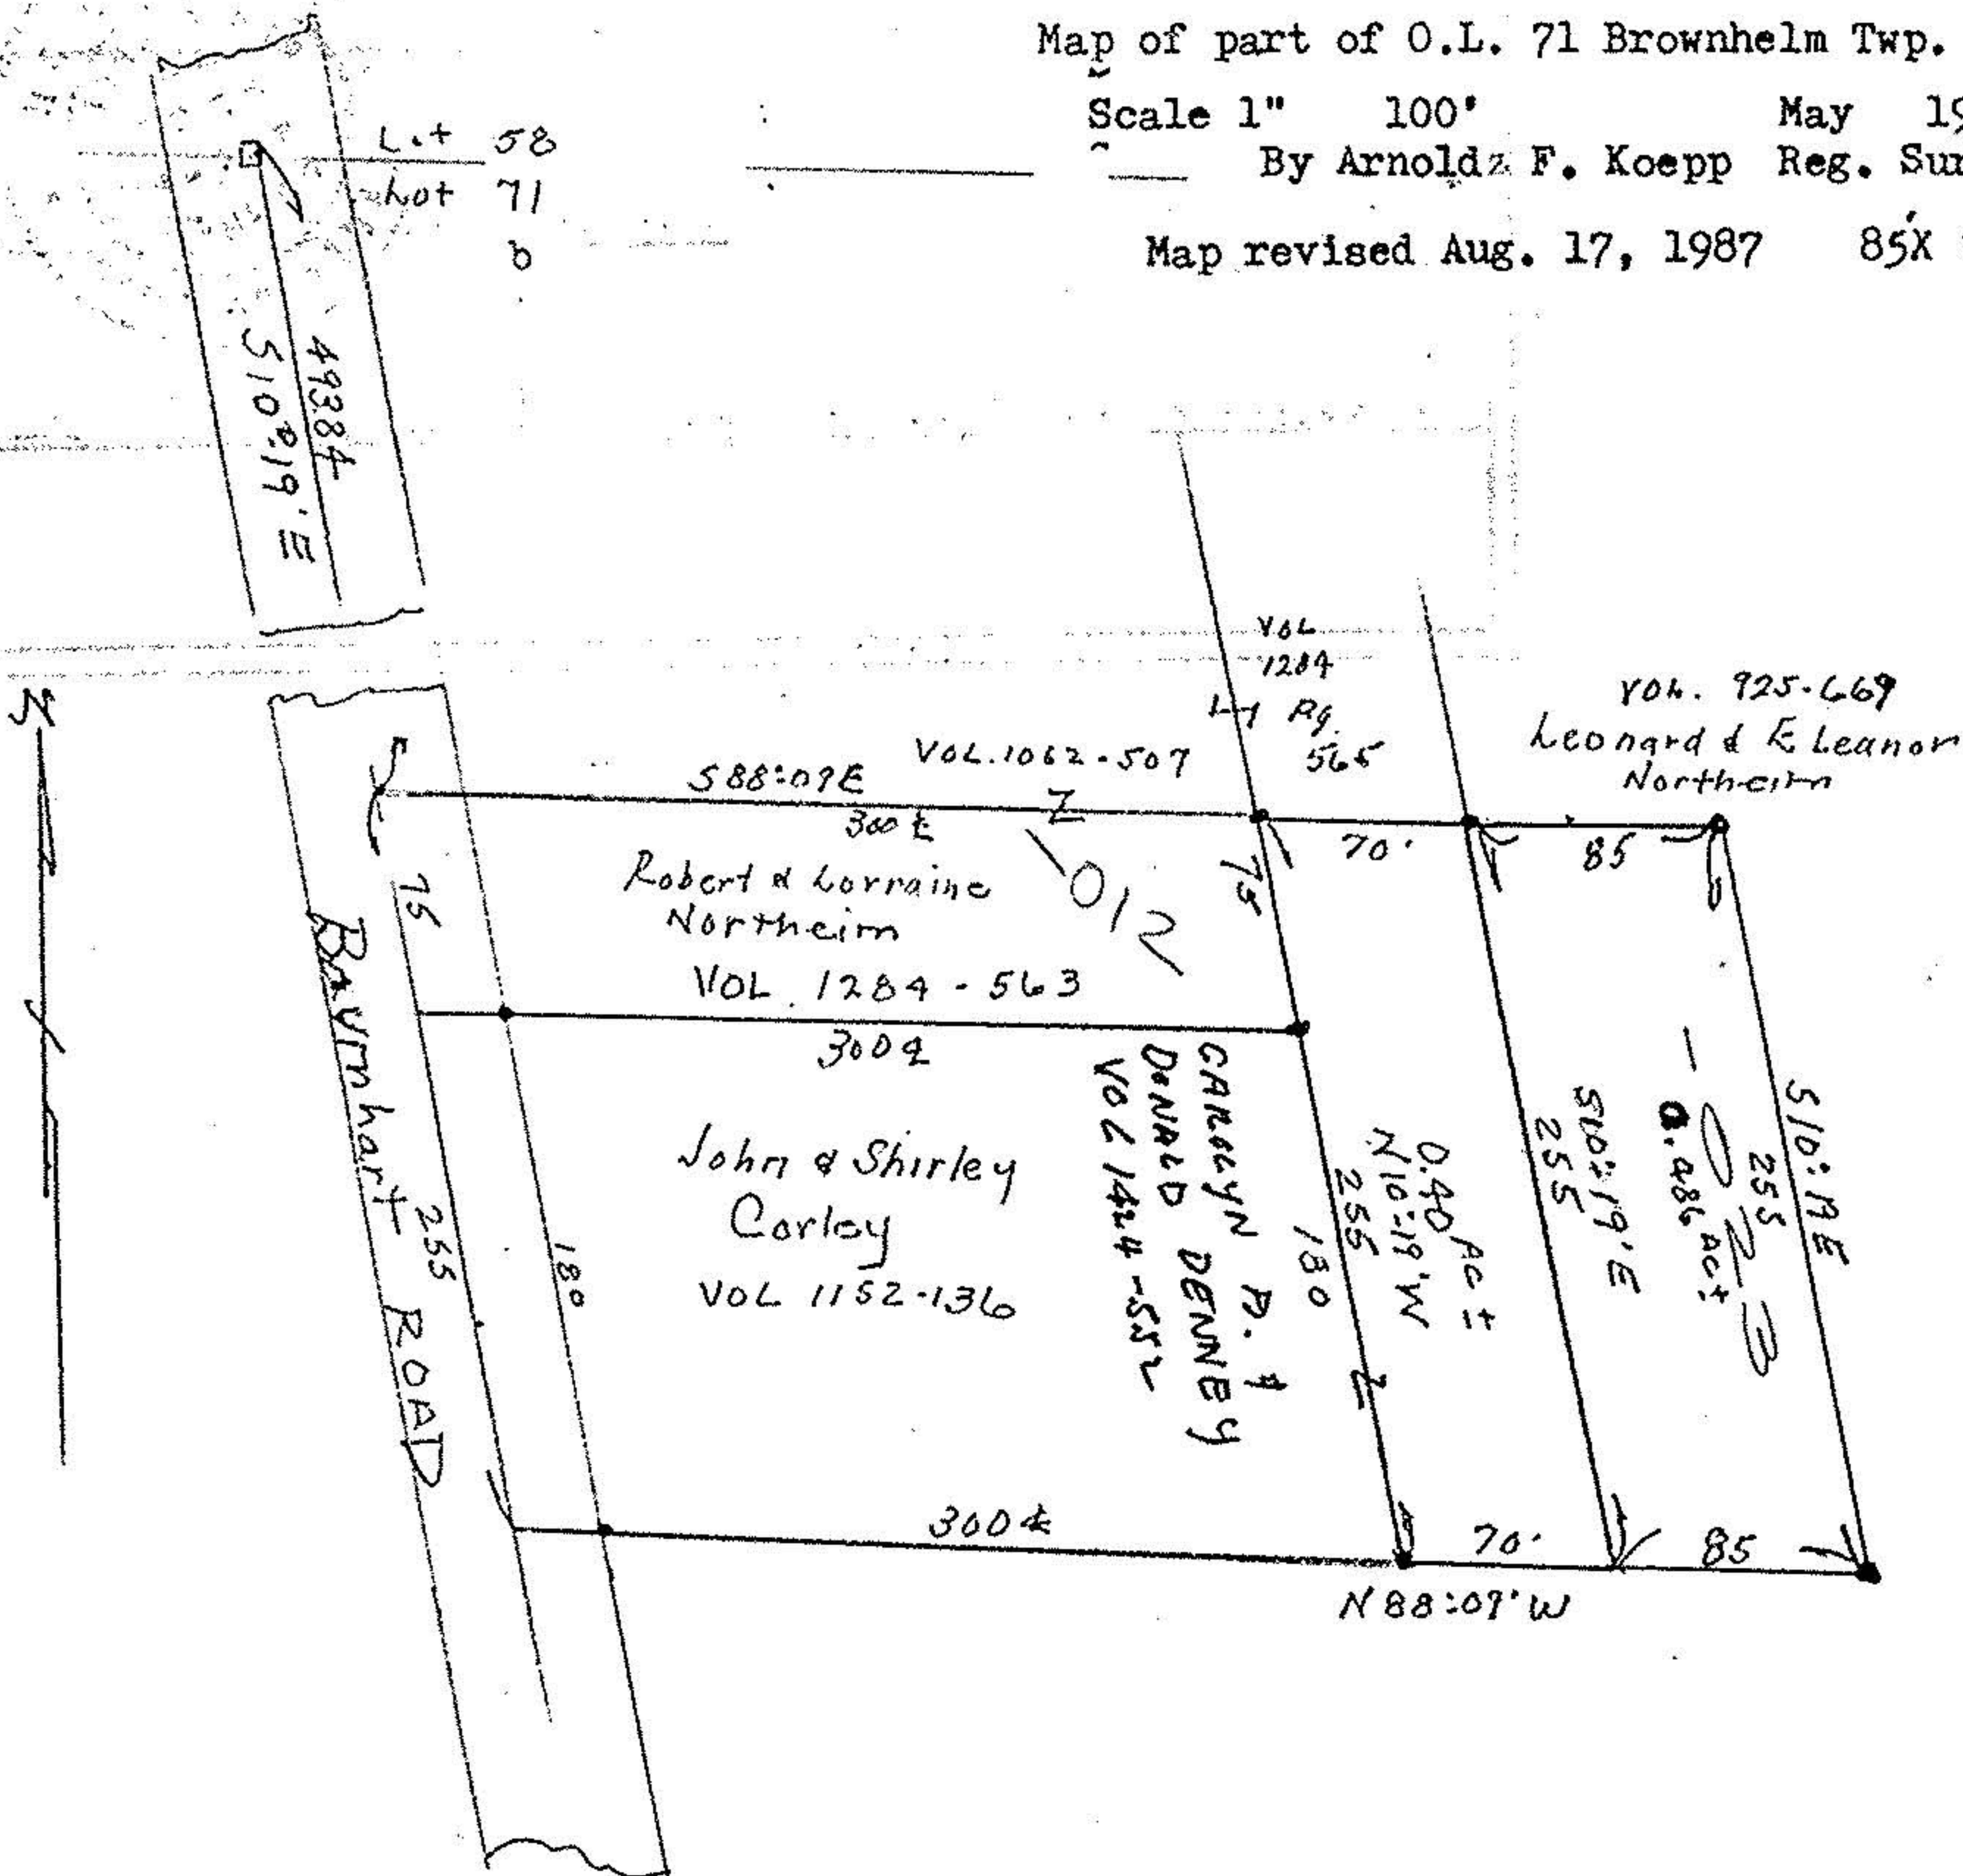

# 17691

APPROVED LORAIN CO. MAP DEPT.	
DATE	9-23-87
PAGE	1-1
BY	C. Francis
VOID AFTER	17691