


NORTH

LEGEND: Iron Rod Found  
1/2" Iron Rod Set

SCALE  
1" = 100'

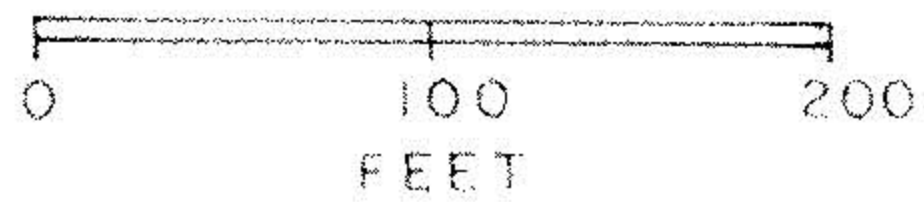

~~01-00-074-000-029~~  
NEED SURVEY TO 30  
FILE INFORMATION SHEET

REFERENCE: DEDICATION PLAT OF STICK ROAD (60')  
PLAT VOL. 25, P.4, 10/24/67

CURVE NO. 2  
Delta = 3°23'13", D = 1°30'  
R = 3819.72', T = 112.93', L = 225.80'

STICK ROAD (60')  
BROWNHELM TOWNSHIP TRUSTEES

#00303


APPROVED  
LORAIN CO.  
MAP DEPT

DATE 12-20-99

PAGE 1-00-074 B

BY *J. Tolbert*

#00303

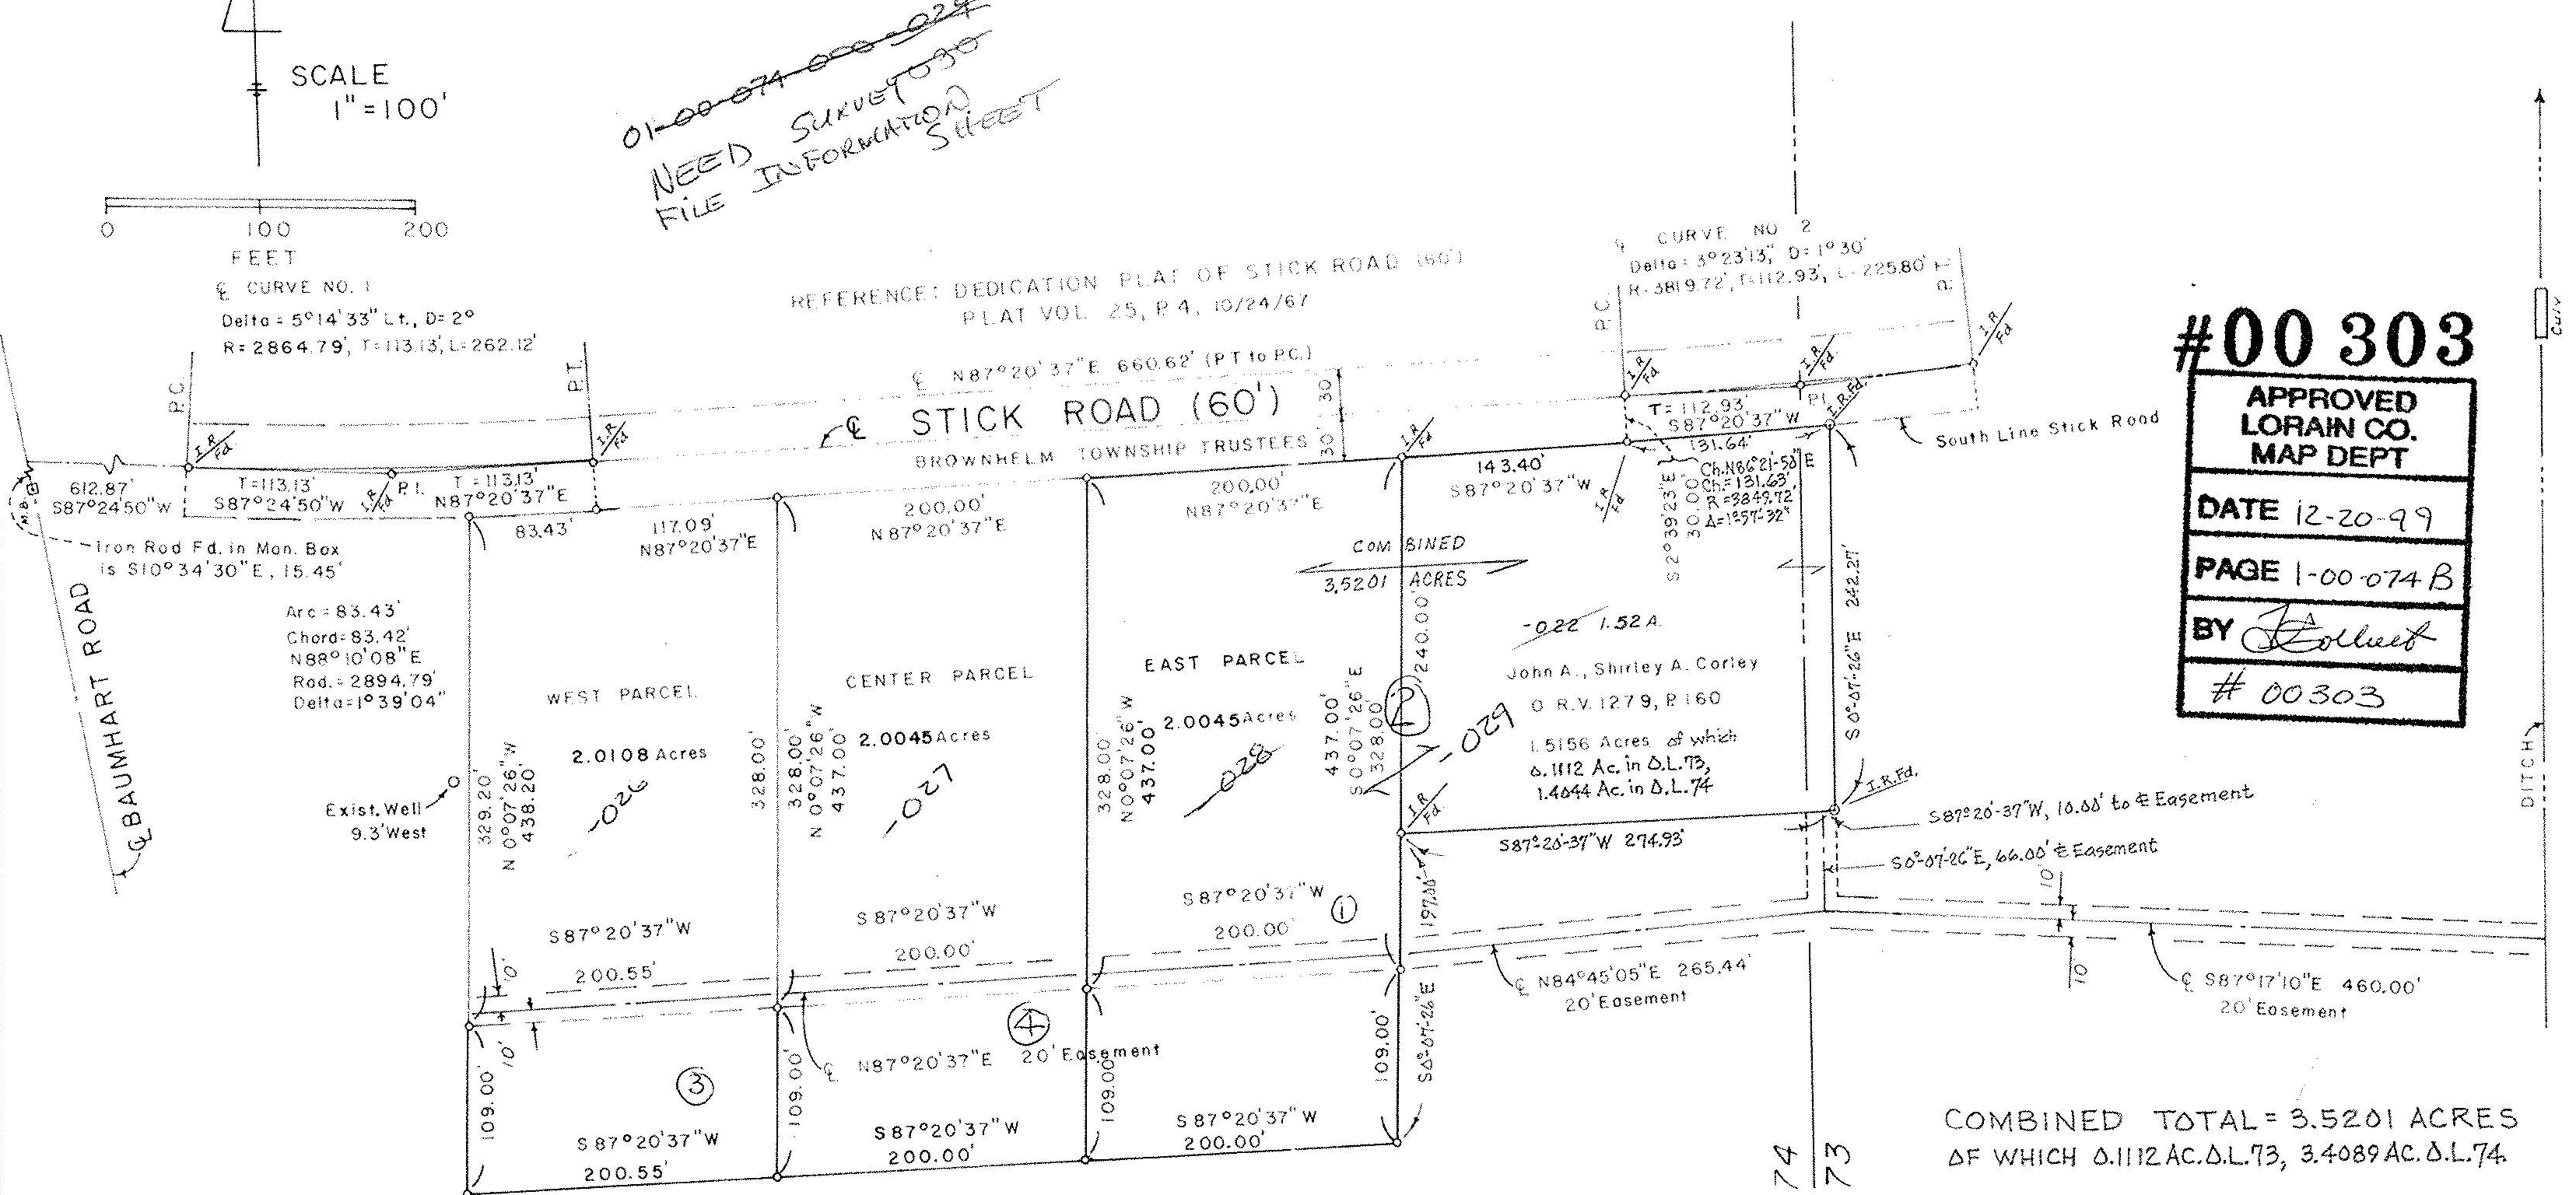

COMBINED TOTAL = 3.5201 ACRES  
OF WHICH 0.1112 AC. Δ.L. 73, 3.4089 AC. Δ.L. 74

-023 81.27 A.  
Dwight J. Miller  
V. 865, P. 307  
David D. Miller and Roger G. Miller  
O.R.V. 394, P. 334

MAP OF SURVEY MADE  
PART OF ORIGINAL LOT NO. 74, 73,  
BROWNHELM TWP, LORAIN CO., OHIO  
FOR D. MILLER  
BY CHARLES P. WARYU, REG. SURVEYOR  
NO. 5029

*Charles P. Waryu*  
CHARLES P. WARYU, REGISTERED SURVEYOR NO. 5029

AUGUST, 1999  
Revised November, 1999 Combined-022 with EAST PARCEL