

1-J

Map of Part of Lot 78 Brownhelm Twp. Lorain Co. Ohio
Scale 1" 100' March 8, 1985
By Arnold F. Koepp Reg. Surveyor No. 4306

51-55-513 3000

#16144


APPROVED
LORAIN CO.
MAP DEPT.

DATE 4.24.85

PAGE 1-J

BY: T. McMain

VOID
IF
RETR

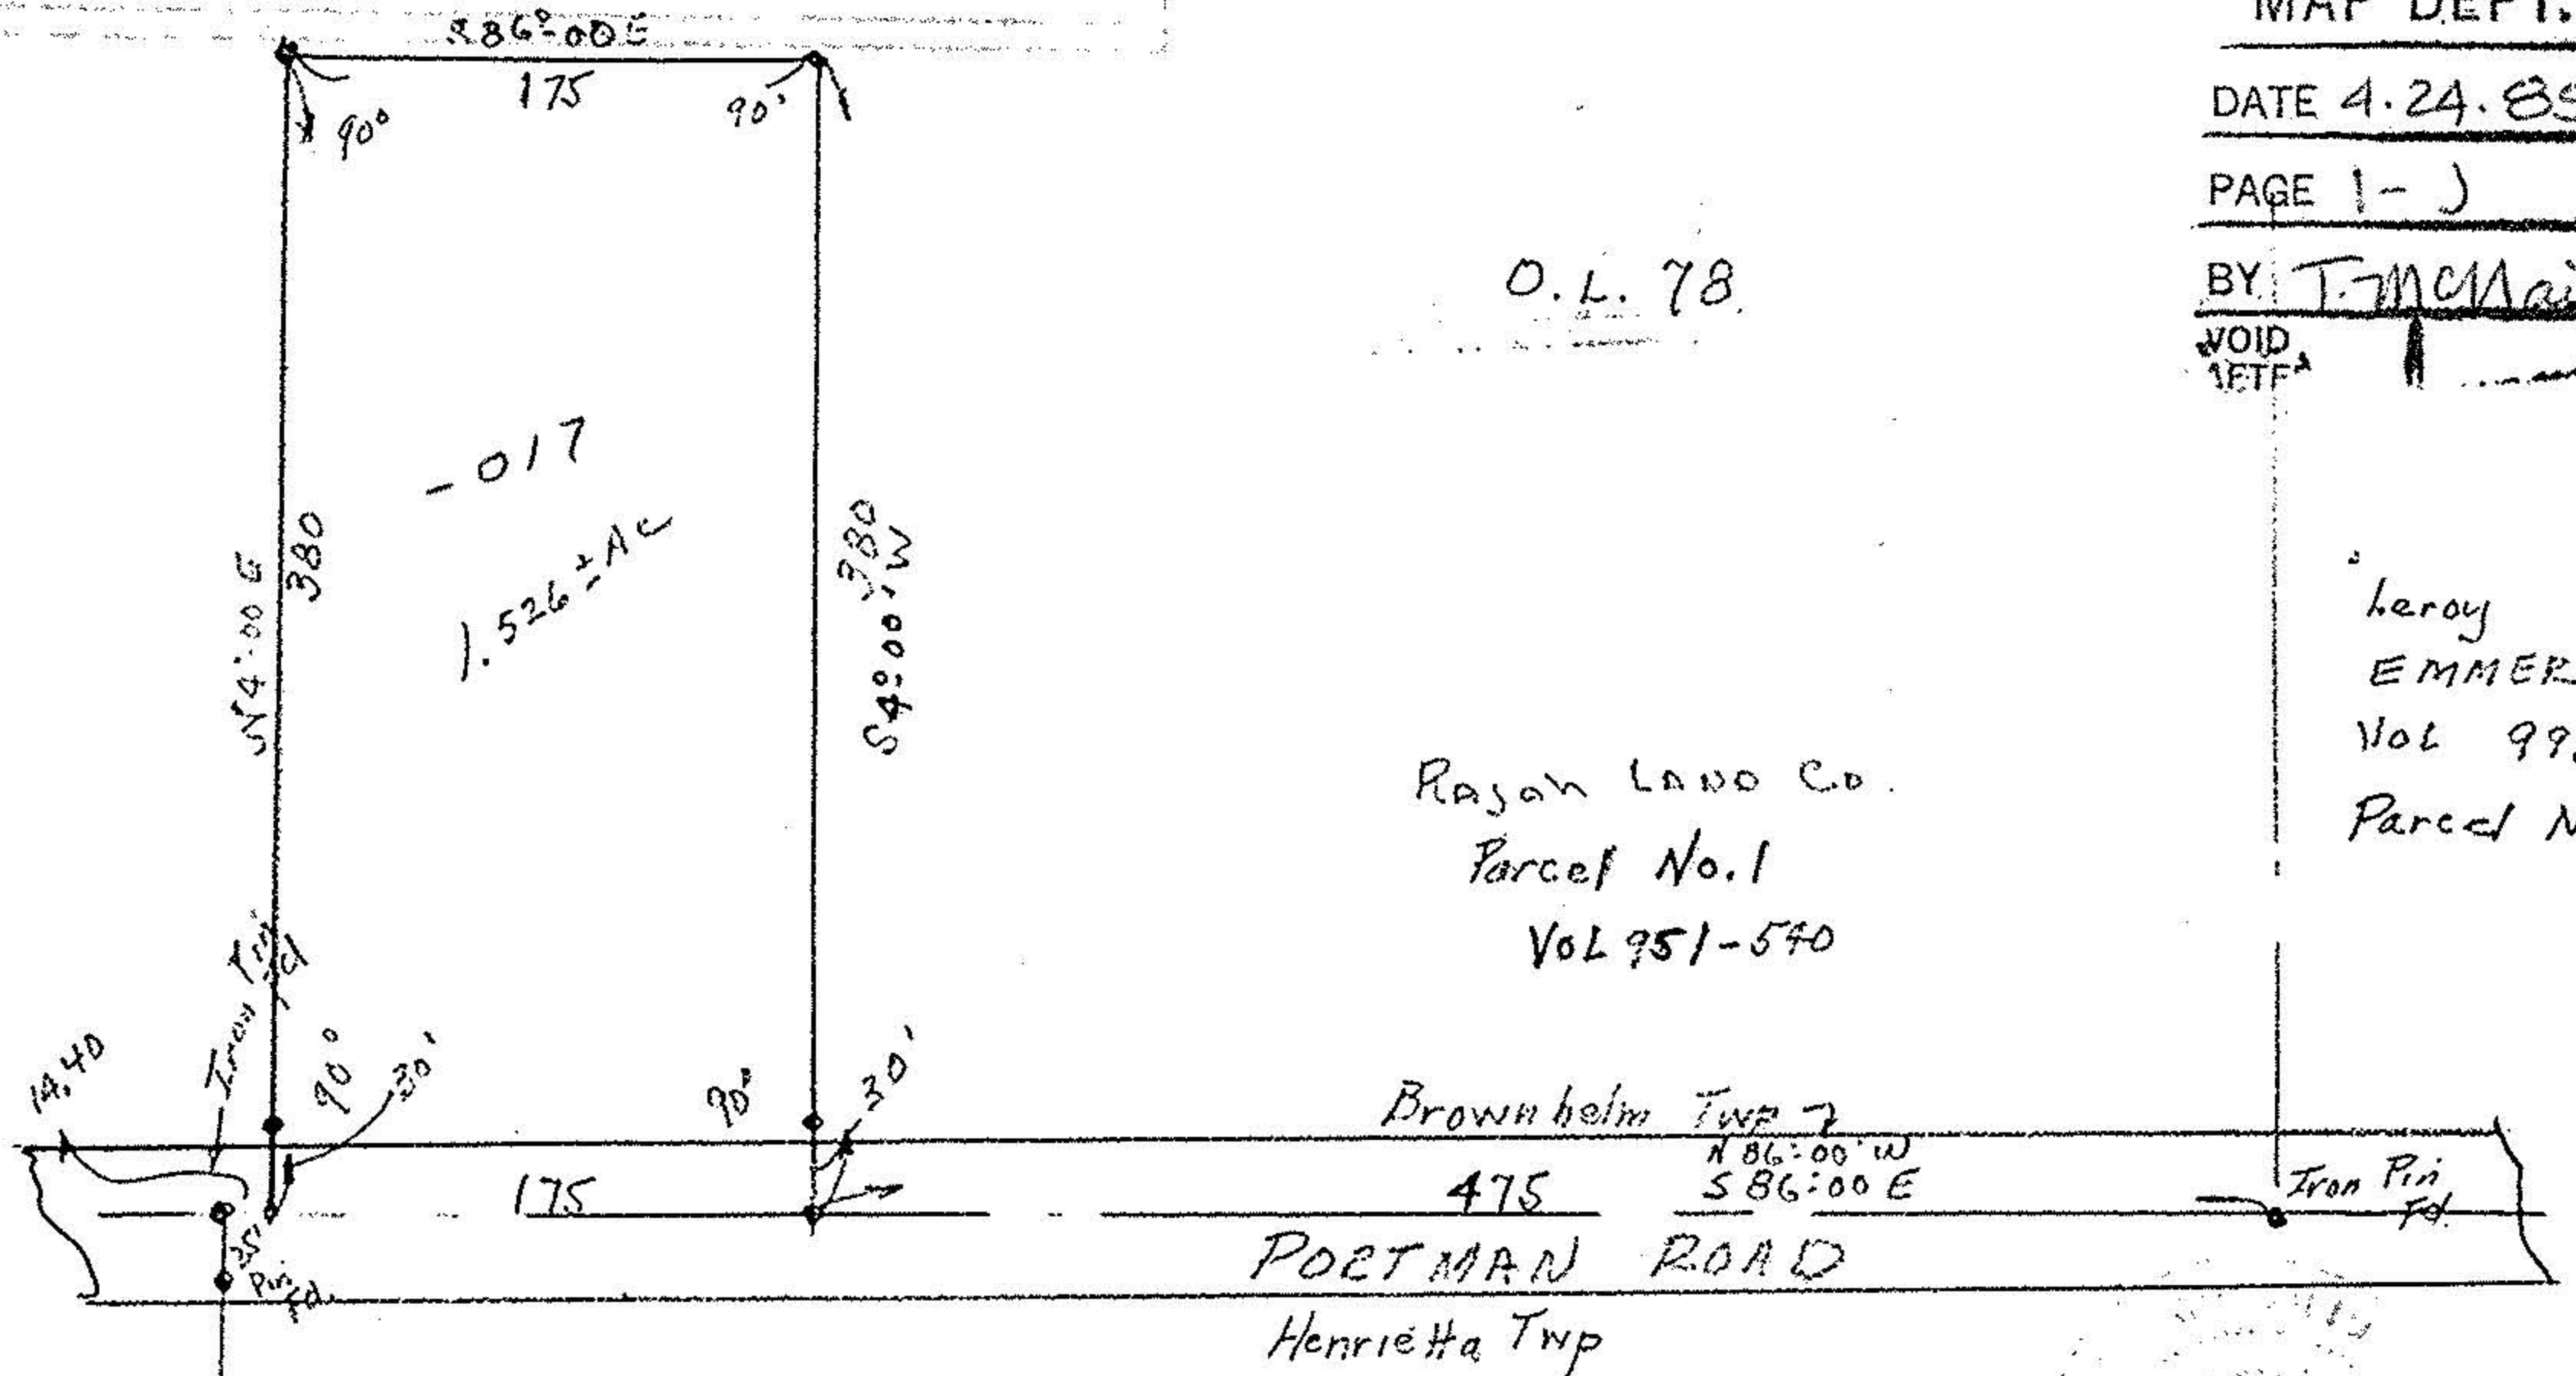

O.L. 78

Rajan Land Co.
Parcel No. 1
Vol 951-540

Leroy
EMMERICH
Vol 995-472
Parcel No 3

Leroy
Emmerich
Vol 995-471

