


1-5

#16712

01-00-077-000-053

Map of Part of O.L. 77 Brownhelm Twp. Lorain Co. Ohio
Scale 1" 400' June 5, 1985
By Arnold F. Koeppe Reg. Surveyor No. 4306

Information Taken
From Deeds -
CORRECTIONS MADE
OK BY Arnold Koeppe
5-1-86

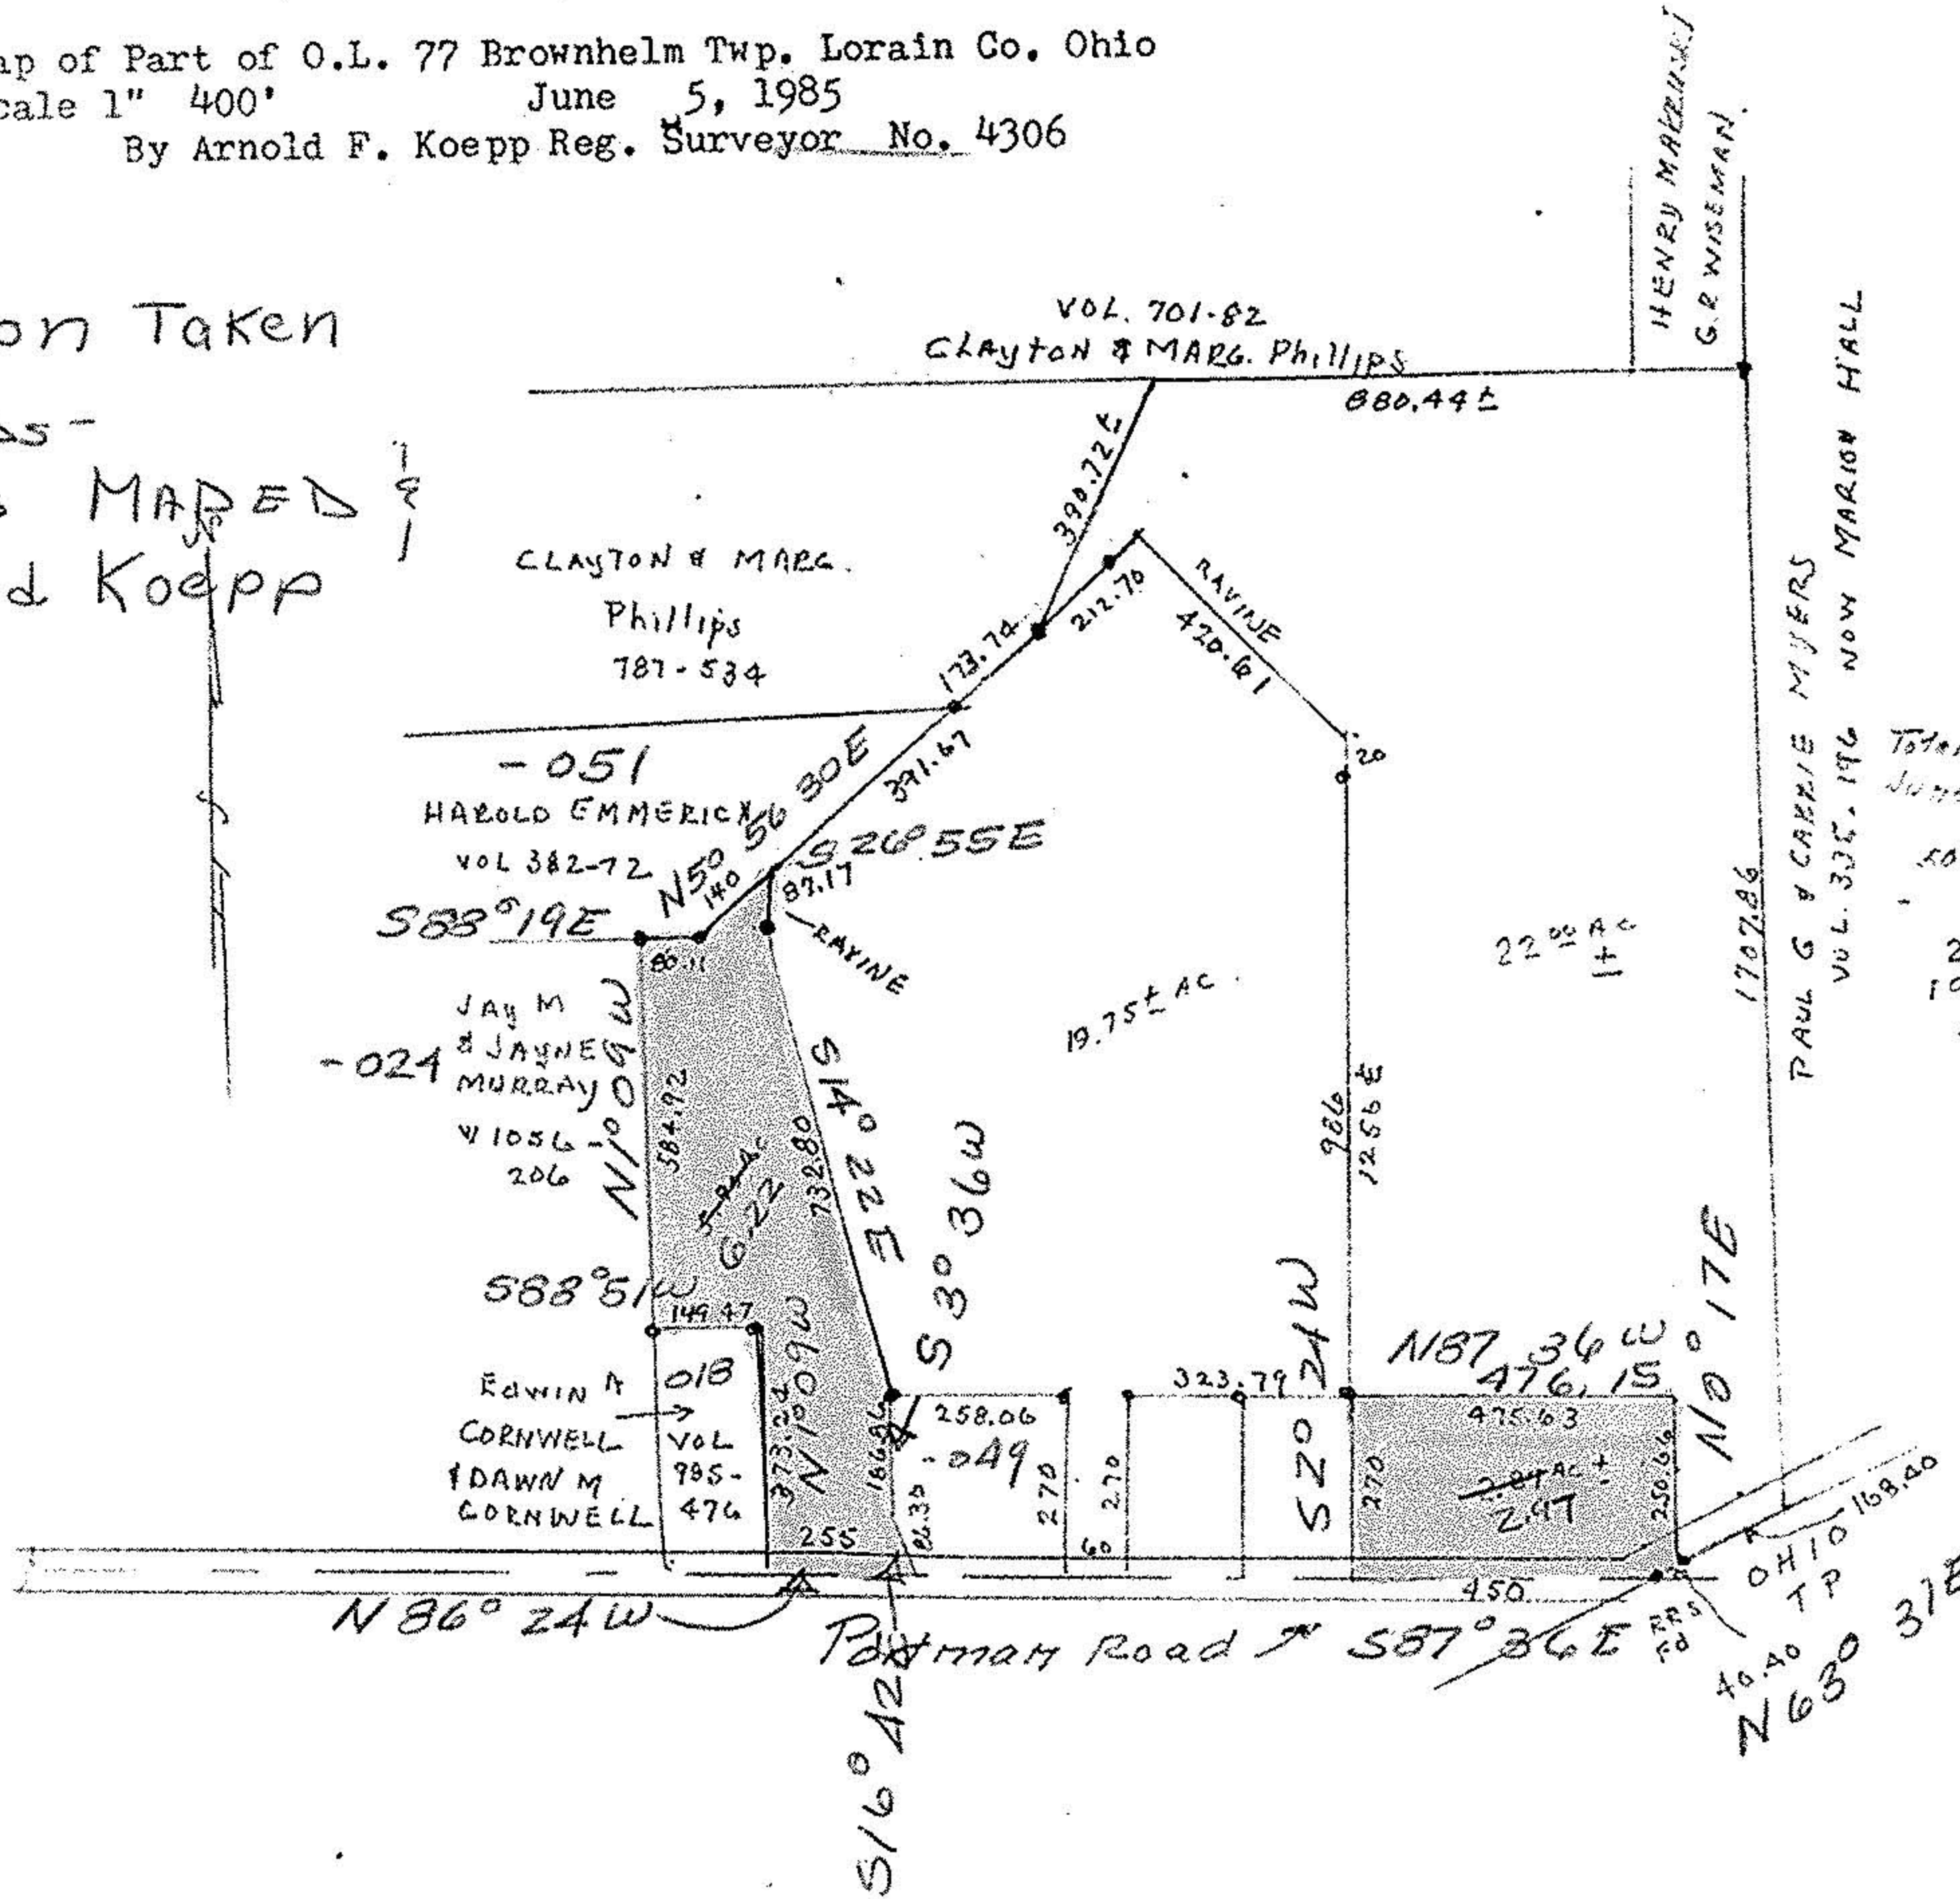

Total Acreage
June 1985

20.52
2.87
19.75
5.90

#16712

APPROVED LORAIN CO. MAP DEPT.	
DATE 5-1-86	
PAGE 1-5	
BY Carolyn Francis	
VOID AFTER	16712