

22.67
5.07
17.60


-044
~~-041~~
22.67 A.
17.60 A.

Pt. -016
Pt. 28.81 A.

15903

APPROVED LORAIN CO. MAP DEPT.	
DATE	11-21-84
PAGE	1-00-032 A
BY	<i>Callert</i>
VOID AFTER	15903

-043
5.07 A.

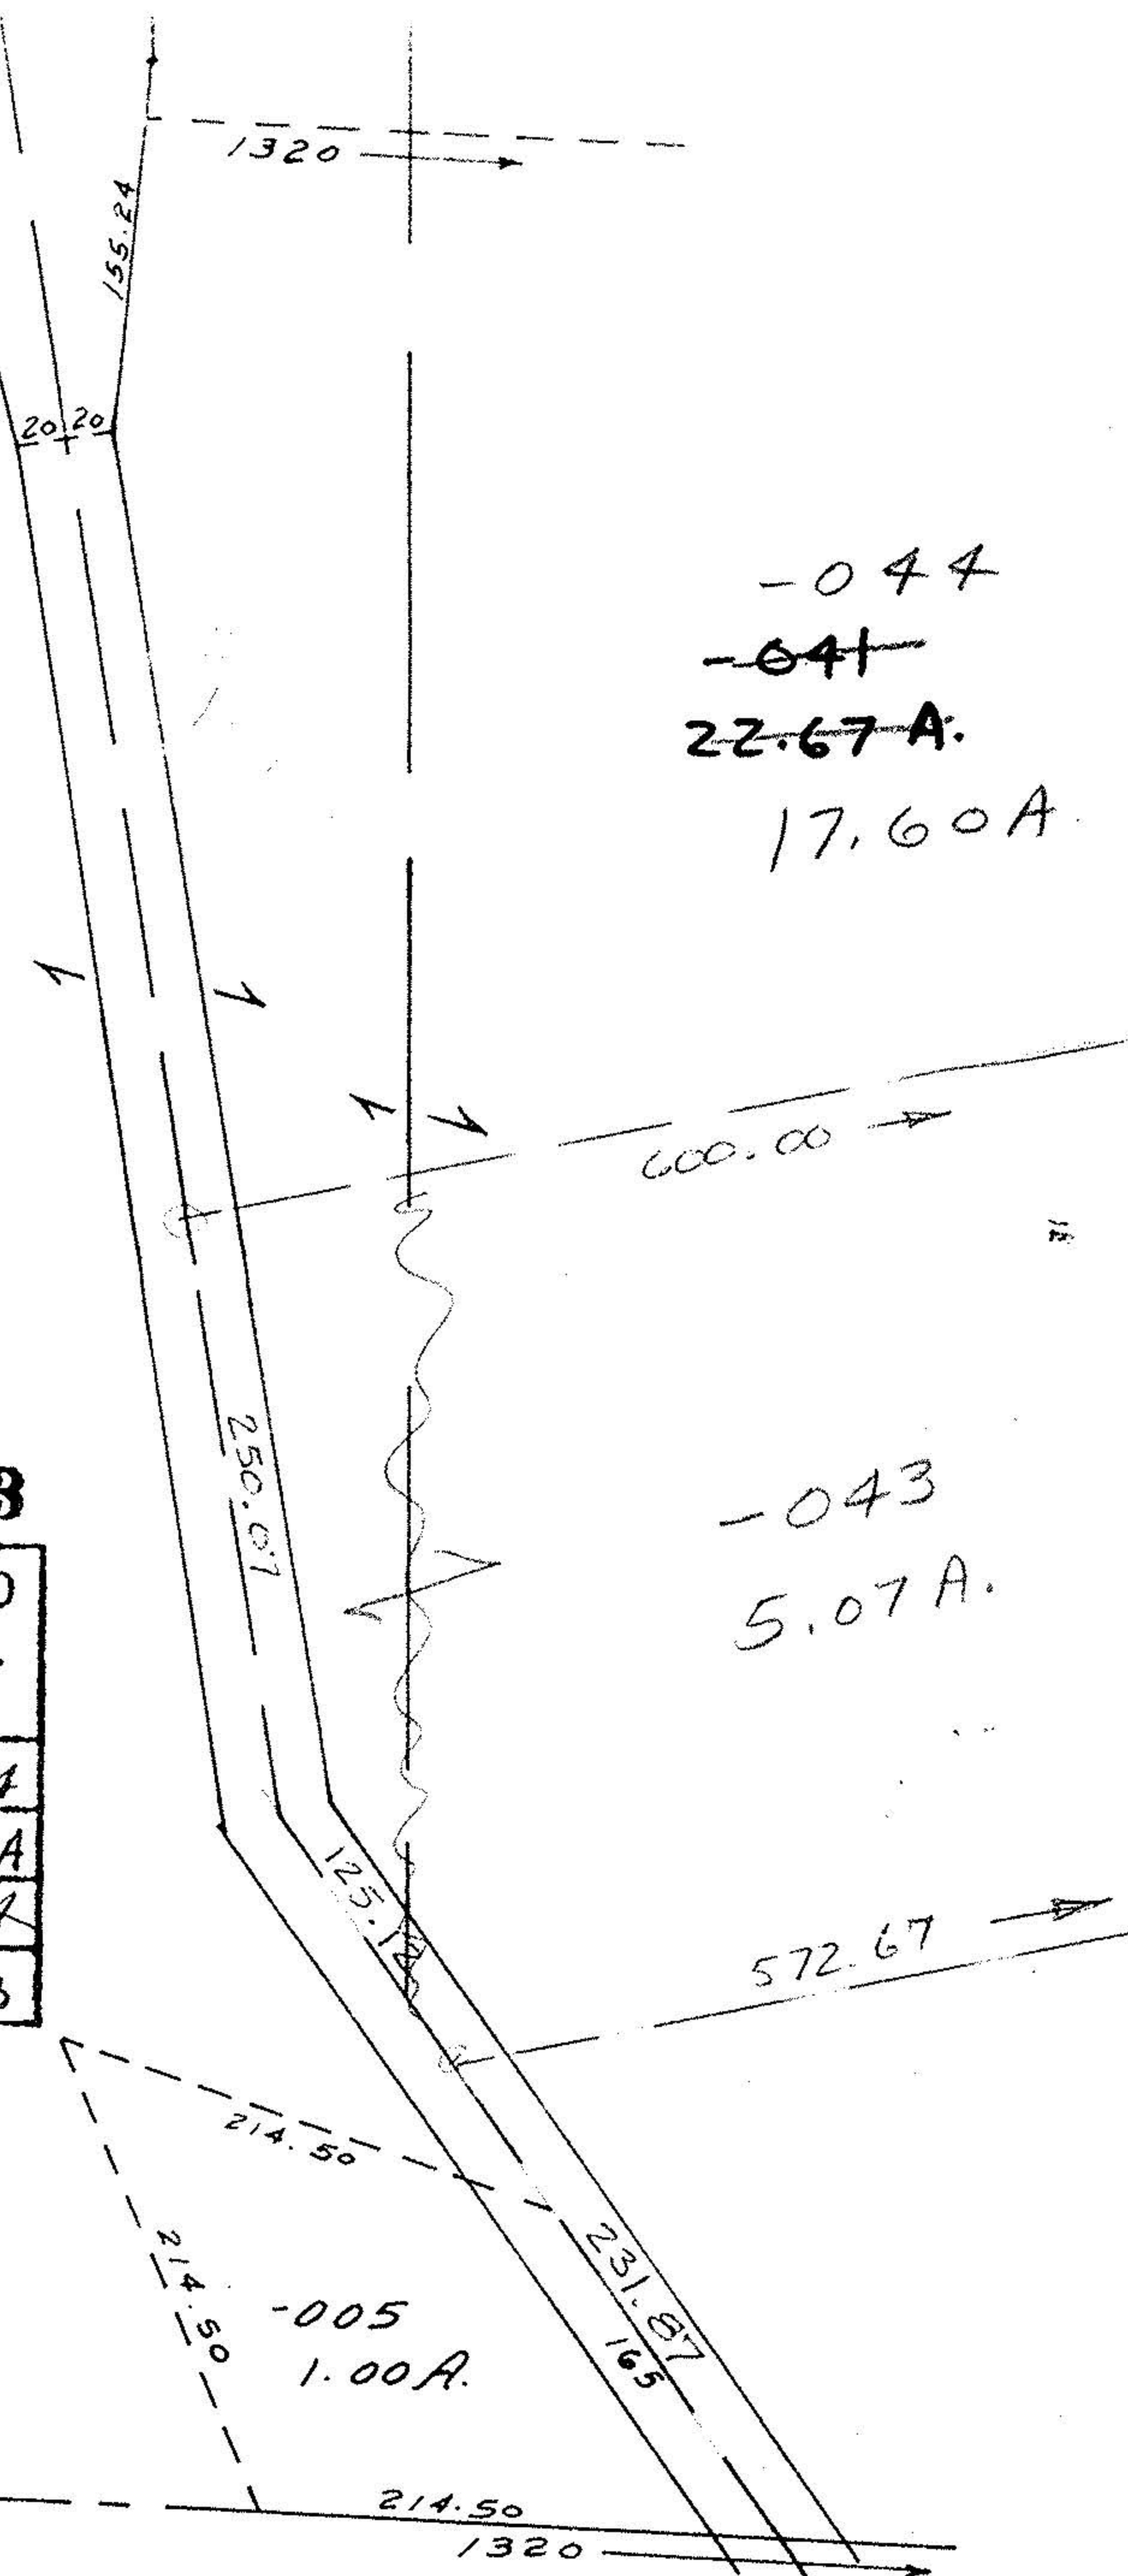

-005
1.00 A.

214.50
1320

231.87
165