
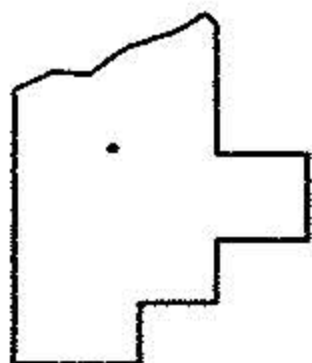
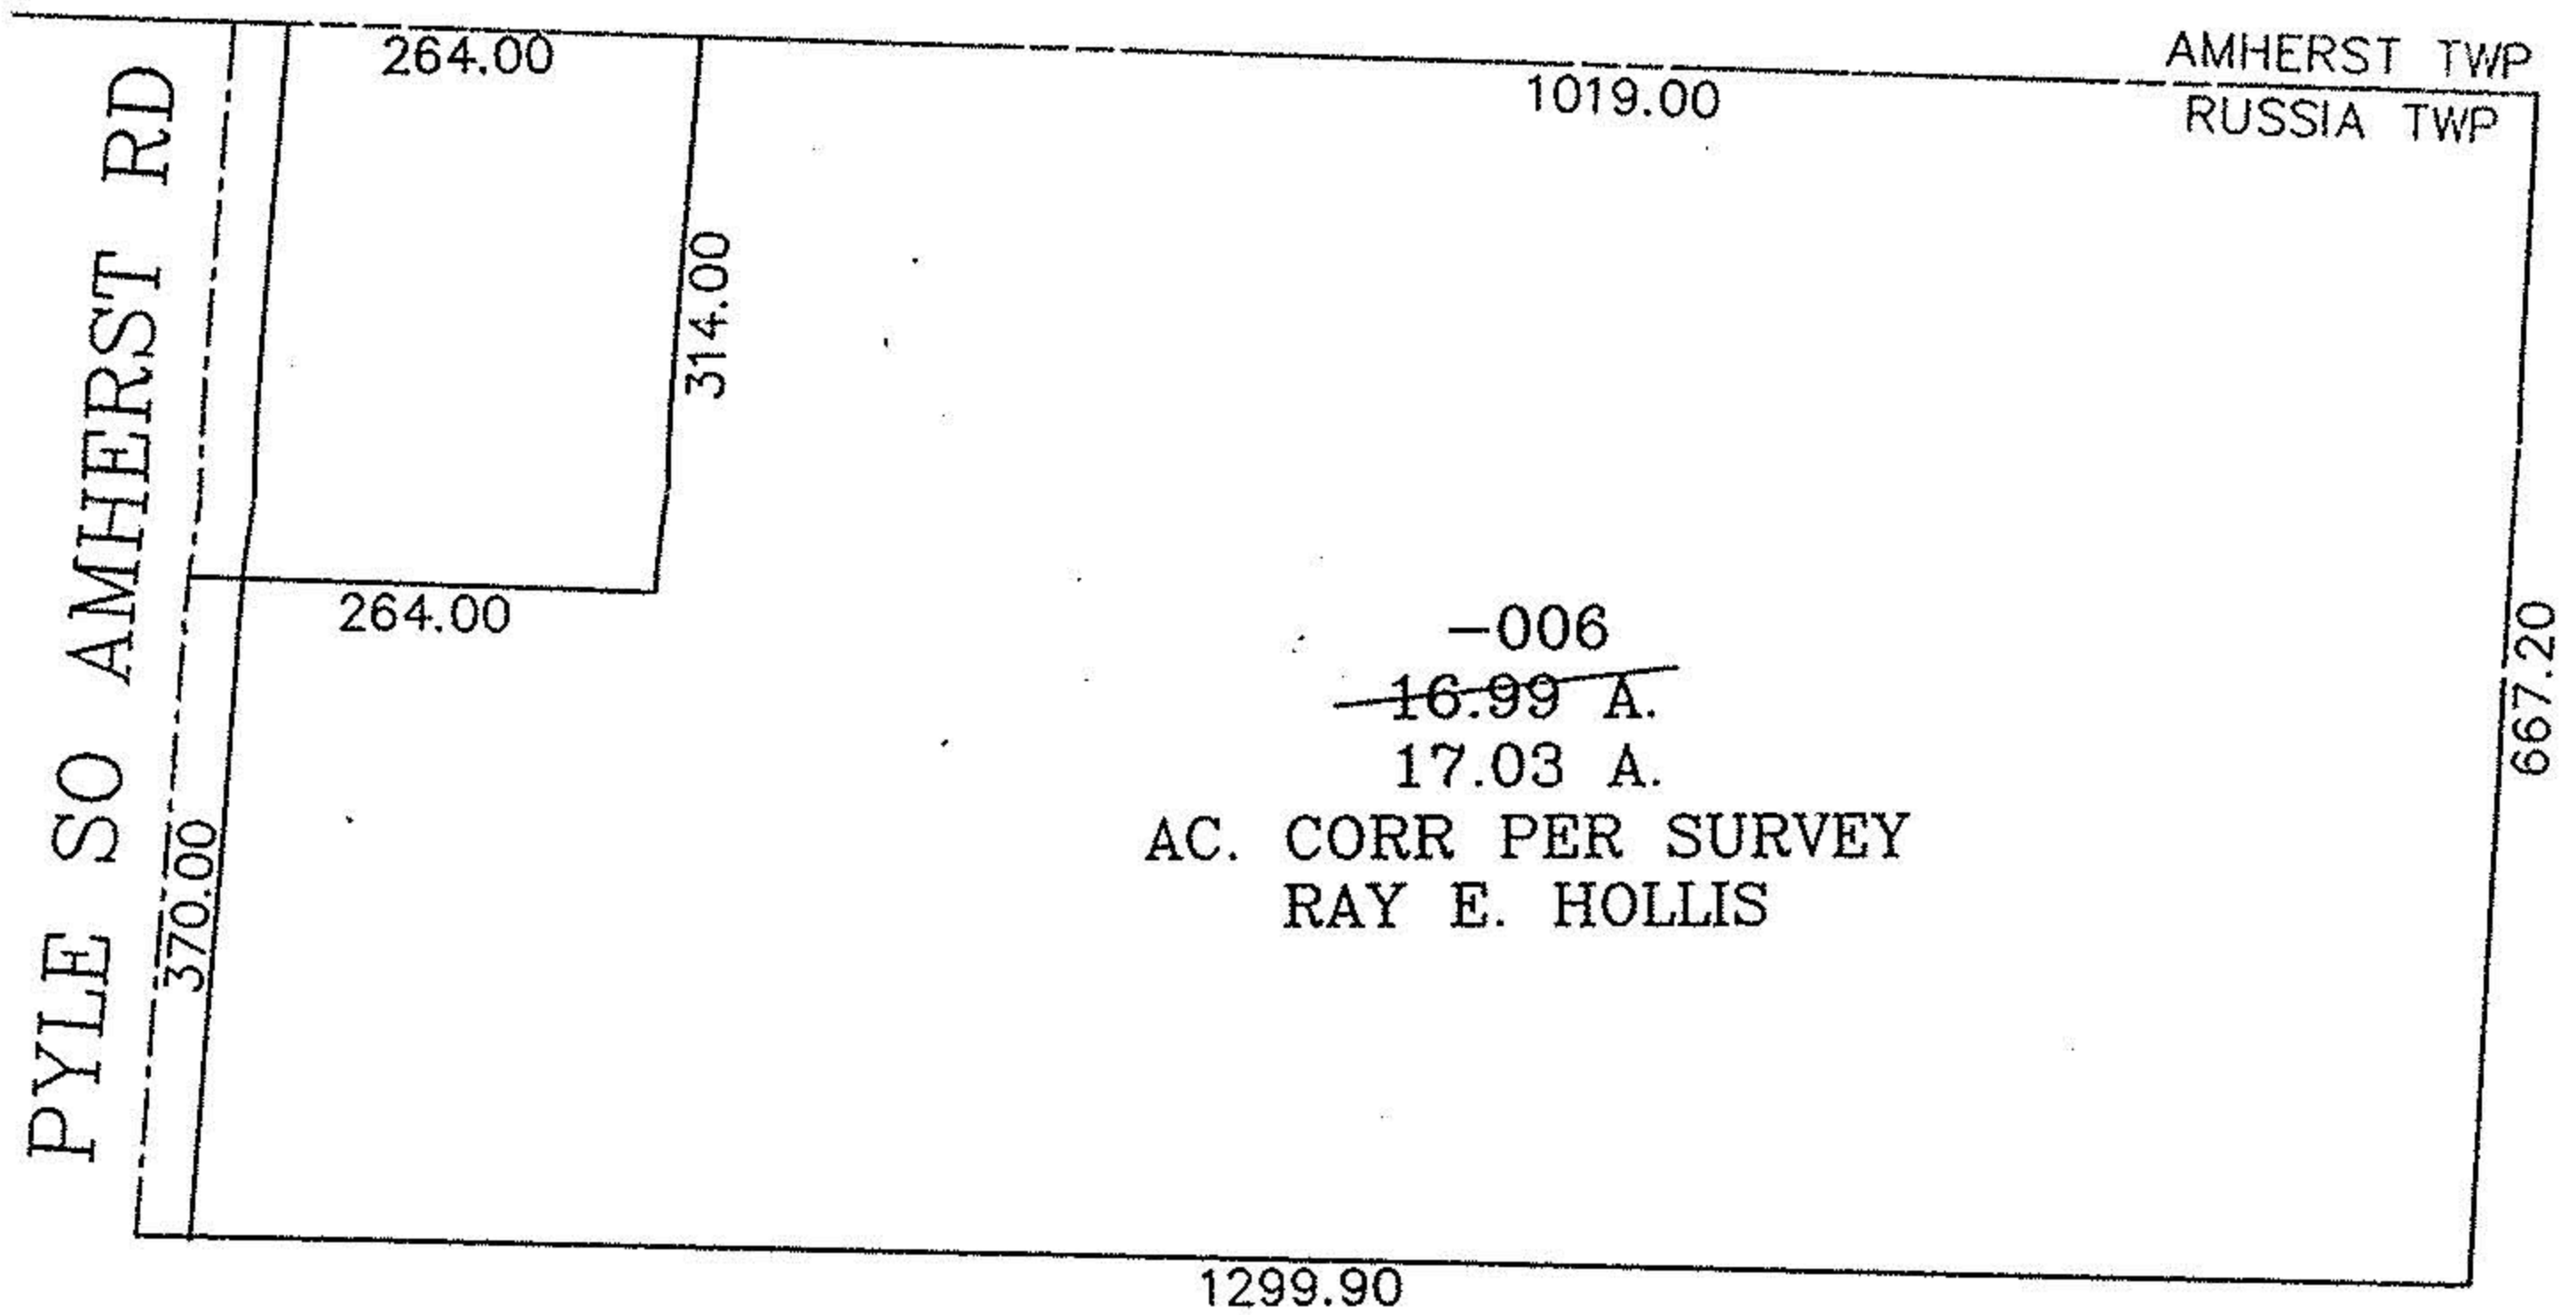


PARENT PARCEL: 09-00-003-105-006

CHILD PARCEL: SAME

STARTING POINT: INT C.L. PYLE SOUTH AMHERST RD AND NORTH LINE OF RUSSIA TWP

NO. 00829-X

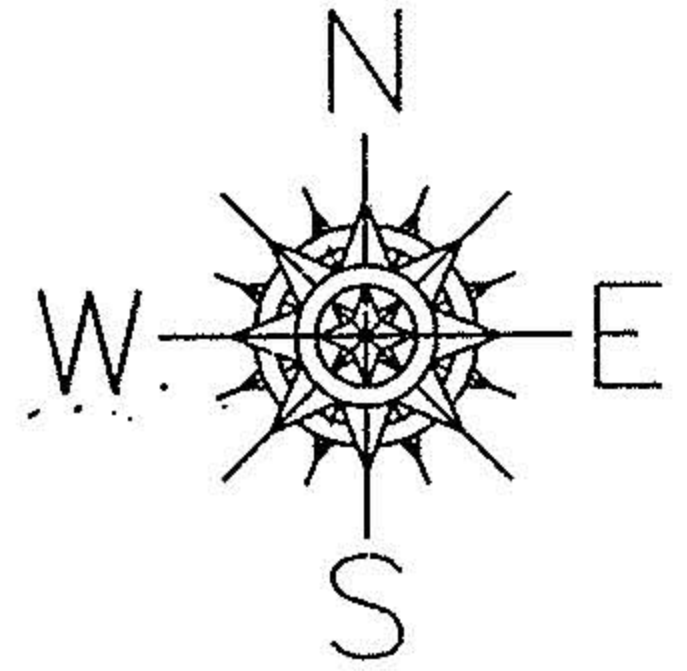

SPLITS/DEEDS PROCESSED

LORAIN COUNTY TAX MAP DEPARTMENT

226 MIDDLE AVE. ELYRIA, OHIO

SURVEYED BY: RAY E. HOLLIS

CLOSURE: 0:00

MAP PAGE(S): 09-00-003-B. 5-F

APPROVED BY: DRH DATE: 3/19/2003

SCALE: 1" = 200' PRIOR INSTRUMENT: O.R. 1428/428