


21-E

21-03-000-000-037  
21-T-3-21E

TRACT 4

TRACT 3

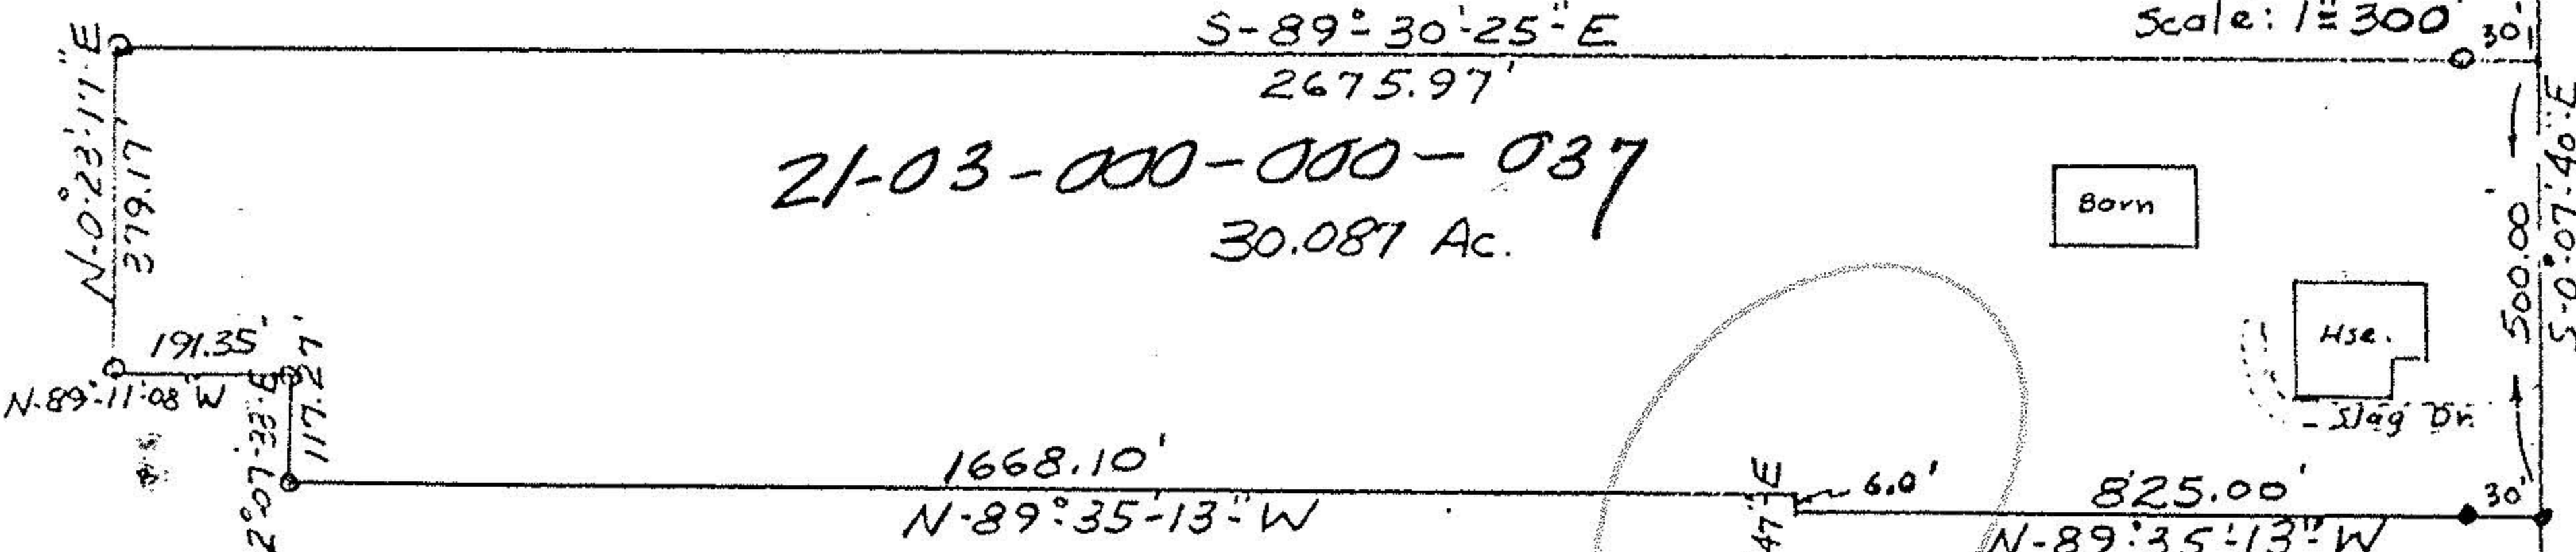

21-03-000-000-037  
30.087 Ac.

Born

Hse.

CLARK RD.

N-0°-23'-11" E  
379.17'

N-89°-11'-08" W  
191.35'  
N-2°-07'-33" E  
117.27'

1668.10'  
N-89°-35'-13" W

W-4°-24'-47" E  
6.0'

825.00'  
N-89°-35'-13" W

484.95'

500.00'

Scale: 1" = 300'

LEGEND:  
○ IRON PIPE SET  
● IRON PIN FND.

#12355

APPROVED  
LORAIN CO.  
MAP DEPT.

DATE 1-3-79

PAGE 21-E

BY T. M. Nail

VOID AFTER



WILLIAM L. FOX, SURVEYOR  
REGISTRATION NO. 5878  
NOV 1 1978

PART OF TRACT 3, TWP. OF  
HUNTINGTON, LORAIN, CO.  
STATE OF OHIO  
W. L. Fox, REG. SURVEYOR  
1034 BROAD ST. ASH. OHIO  
(419) 289-2369 78-138

(Worcester)