

-004
JOHN L. & BETTY A. YUHOE
D.V. 1106 P. 846

-032
23.7644 Ac.
GLEN & JOHNEE KNAPP
D.V. 1102 P. 857

-032

① 5.9799 Ac. -078
② 5.9739 Ac. -079
③ 3.9291 Ac. -080

-007
DRAPER NYLON
O.R.V. 1062 P. 414

-009
GEORGE & VICTORIA
WILLIAMS
O.V. 1045 P. 56

W.L.G. LINE of HUNTINGTON TWP

BAKER RD.

N. 89° 58' 24" E. I.P. Set I.P. Set I.P. Set

959.07' m. 978.54' R. 250.03 250.03 149.14

I.P. Fd. - Used

I.P. Fd. - Used

N. 1° 46' 00" E. 1047.18' m. 1047.15' R.

1046.55' R. 5.1° 44' 36" E. 1042.81' E

N. 1° 44' 36" W. 1041.76' E

5.1° 44' 36" E. 1040.70' E

N. 3° 26' 34" W. 1041.32' E 701.32'

DENNIS H. & CAROLYN SUE JACKSON O.R.V. IIII P. 122

N. 75° 01' 47" W. 214.22'

S. 33° 17' 00" W. 340.00' R. & Used

4.7225 Ac.

I.P. Set 35.95' E

1022.09' Calc. 1044.0' R.

N. 89° 43' 53" E.

1702.11' m.

250.00 250.00 180.02

N. 89° 51' 00" E. 632.18' m.

Re-Bar Fd. I.P. Set
N. 88° 24' 20" E. 729.77' m.

I.P. Fd. - Used 23.16' E

I.P. Set


I.P. Set

I.P. Set

I.P. Set

R.R. Spk Set

STEWART RD. 60

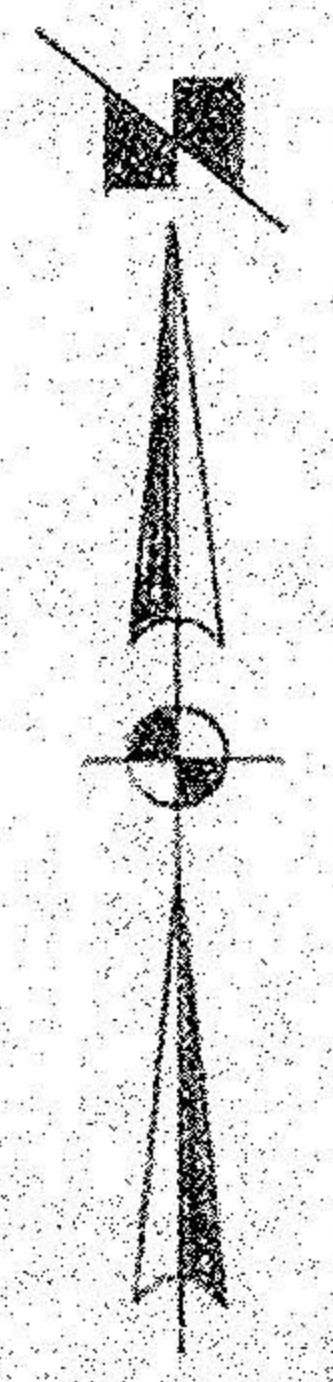

#22390
APPROVED
LORAIN CO.
MAP DEPT
DATE 12/23/97
PAGE 21-E
BY K. Colbert

SURVEY FOR
DENNIS H. & CAROLYN SUE JACKSON
AND
ANTHONY R. WILLIAMS

PART of TRACT No 3 TOWNSHIP of HUNTINGTON
COUNTY of LORAIN STATE of OHIO
AUGUST 1997 SCALE 1"=100'
LAUNOON • SIMON • CAHL & ASSOC.
PROFESSIONAL LAND SURVEYORS
JOB No: 96-2908 P. 240 P. 71-74

