
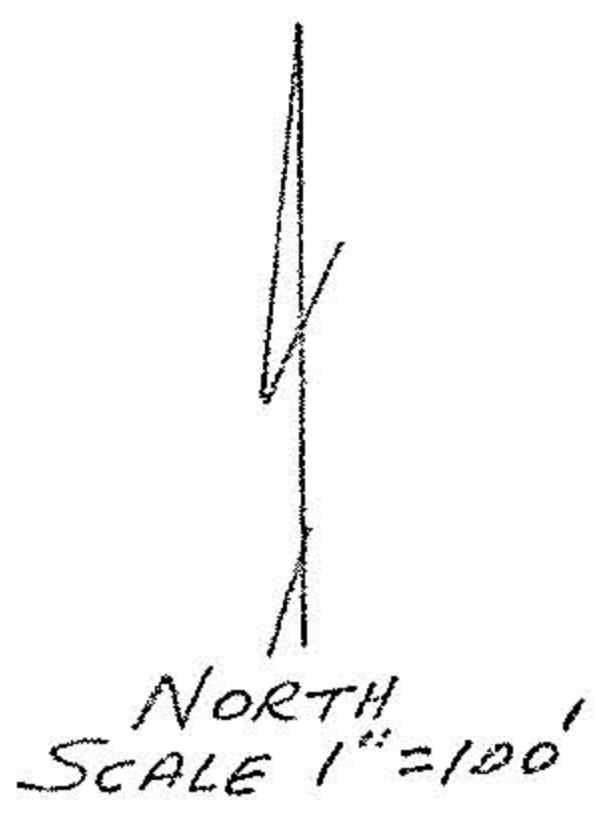


21-05-004-000

#19077

21-B

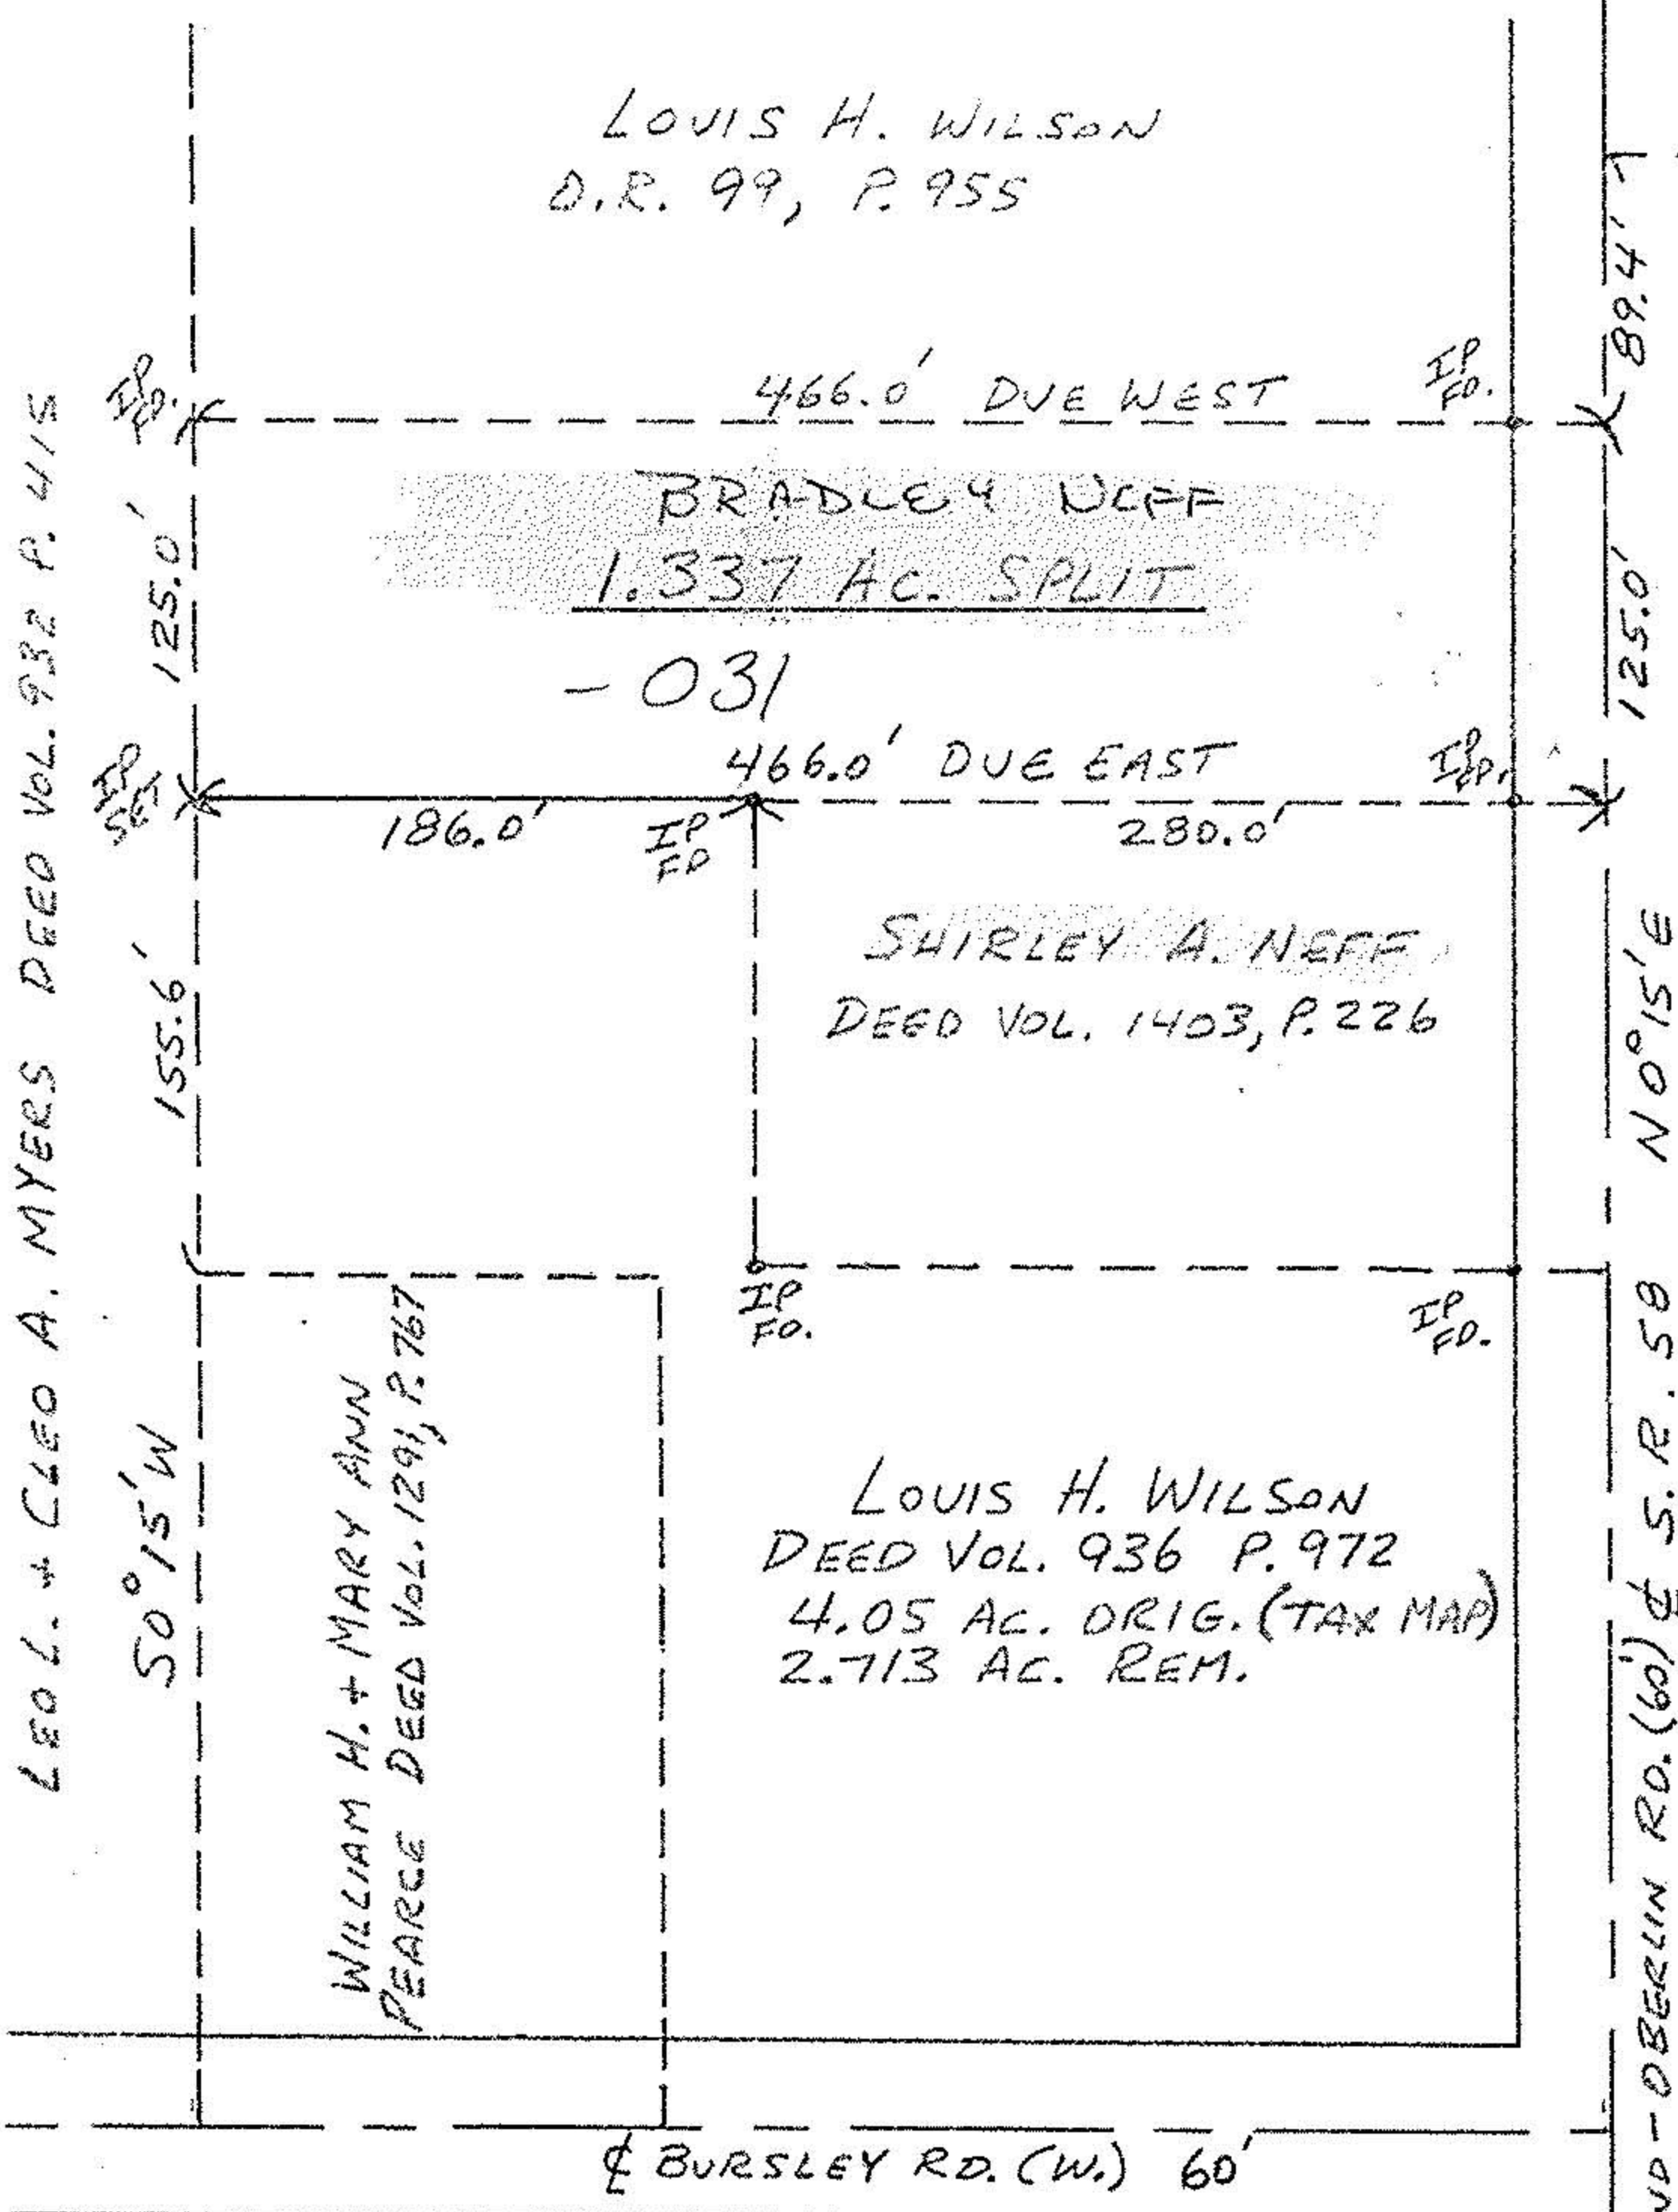

#19077

APPROVED
LORAIN CO.
MAP DEPT.

DATE 8-6-90

PAGE 21-B

BY CAROLYN FRANCIS

VOID AFTER #19077

MAP OF 1.337 AC. SPLIT FOR LOUIS WILSON
D.L. 4-TRACT 5- HUNTINGTON TWP,
JAN. 1989 SCALE 1"=100'
JOHN R. HAMILTON REG. SURV. #6861

036