


21-05-001-A

21-05-001-000-001  
-008

MAP OF SURVEY  
 O. L. I., TR. 5 HUNTINGTON TWP.  
 LORAIN COUNTY, OHIO  
 SCALE 1" = 100' AUG. 1975  
 WILLIAM L. FOX, REG. SURVEYOR  
 NO. 5878

N  
 JOB NO. 75-131

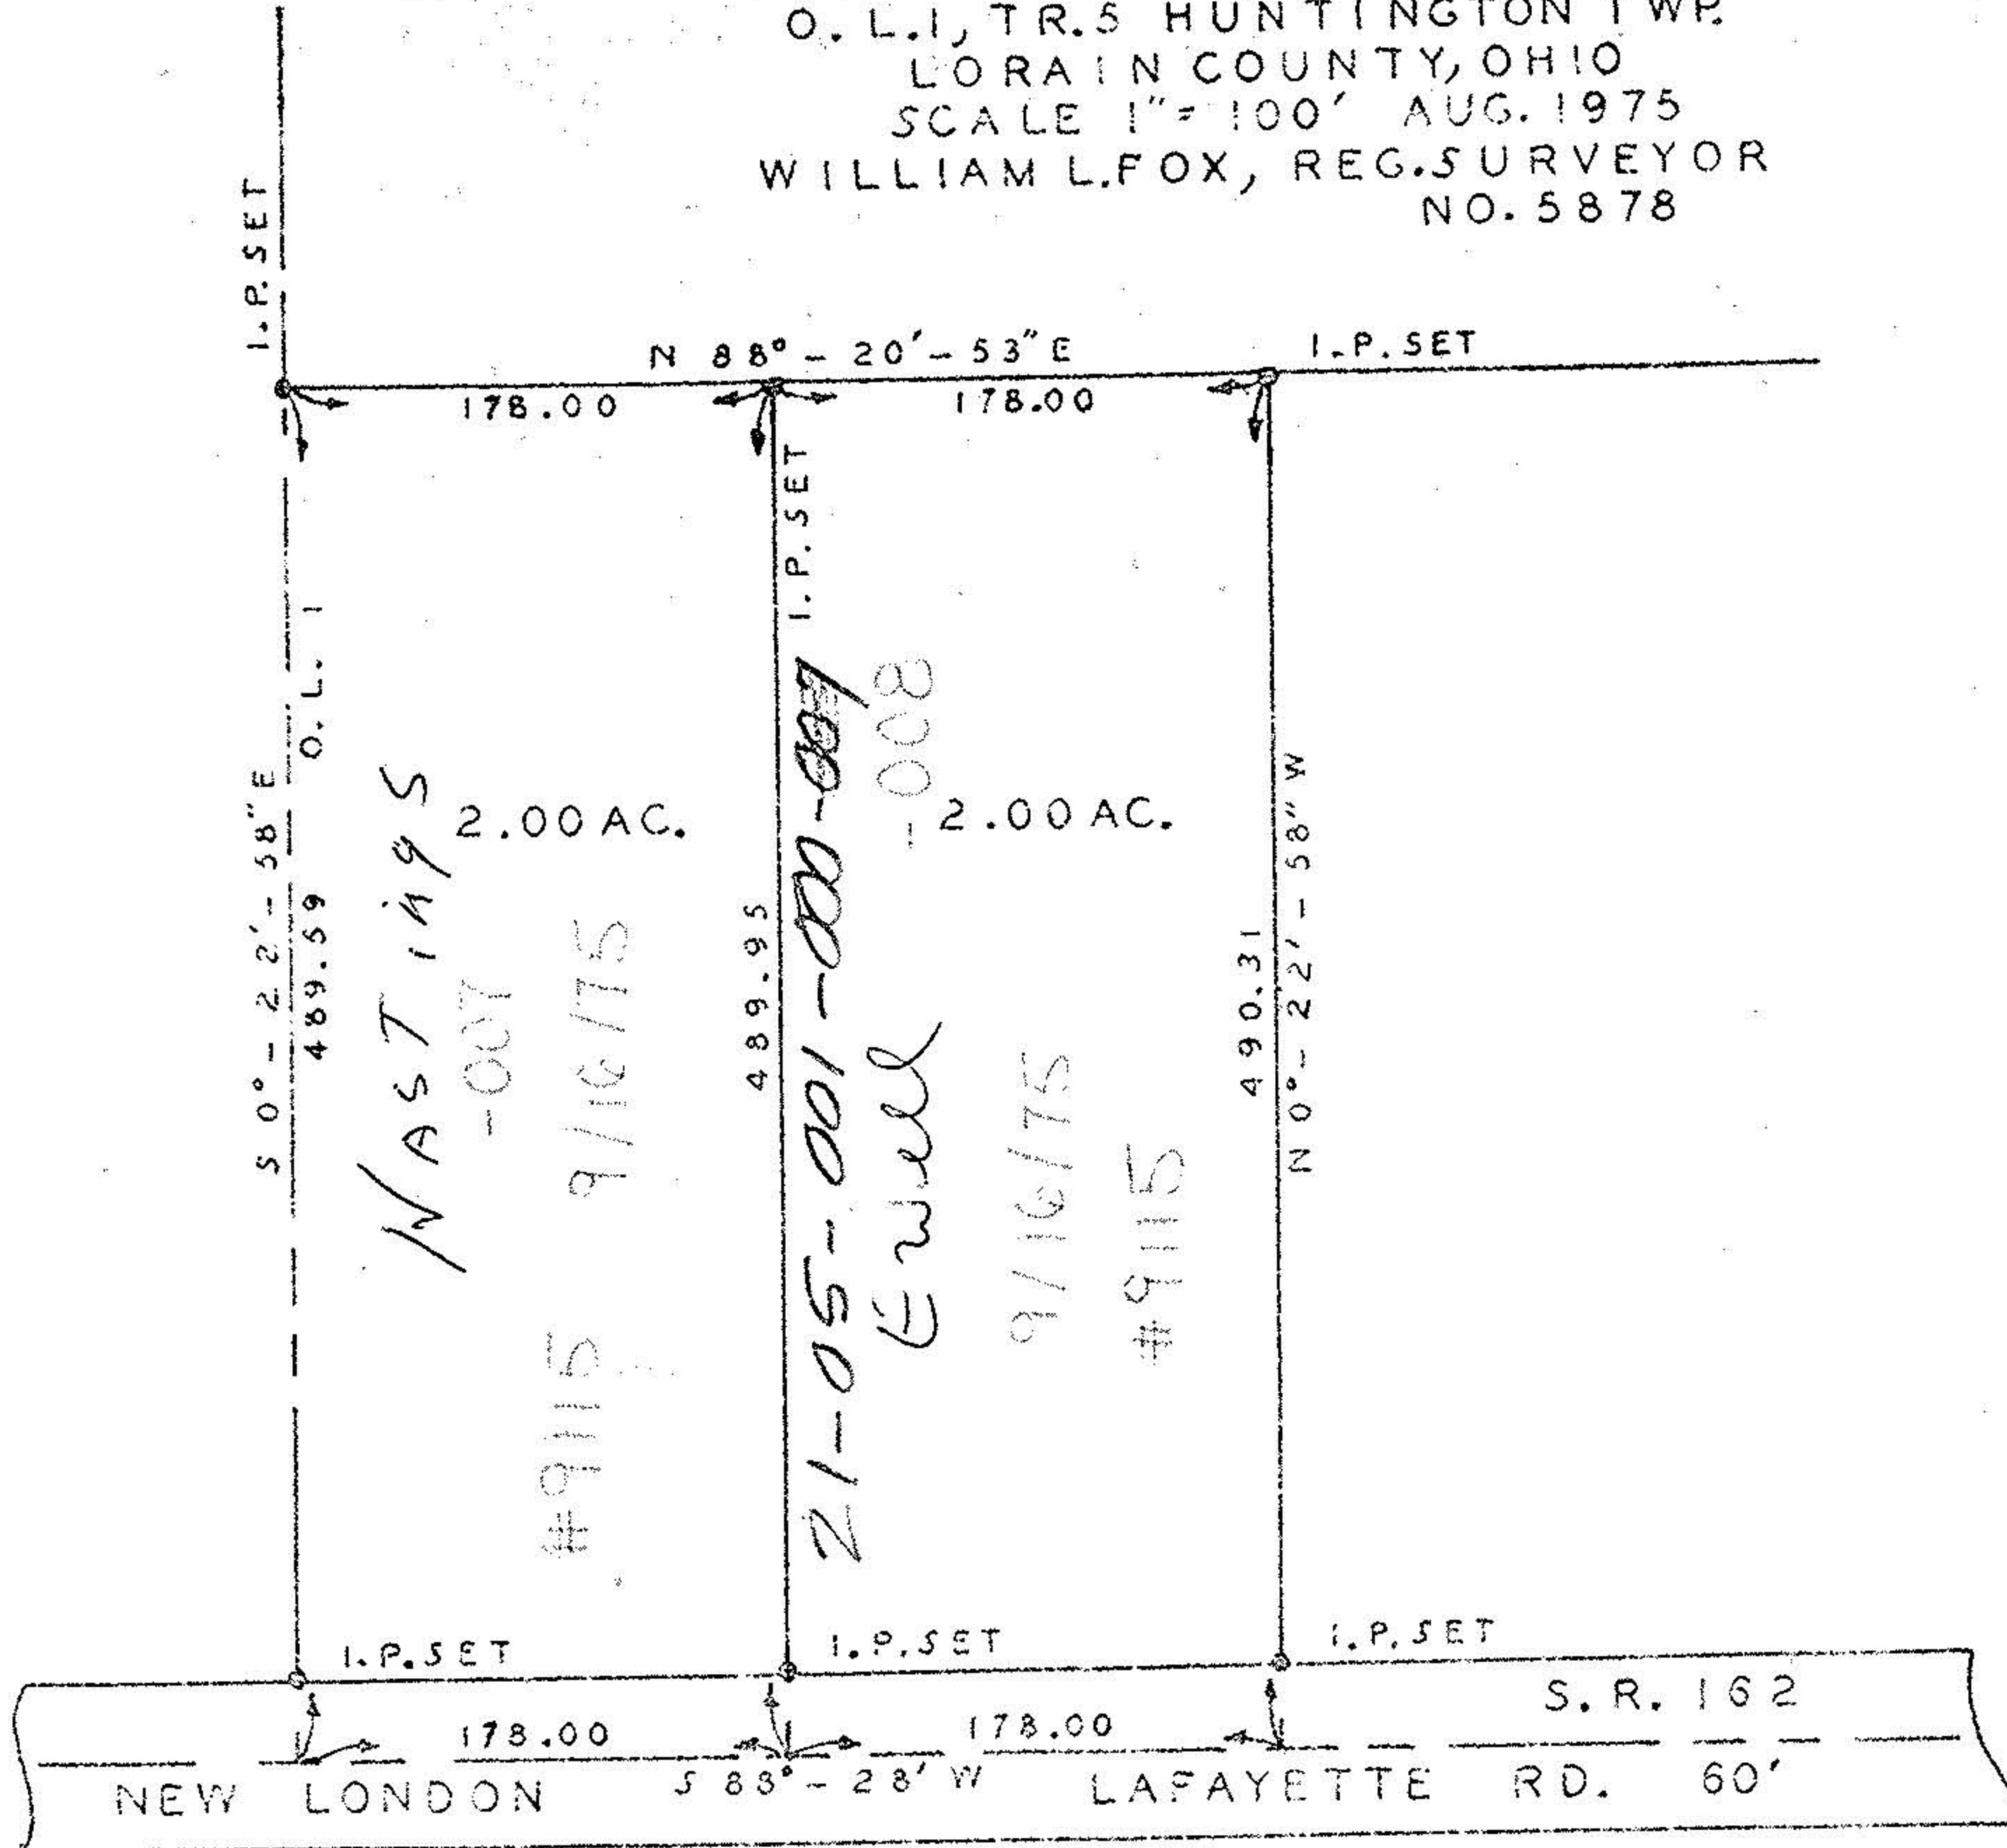

033a