


21-05-001-B LORAIN COUNTY, OHIO  
 SCALE 1" = 100' SEPT. 1975  
 WILLIAM L. FOX, REG. SURVEYOR  
 NO. 5878

21-05-001-00-016

esc.  
 9791  
 E-168977

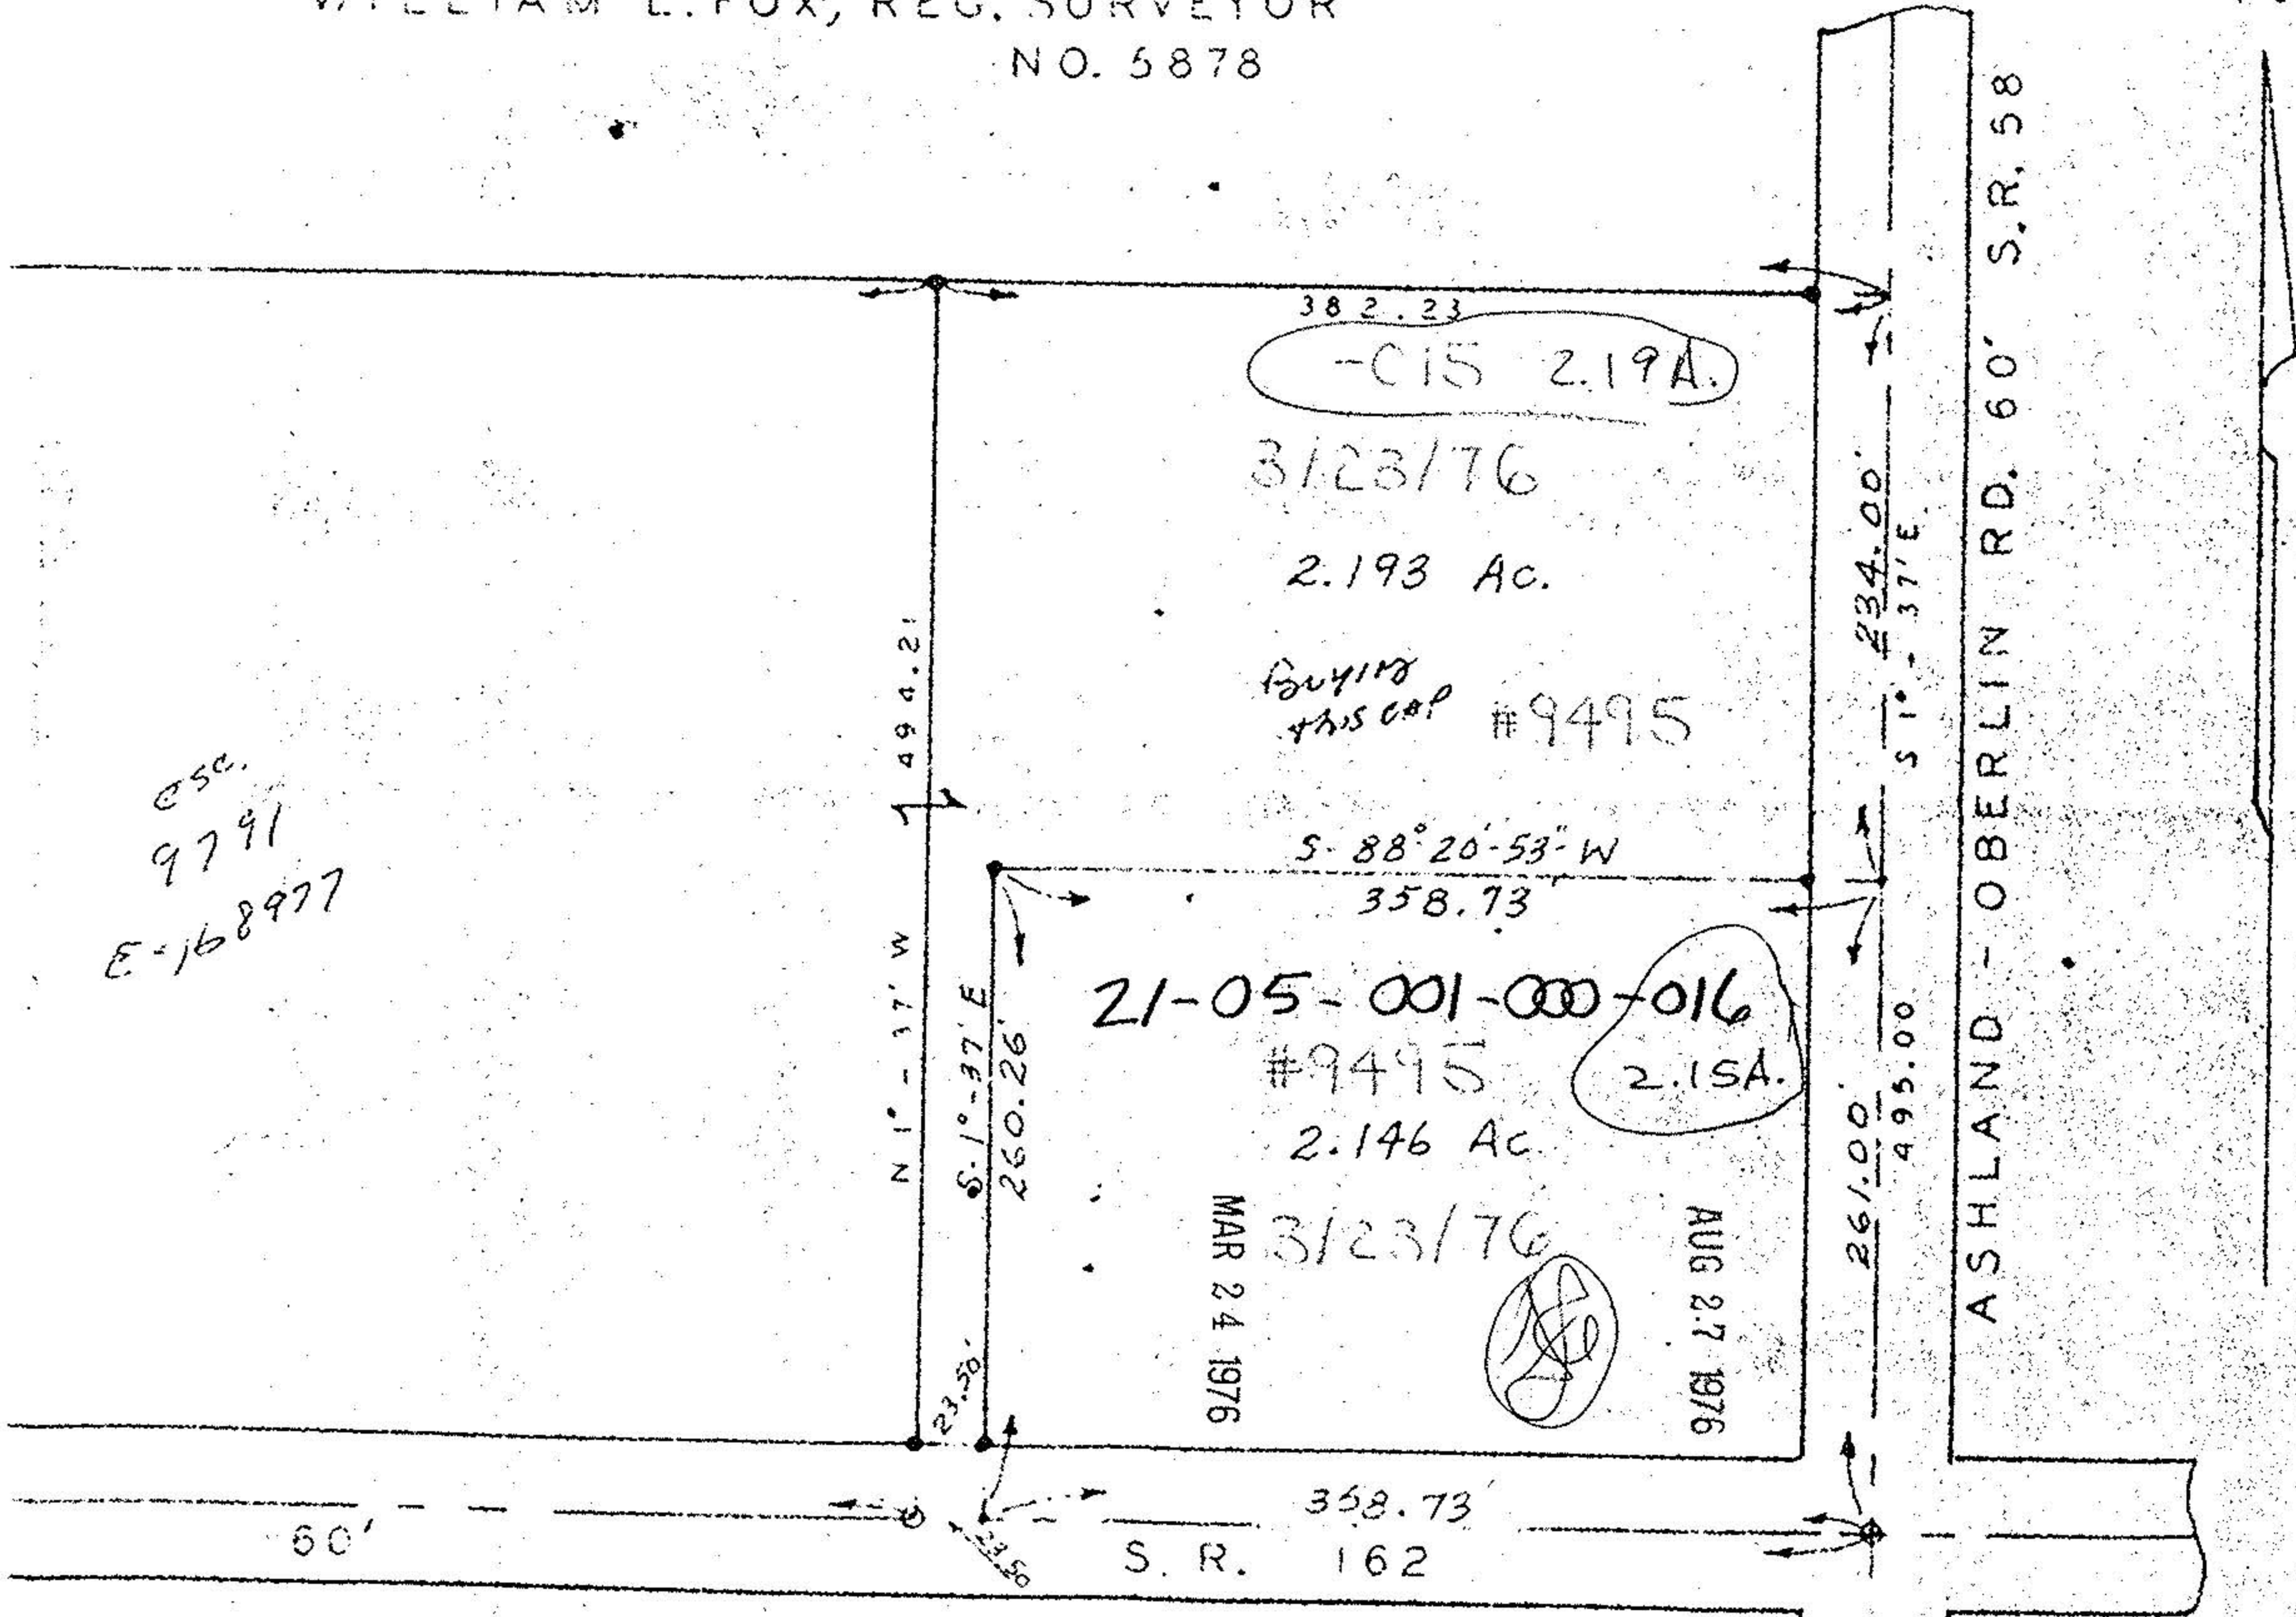

382.23  
 -C15 2.19A.

3/23/76  
 2.193 Ac.

BUYING  
 THIS CAP #9495

21-05-001-000-016  
 #9495  
 2.146 Ac.

MAR 24 1976  
 3/23/76  
 AUG 27 1976

ASHLAND - OBERLIN RD. 60' S.R. 58

358.73  
 S. R. 162

21-05-001-B

85

9495