


Map of Part of Lot 4 Tract 5 Huntington Twp. Lorain Co. Ohio
 Scale 1" = 100' Aug. 7, 1980
 By Arnold F. Koopp Reg. Surveyor No. 4306

17890 Vol 1 De 21-05-004-000-029

21-B

#18079

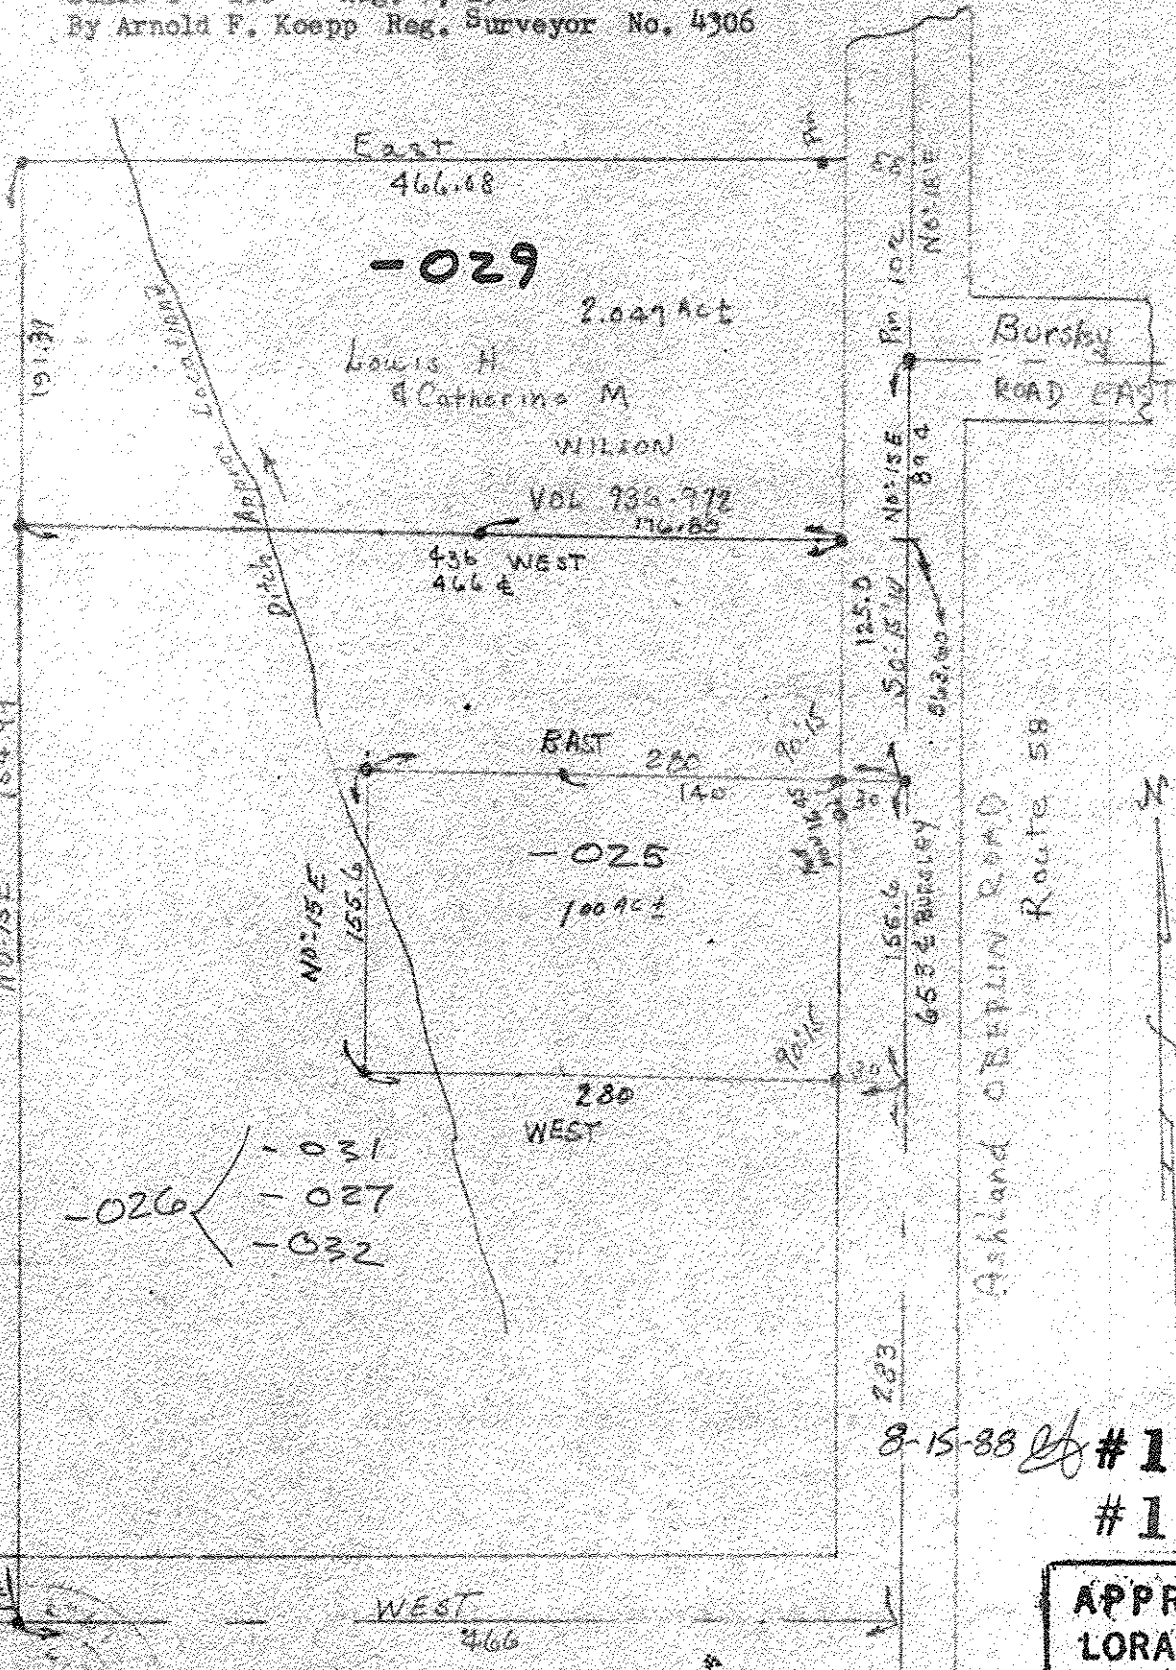

-026
 -031
 -027
 -032

Ashland Culpin Road
 Route 58

8-15-88 #18079
 #17890

APPROVED	
LORAIN CO.	
MAP DEPT.	
DATE 4-22-88	
PAGE 21-B	
BY CAROL-FRANIS	
VOID	17910

Scan# 31228
 parent 028
 21-05-004-00-029

37

21-12