


ASSOCIATES, INC.
100 STATE ST. BLDG. 05
ELYRIA, OHIO 44036
(216) 322-6317

MAP OF SURVEY

IN ORIGINAL LOT II, TRACT N^o 5
HUNTINGTON TOWNSHIP - LORAIN COUNTY
STATE OF OHIO

21-05-011-000
18332
21-13

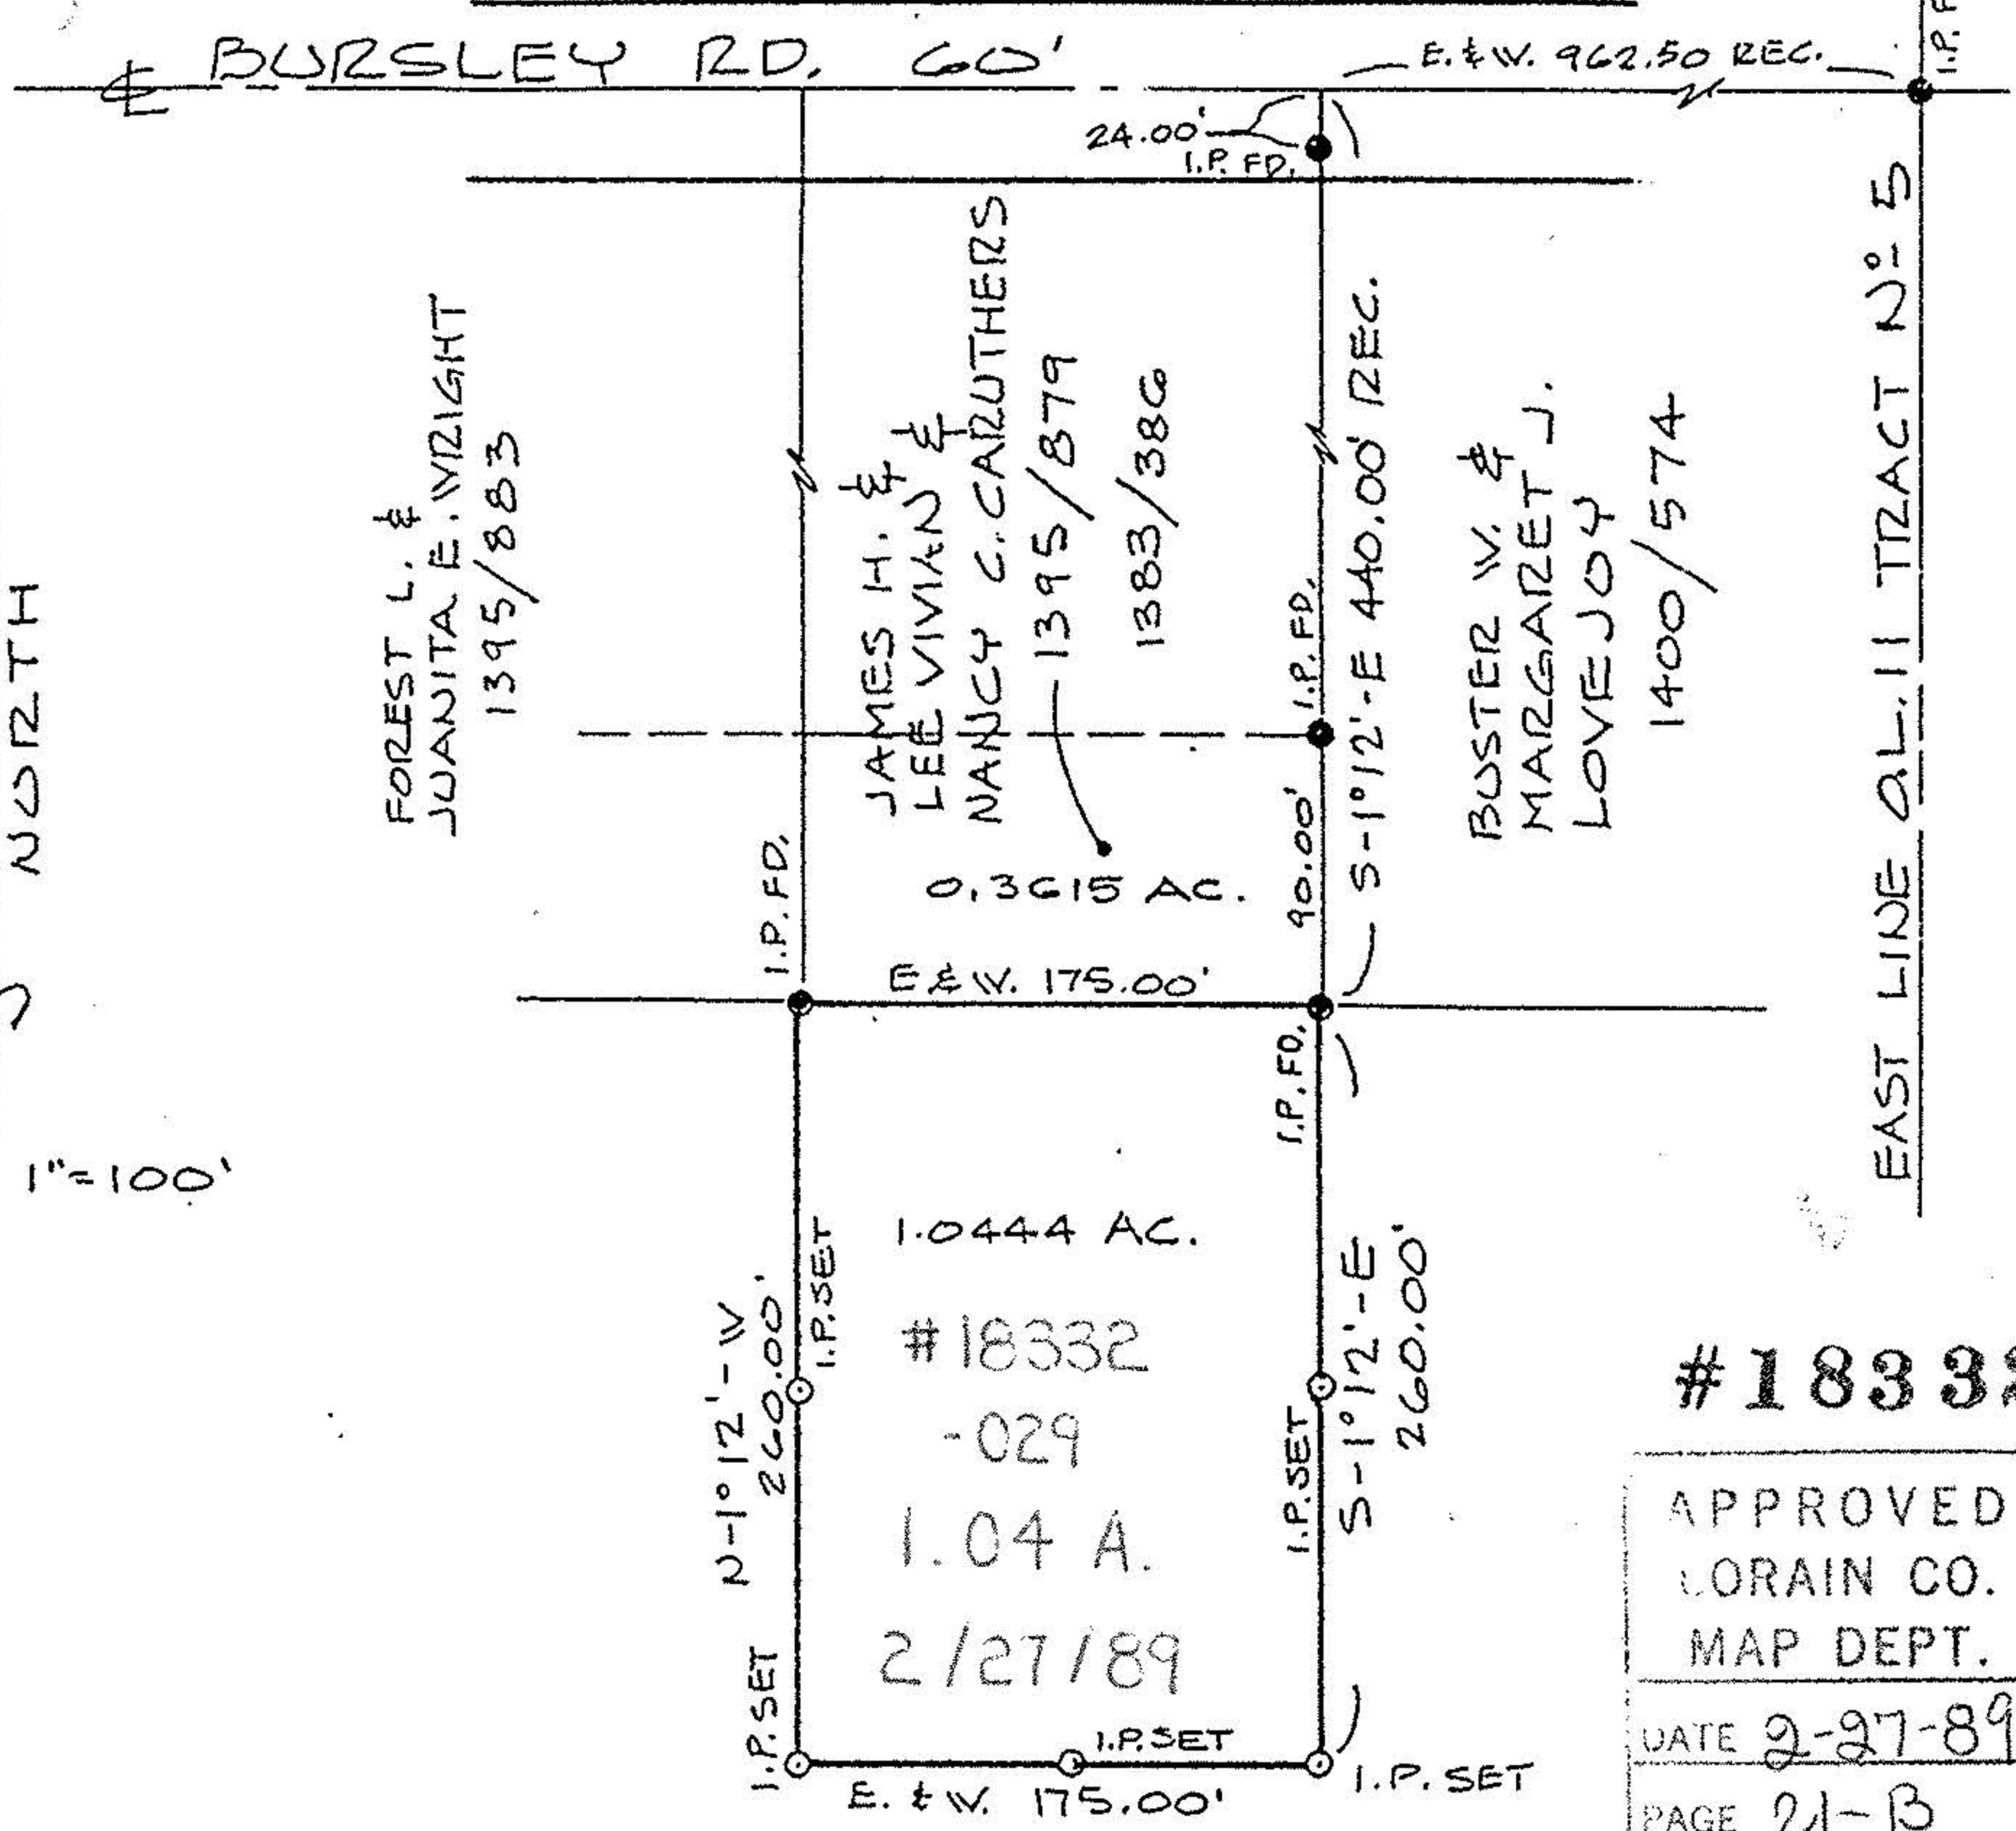

18332

APPROVED
LORAIN CO.
MAP DEPT.

DATE 2-27-89

PAGE 21-13

BY *Ch*

VOID AFTER # 18332



David L. Elwell
REG. SURVEYOR
NO. 6333

447

88-430

