

101

9

# 02477-A -054  
~~15.24 A.~~  
15.36 A.

ACREAGE  
CORRECTION  
PER EDWARD DUDLEY  
NORTH COAST ENG & SURVY  
SEPT. 2000  
PRIOR INST REF OR 1064/746

SEE 6-25  
LAKE  
AVE.

PT. -041  
PT. II.40 A.

-042  
1.83 A.

-043  
2.08 A.

-004  
0.75 A.

-022  
0.67 A.

-033  
0.54 A.

-031  
0.90 A.

PT.-030  
PT. 2.10 A.

APPROVED  
LORAIN CO.  
MAP DEPT.

DATE 10/26/00

PAGE 6-24


BY T-McAin  
100447-A

101

10

101

661.54

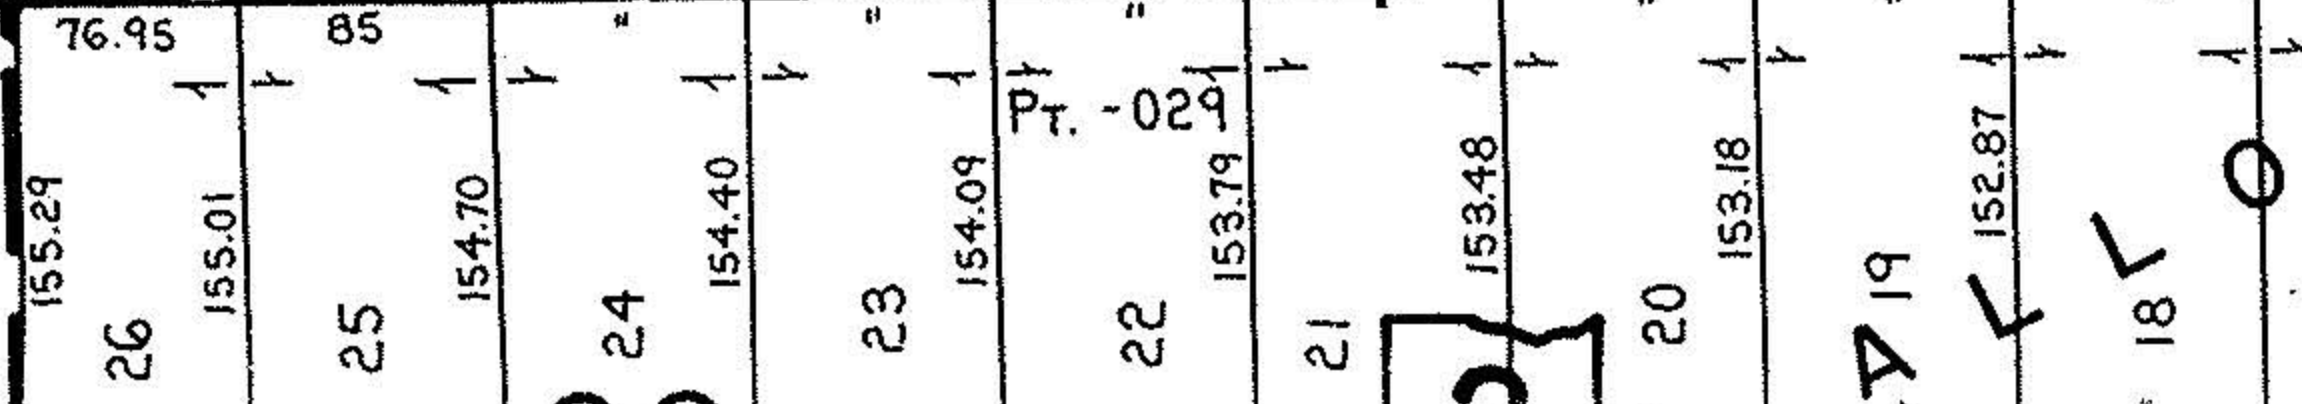

1072